PARENT PARCEL: 04-00-019-101-022
CHILD PARCEL: 04-00-019-640-009, -010
STARTING POINT: INTERSECTION OF C/L OF LAKE RD. AND WEST LINE OF VINEYARD BEACH SUB.

20-04182

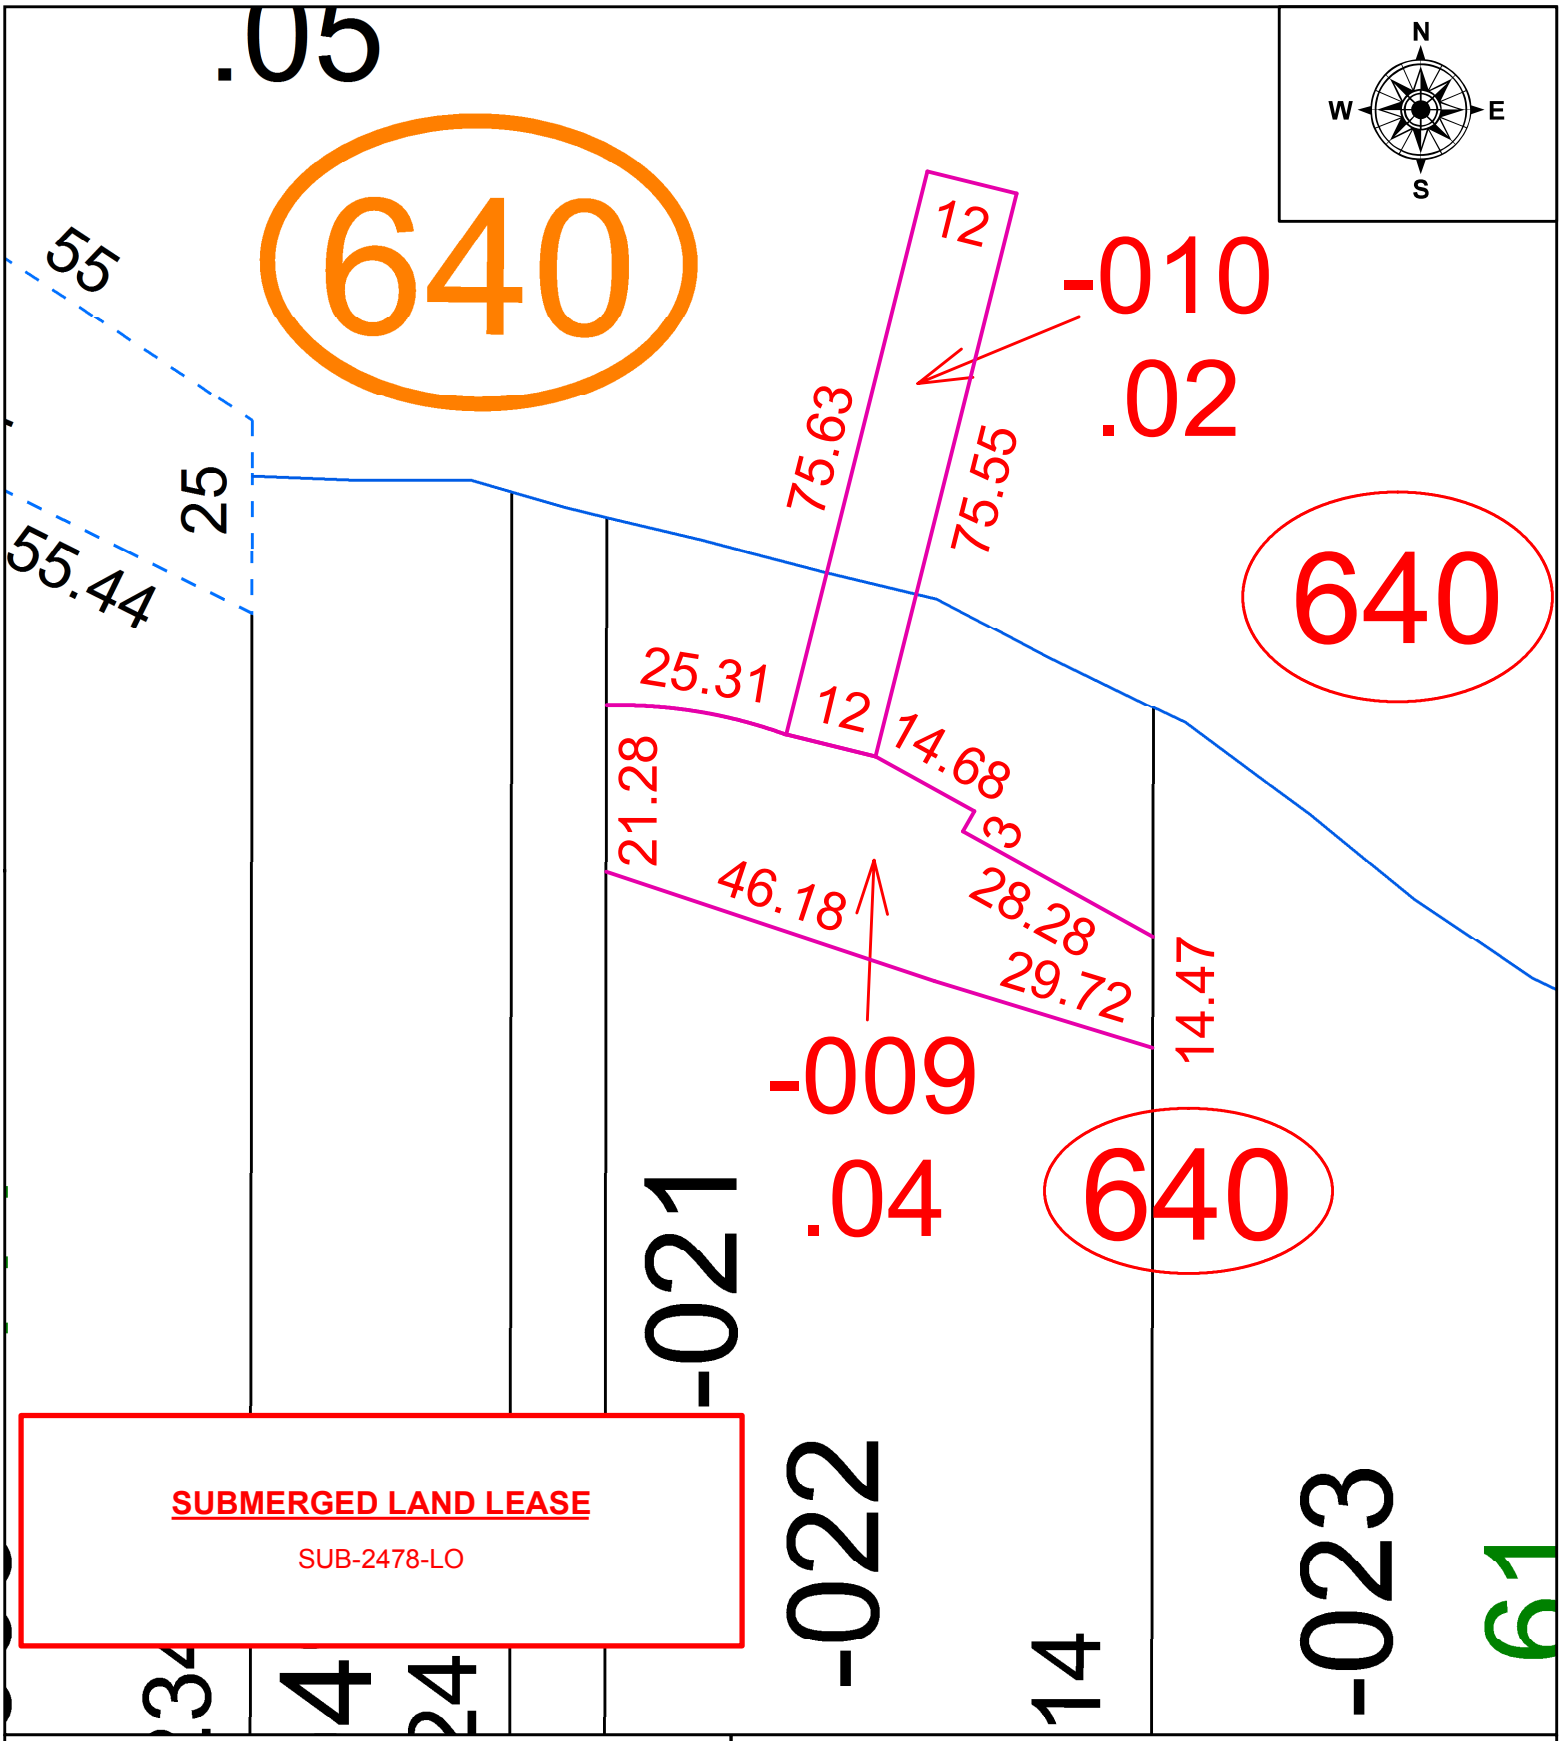

SPLITS/DEEDS PROCESSED
LORAIN COUNTY TAX MAP DEPARTMENT
226 MIDDLE AVE. ELYRIA, OH

SURVEYED BY: THOMAS M. SNEZEK
CLOSURE: 1:57,357
MAP PAGE(S): 4-00-019
APPOVED BY: RRM **DATE:** 9-21-20
SCALE: 1" = 25 **PRIOR INSTRUMENT:** 20160613440