PARENT PARCEL: 09-00-095-106-033

CHILD PARCEL: 09-00-095-106-039, -040

STARTING POINT: INTERSECTION OF C/L OF S. PROFESSOR ST. AND NORTH LINE OF LAND CONVEYED TO FRANK W. TOBIN

19-04185-U

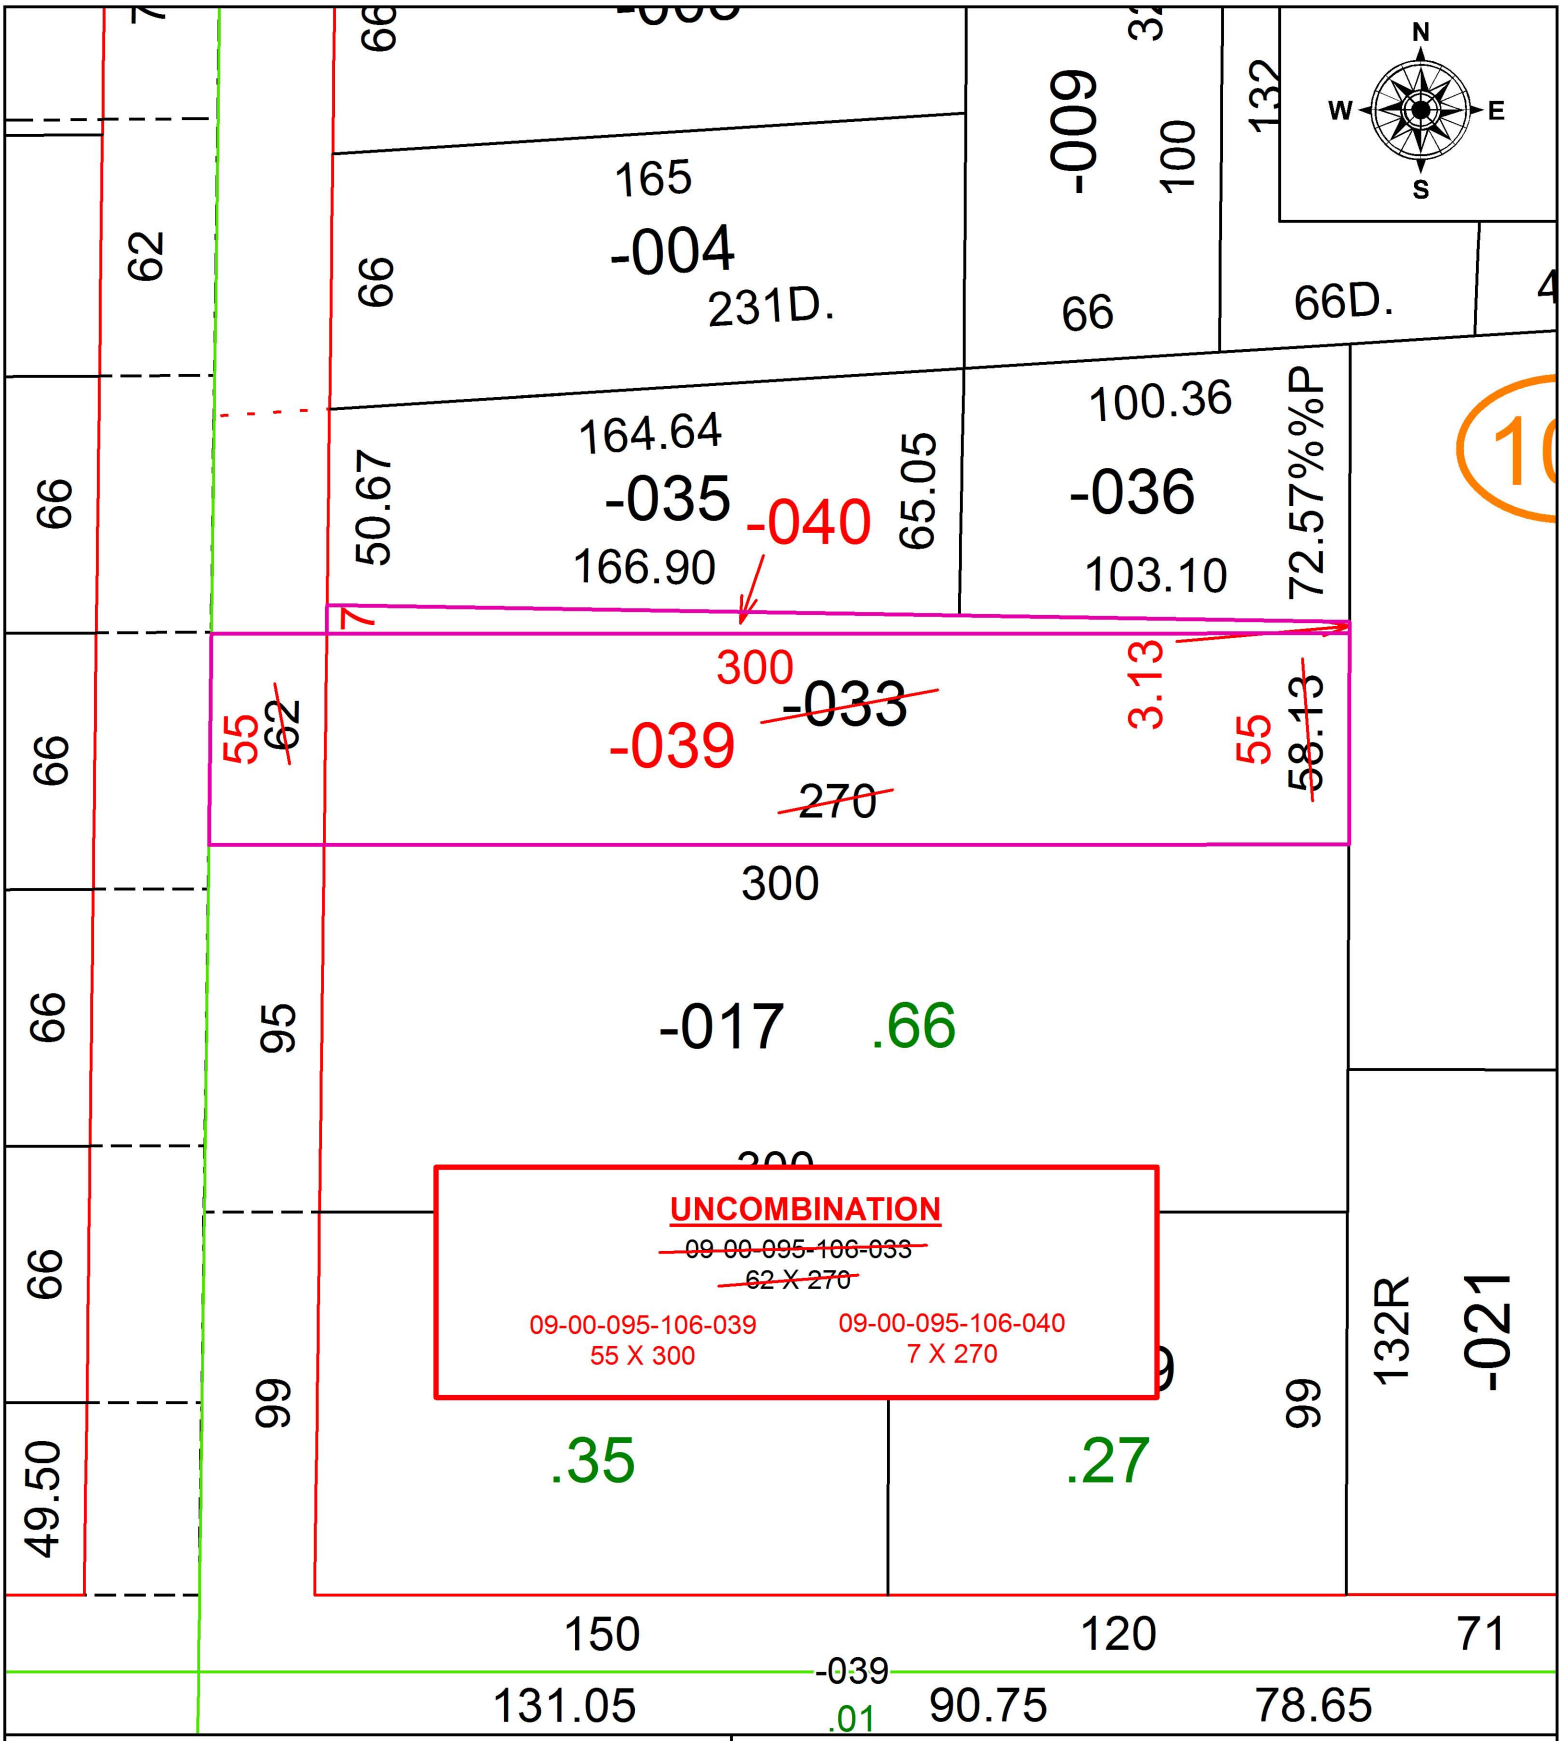

SPLITS/DEEDS PROCESSED

LORAIN COUNTY TAX MAP DEPARTMENT
226 MIDDLE AVE. ELYRIA, OH

SURVEYED BY: N/A
CLOSURE: N/A
MAP PAGE(S): 9-00-095
APPOVED BY: RRM **DATE:** 9-9-19
SCALE: 1" = 50 **PRIOR INSTRUMENT:** 20180687414