PARENT PARCEL: 10-00-003-115-022

CHILD PARCEL:

STARTING POINT: SOUTHEAST CORNER OF S/L 5 IN HOMESITE COURT ALLOTMENT

19-04186-D

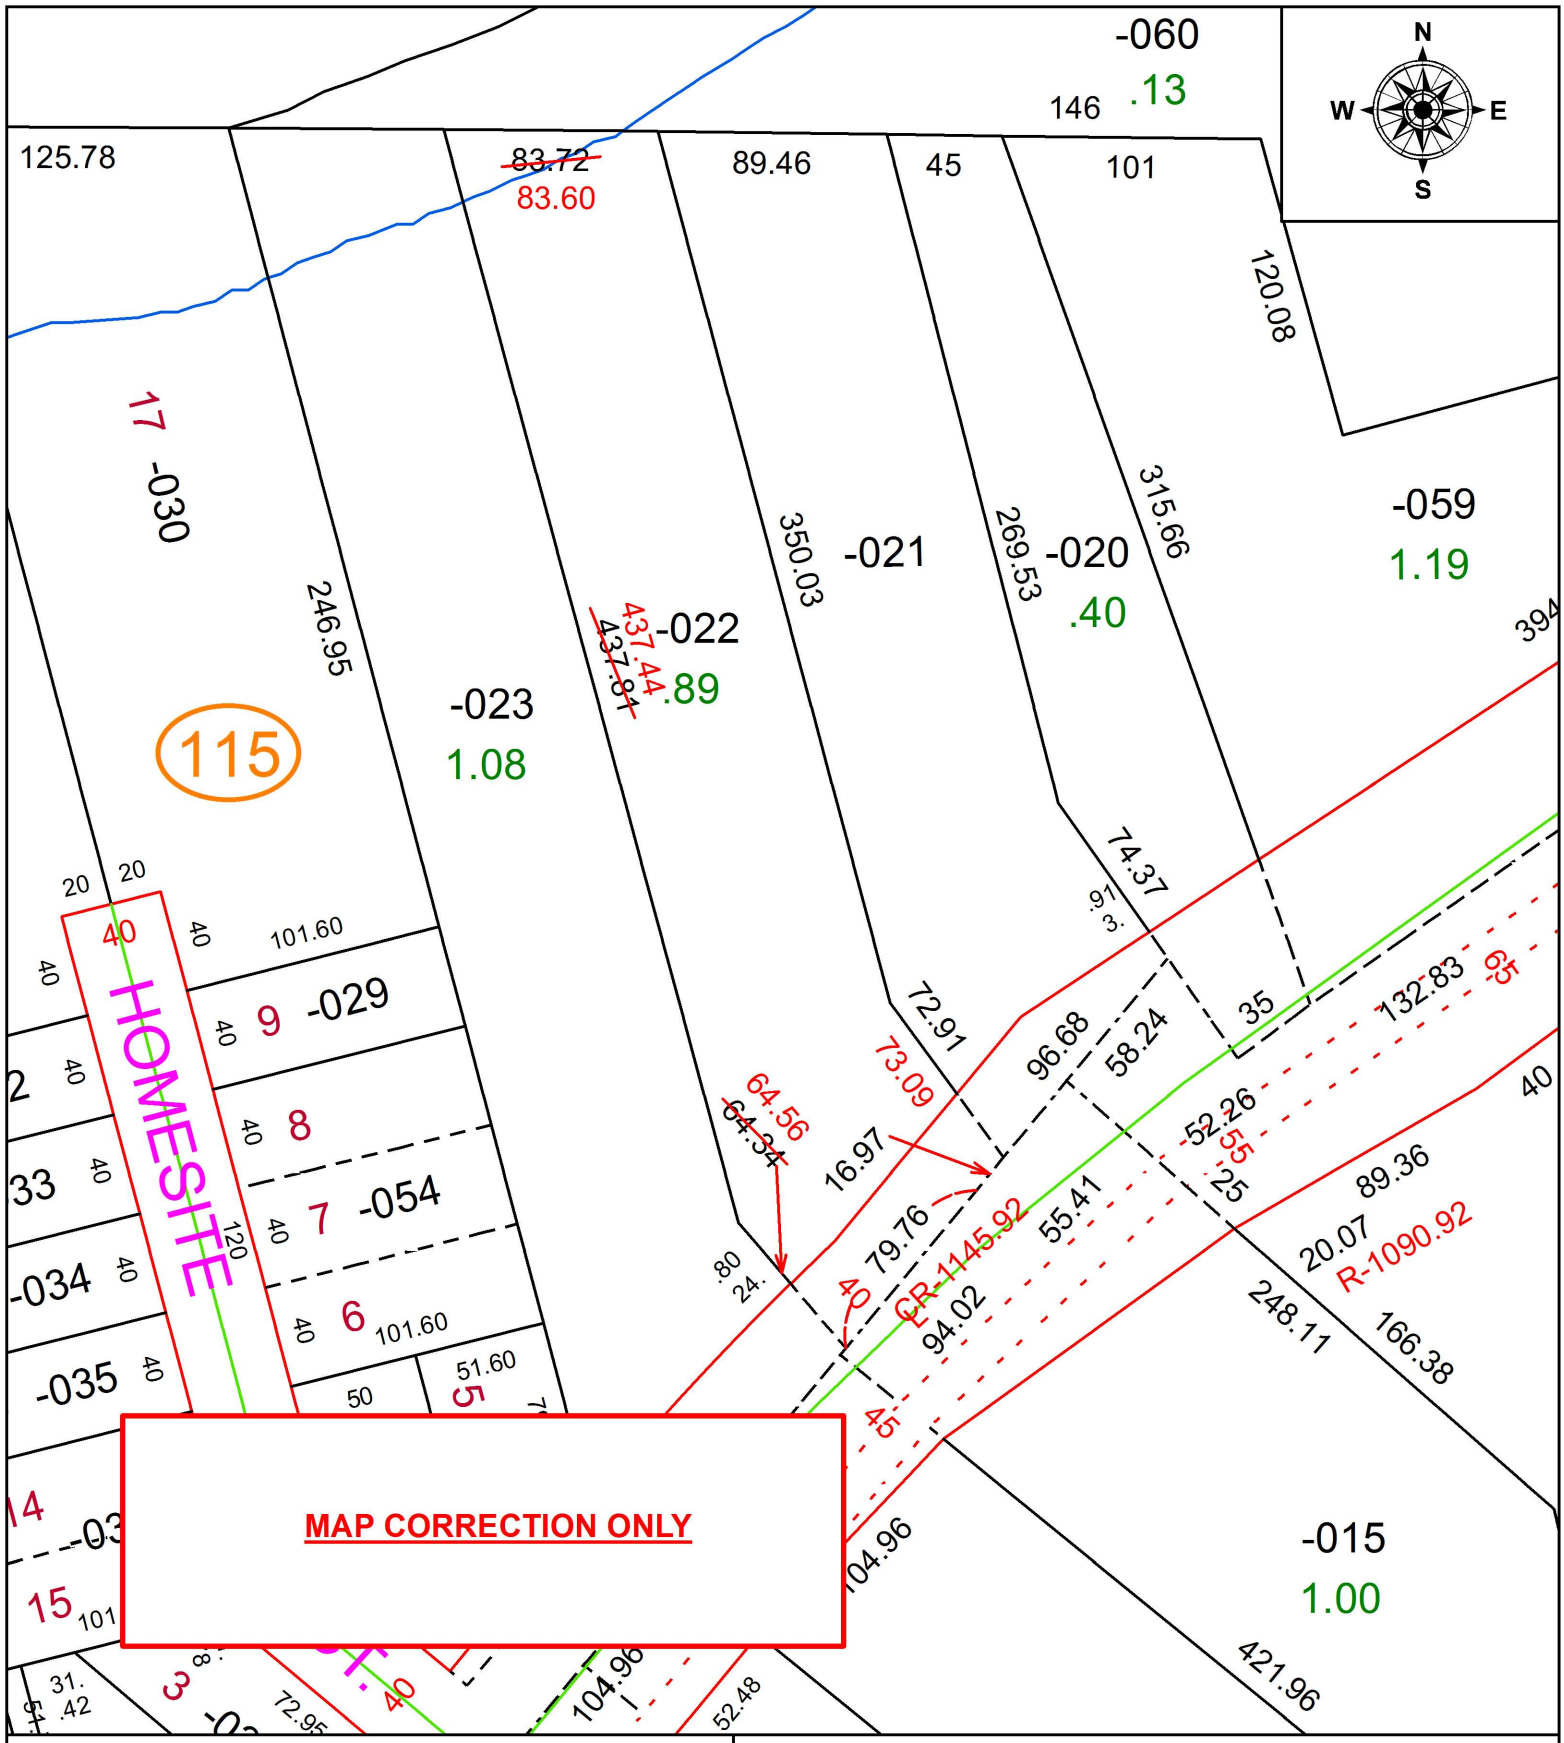

SPLITS/DEEDS PROCESSED

LORAIN COUNTY TAX MAP DEPARTMENT
226 MIDDLE AVE. ELYRIA, OH

SURVEYED BY: JAMES P. YURKSCHATT
CLOSURE: 1:294,658
MAP PAGE(S): 10-00-003
APPOVED BY: RRM **DATE:** 9-11-19
SCALE: 1" = 75 **PRIOR INSTRUMENT:** 20160595250