PARENT PARCEL: 03-00-097-101-032, 03-00-098-112-006

CHILD PARCEL: 03-00-097-101-034, -035, 03-00-098-112-006

STARTING POINT: INTERSECTION OF SOUTH LINE OF E. 28TH ST, AND WEST LINE OF FULTON RD.

20-04188

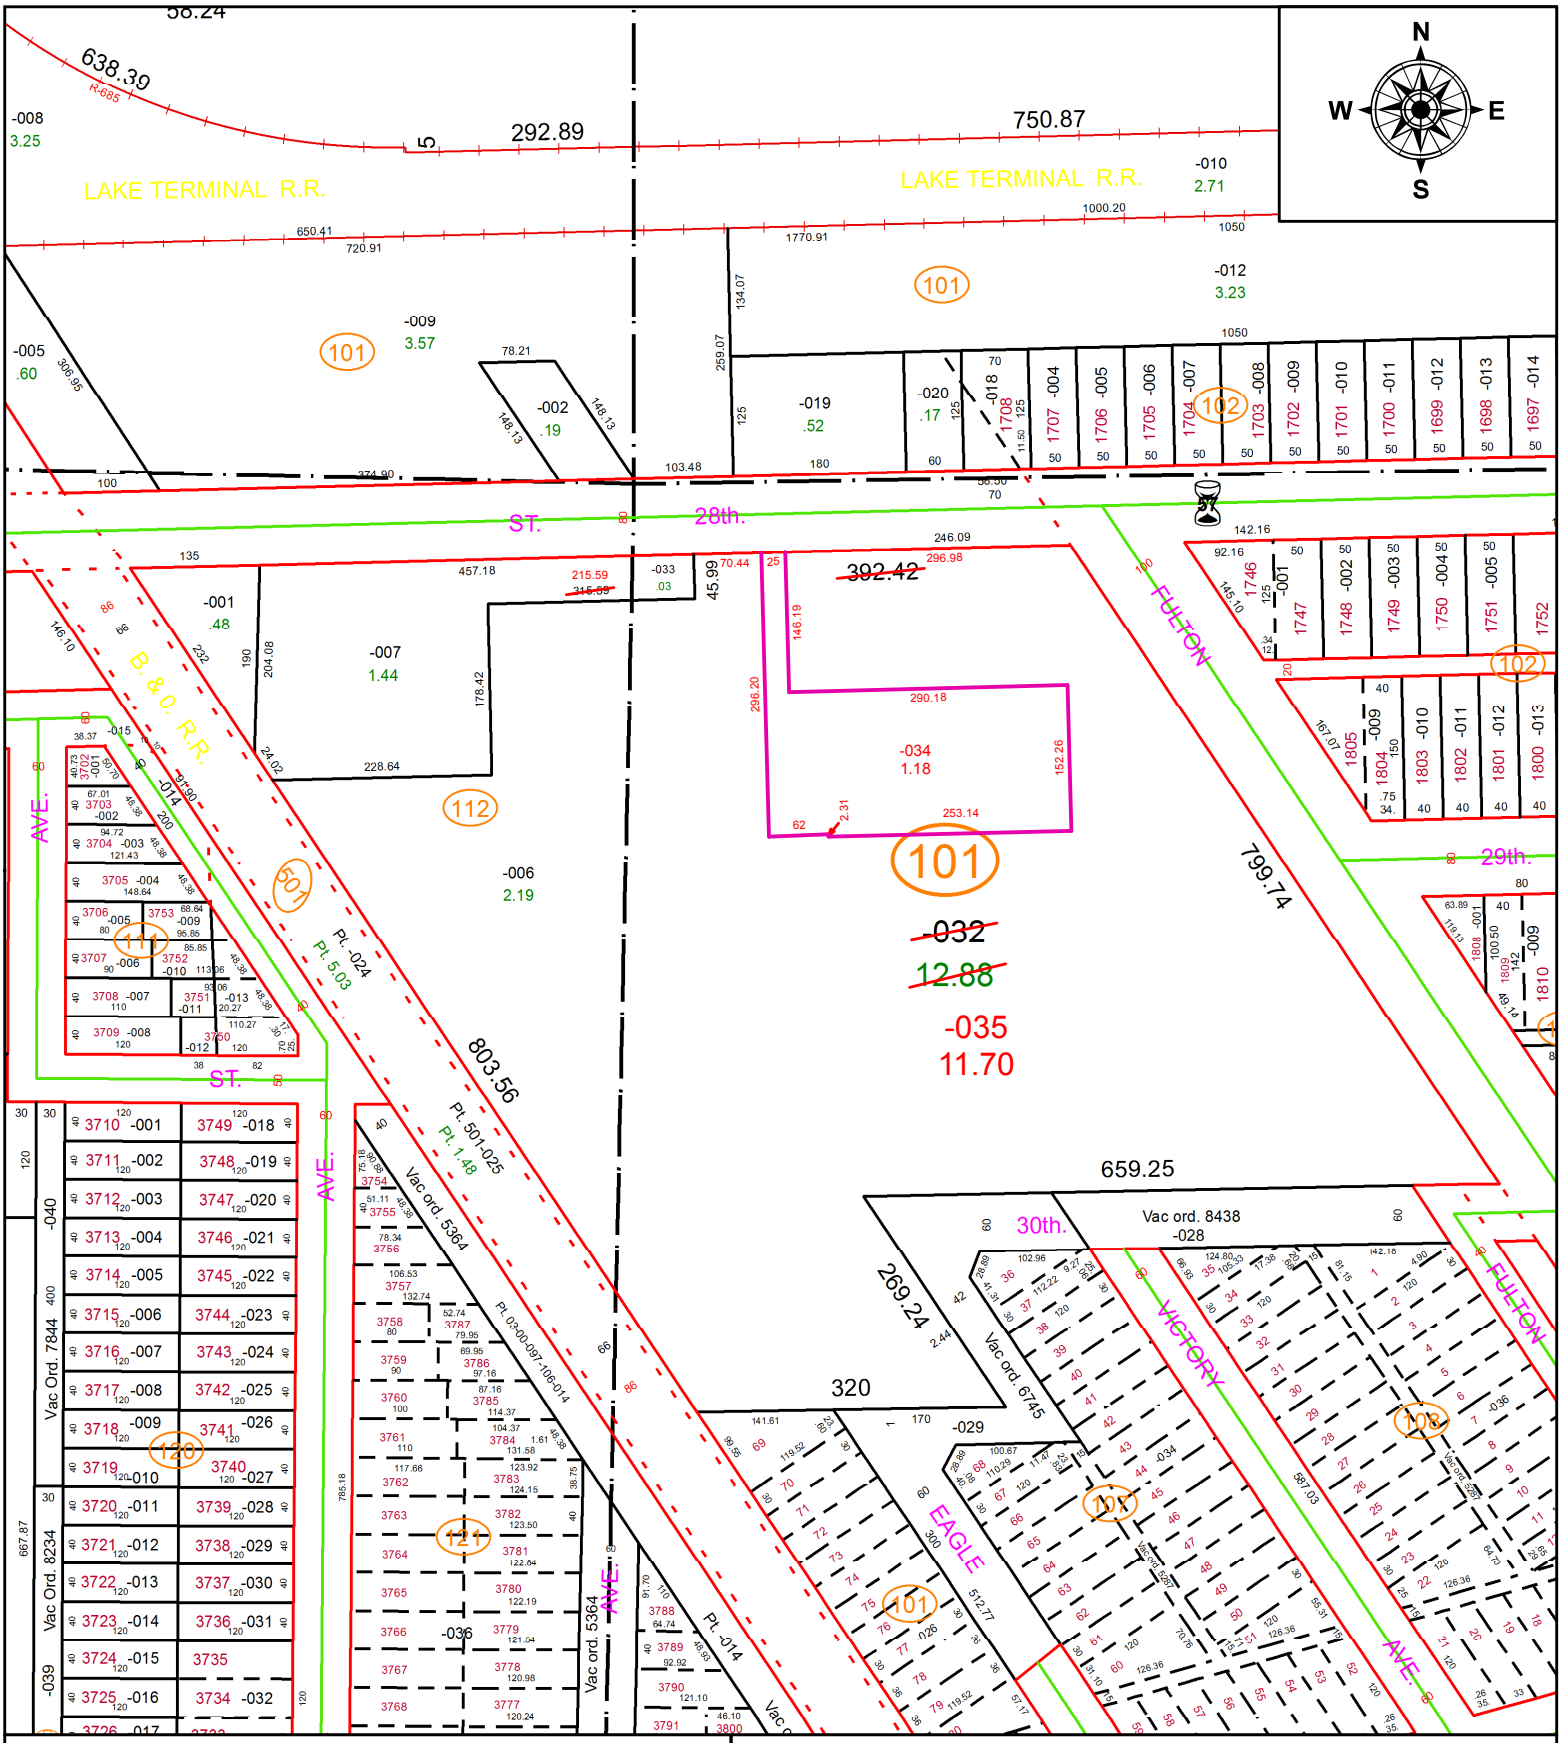

SPLITS/DEEDS PROCESSED

LORAIN COUNTY TAX MAP DEPARTMENT
226 MIDDLE AVE. ELYRIA, OH

SURVEYED BY: PATRICK A. MCGANNON
CLOSURE: 1:155,786
MAP PAGE(S): 3-00-097
APPOVED BY: RRM **DATE:** 10-9-20
SCALE: 1" = 200 **PRIOR INSTRUMENT:** 20170636421