PARENT PARCEL: 16-00-067-000-015
CHILD PARCEL: 16-00-067-000-016, -017
STARTING POINT: NORTHEAST CORNER OF O.L.67

20-04189

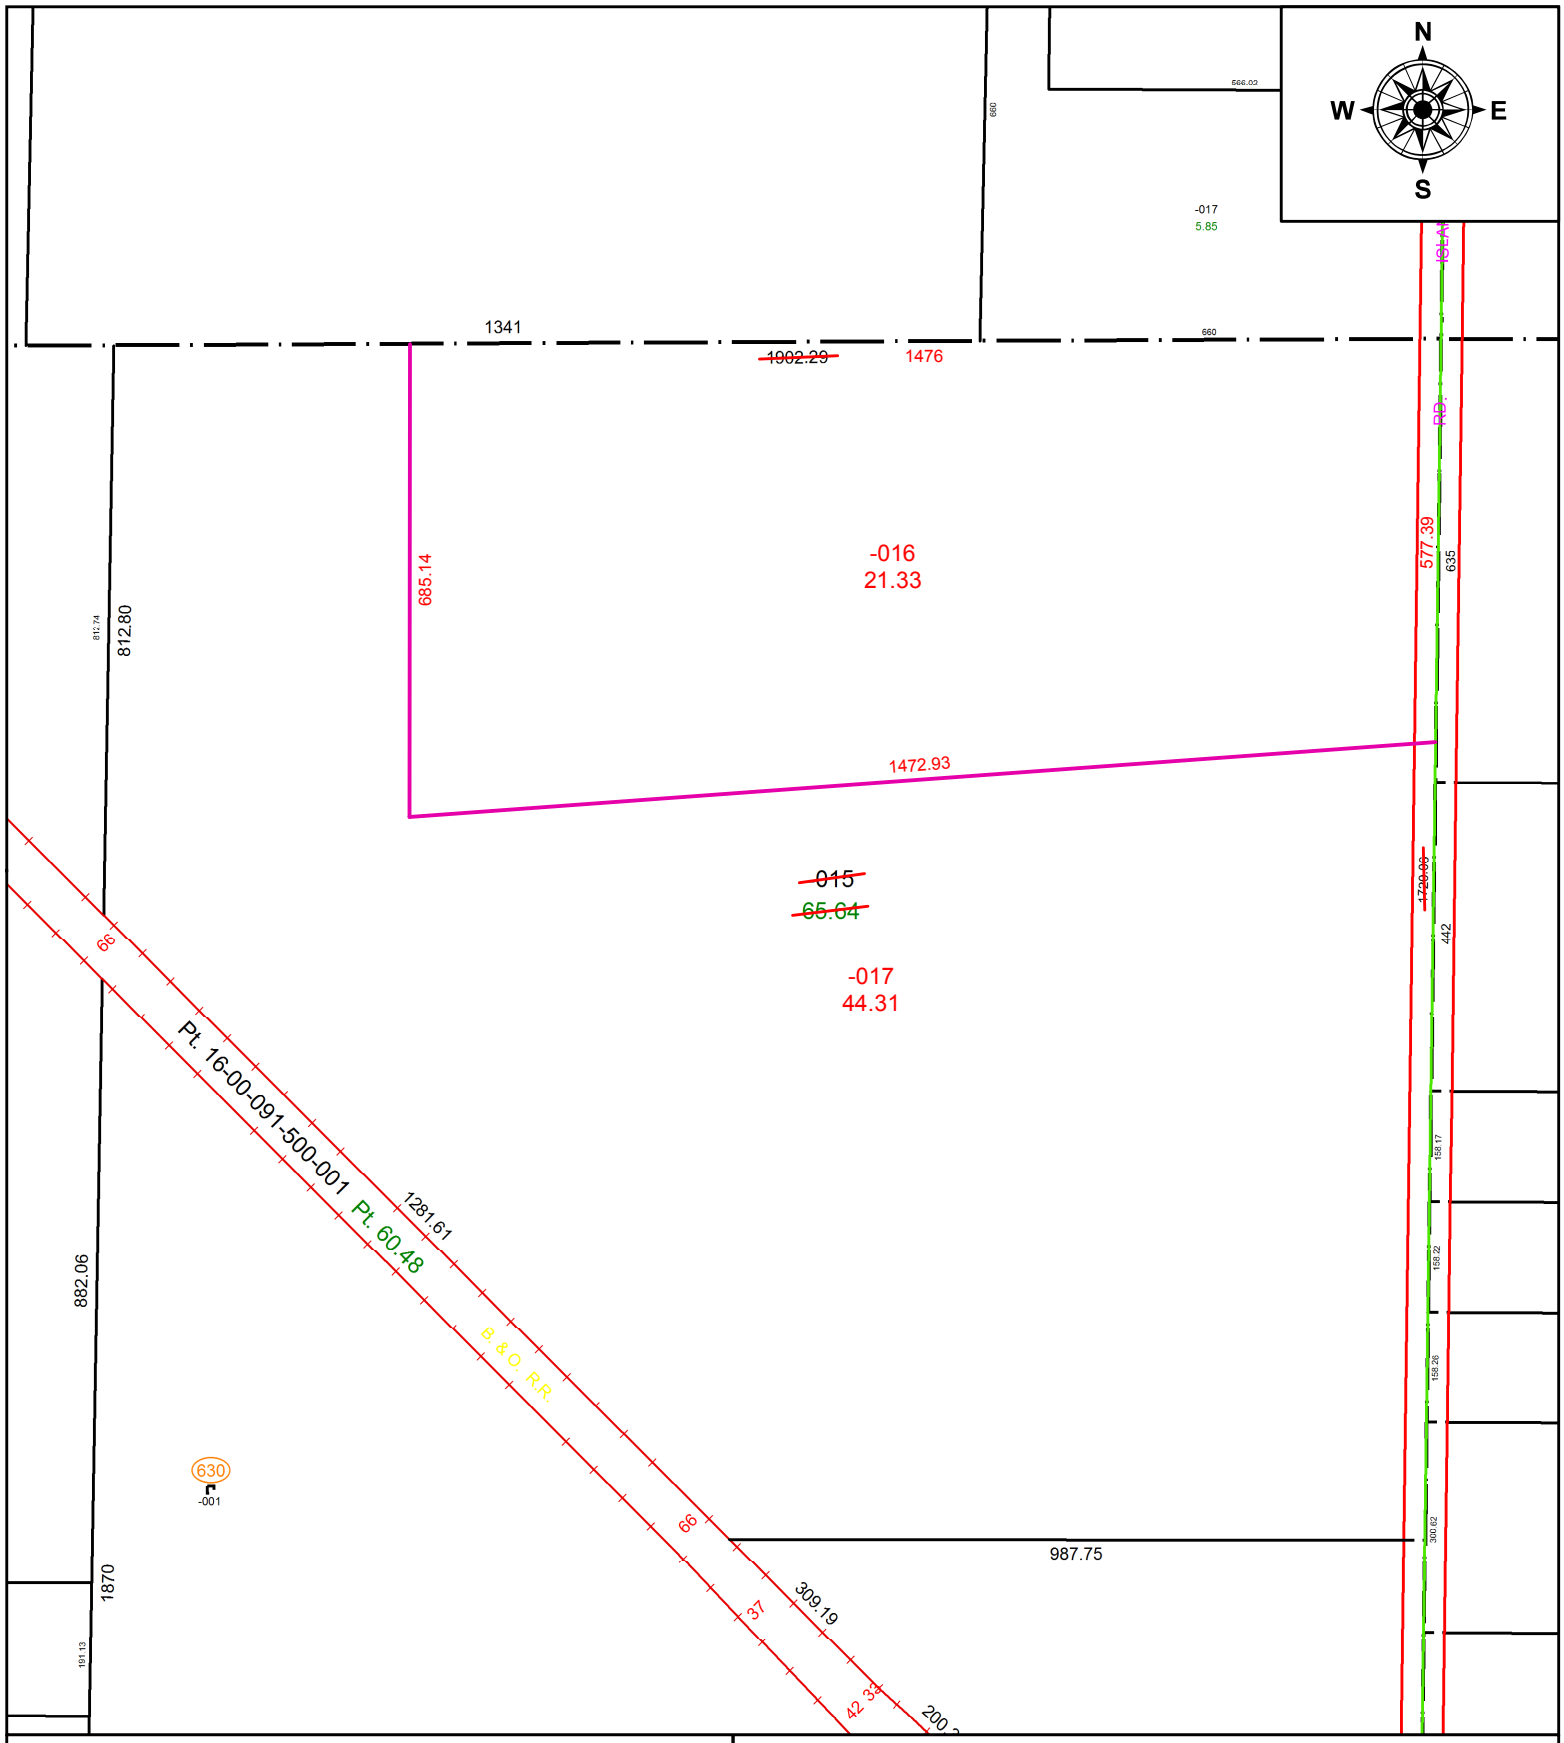

SPLITS/DEEDS PROCESSED

LORAIN COUNTY TAX MAP DEPARTMENT
226 MIDDLE AVE. ELYRIA, OH

SURVEYED BY: TIMOTHY D. HOZALSKI
CLOSURE: 1:642,187
MAP PAGE(S): 16-00-067
APPOVED BY: RRM **DATE:** 10-14-20
SCALE: 1" = 275 **PRIOR INSTRUMENT:** 20190726650