PARENT PARCEL: 05-00-059-103-032

CHILD PARCEL: 05-00-059-103-033, -034

STARTING POINT: SOUTHEAST CORNER OF S/L 1 IN NORTH RIDGE ALLOTMENT

20-04190

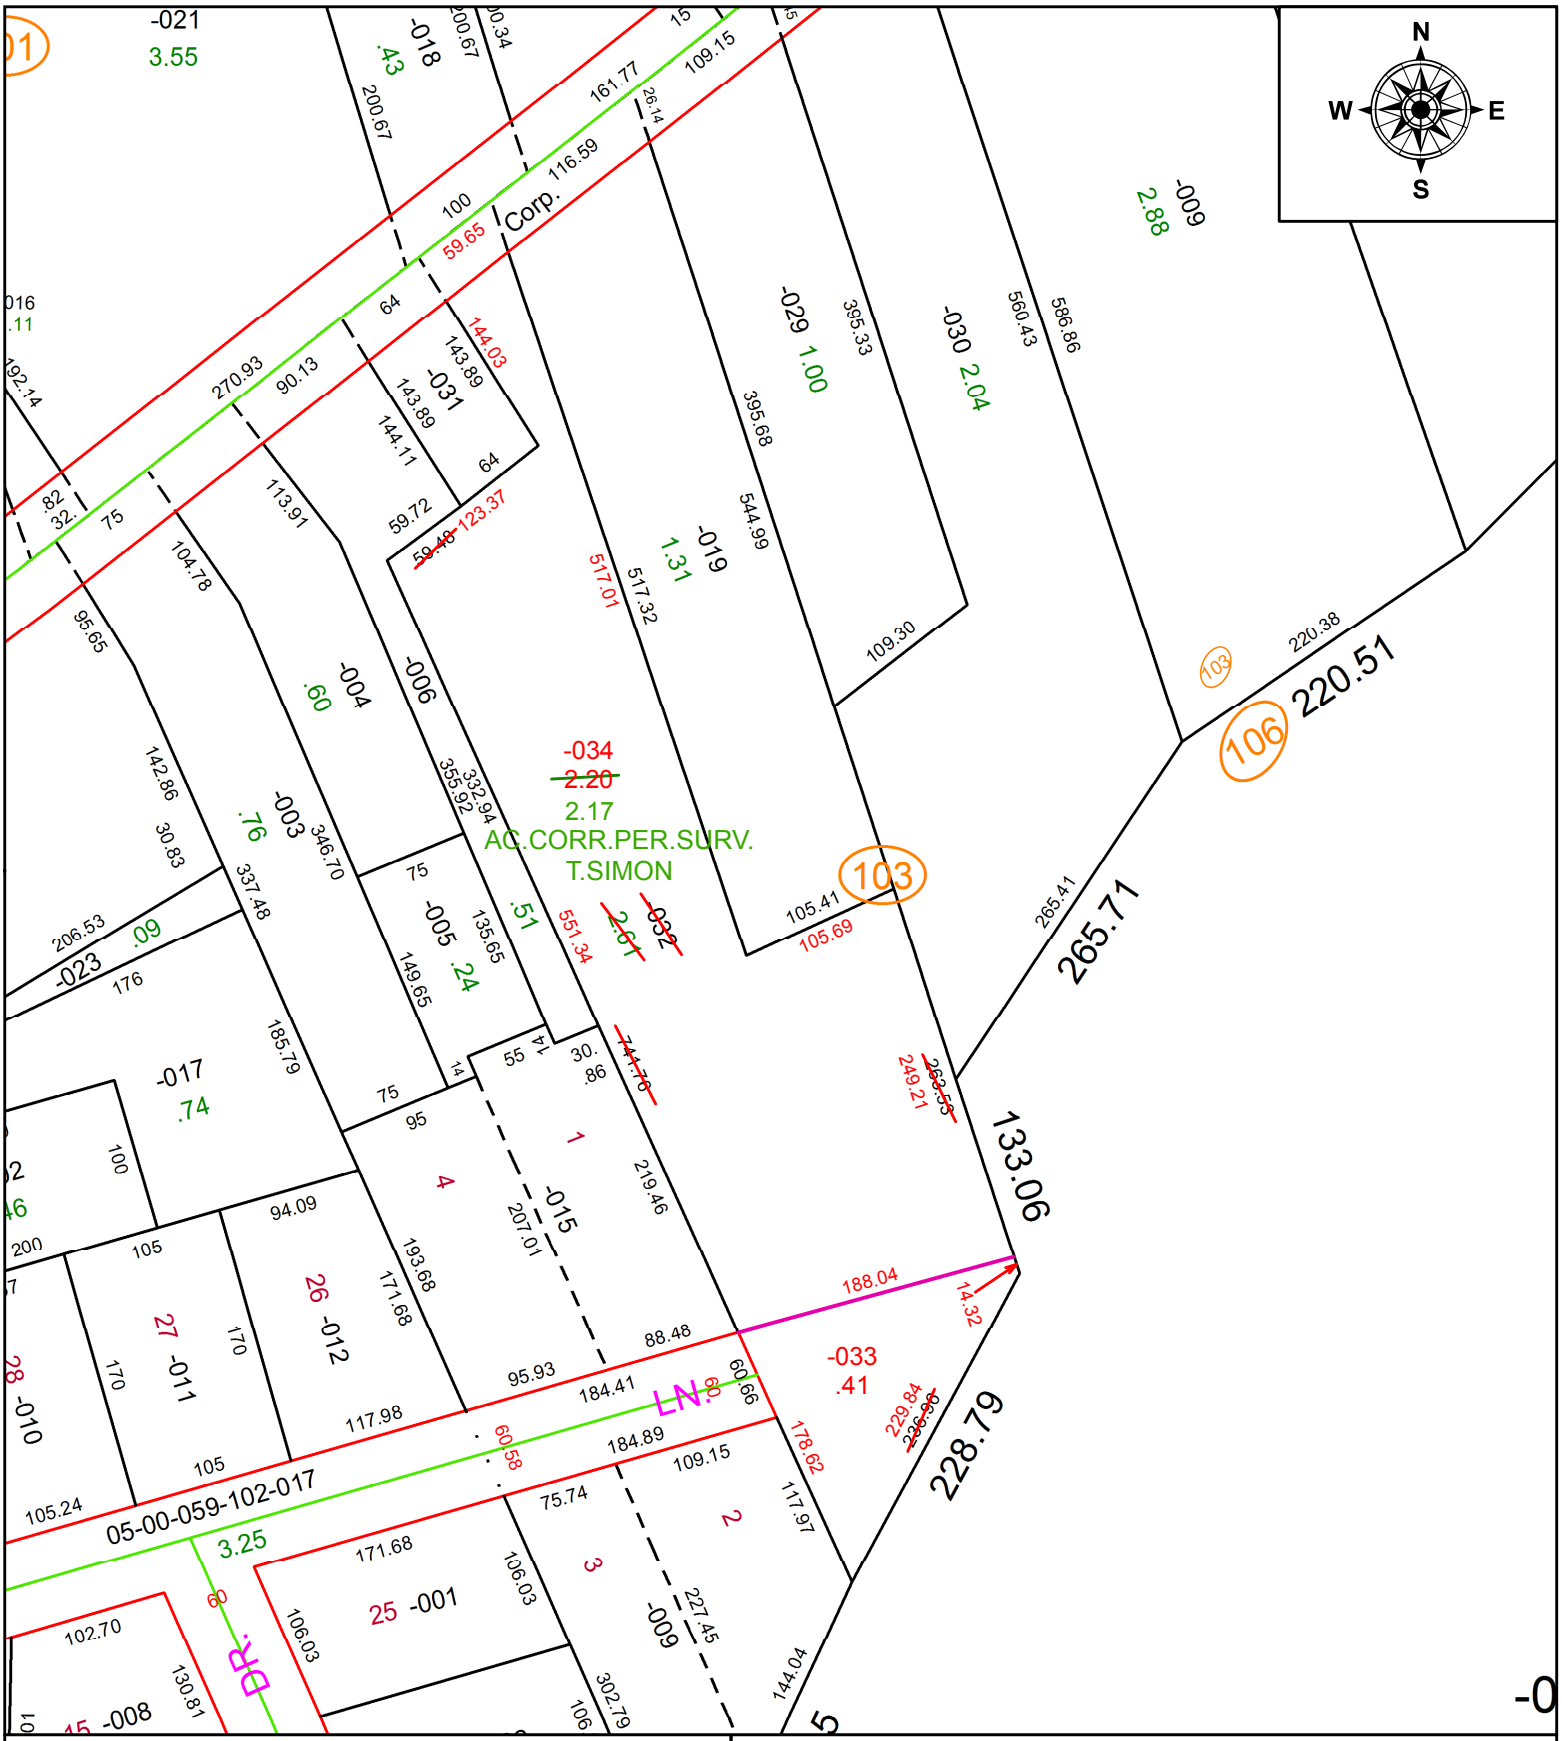

SPLITS/DEEDS PROCESSED

LORAIN COUNTY TAX MAP DEPARTMENT
226 MIDDLE AVE. ELYRIA, OH

SURVEYED BY: THOMAS A, SIMON
CLOSURE: 1:136,735
MAP PAGE(S): 5-00-059
APPOVED BY: RRM **DATE:** 10-14-20
SCALE: 1" = 125 **PRIOR INSTRUMENT:** 20150559185