PARENT PARCEL: 18-00-022-109-003
CHILD PARCEL:
STARTING POINT: NORTHWEST CORNER OF LAND CONVEYED TO R.G. & PEARL CLINESMITH

19-04191-C

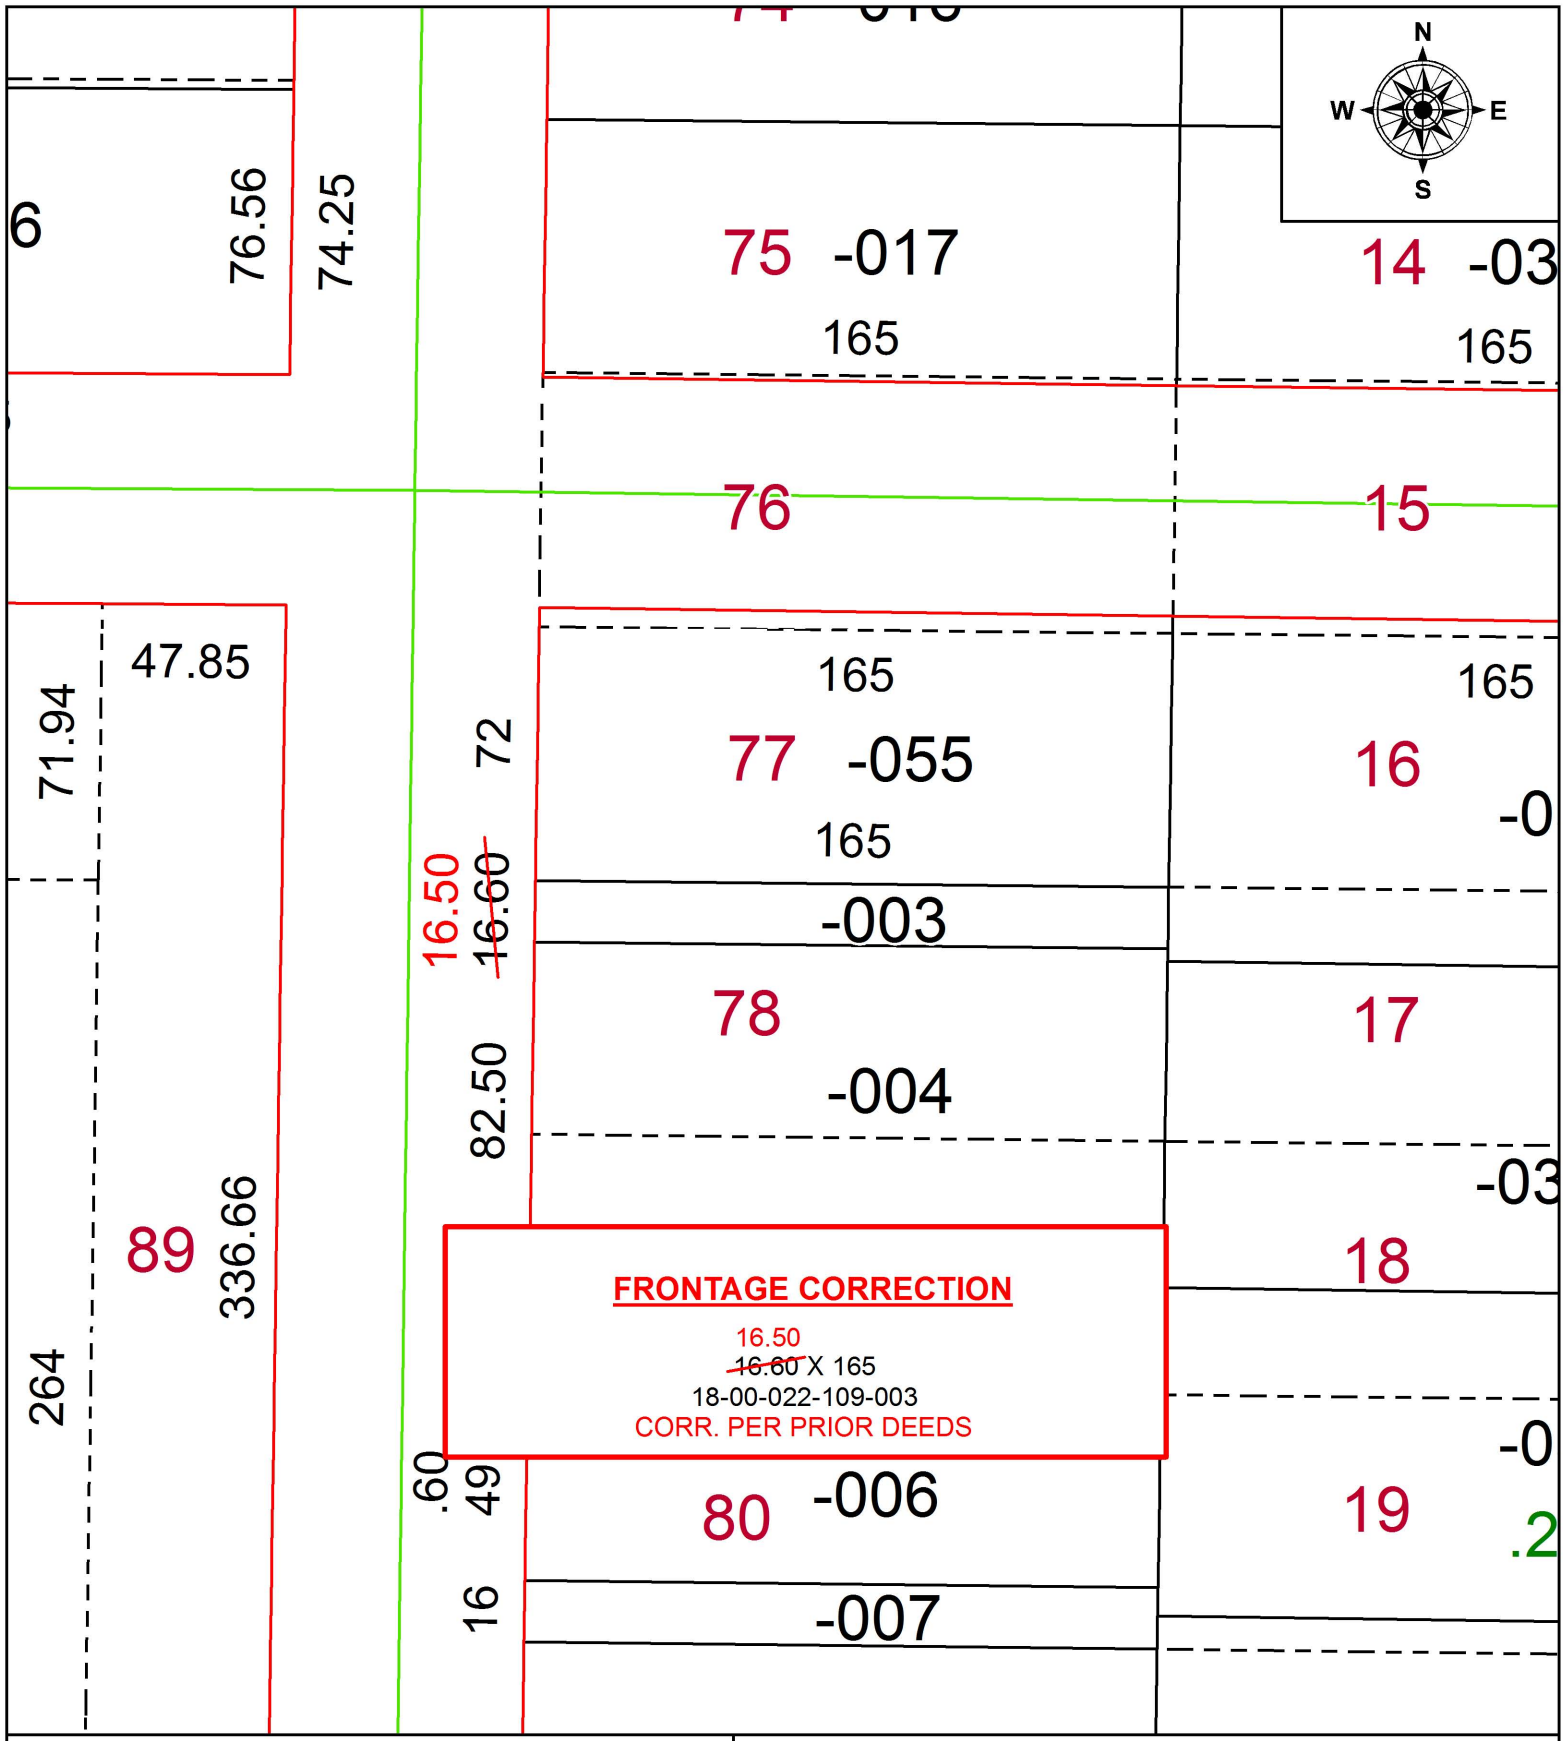

SPLITS/DEEDS PROCESSED
LORAIN COUNTY TAX MAP DEPARTMENT
226 MIDDLE AVE. ELYRIA, OH

SURVEYED BY: N/A
CLOSURE: N/A
MAP PAGE(S): 18-00-022
APPOVED BY: RRM **DATE:** 9-19-19
SCALE: 1" = 50 **PRIOR INSTRUMENT:** 20040023324