PARENT PARCEL: 11-00-078-000-042

CHILD PARCEL: 11-00-078-000-045, -046

STARTING POINT: INTERSECTION OF C/L OF CAPEL RD. AND C/L OF DURKEE RD.

20-04191

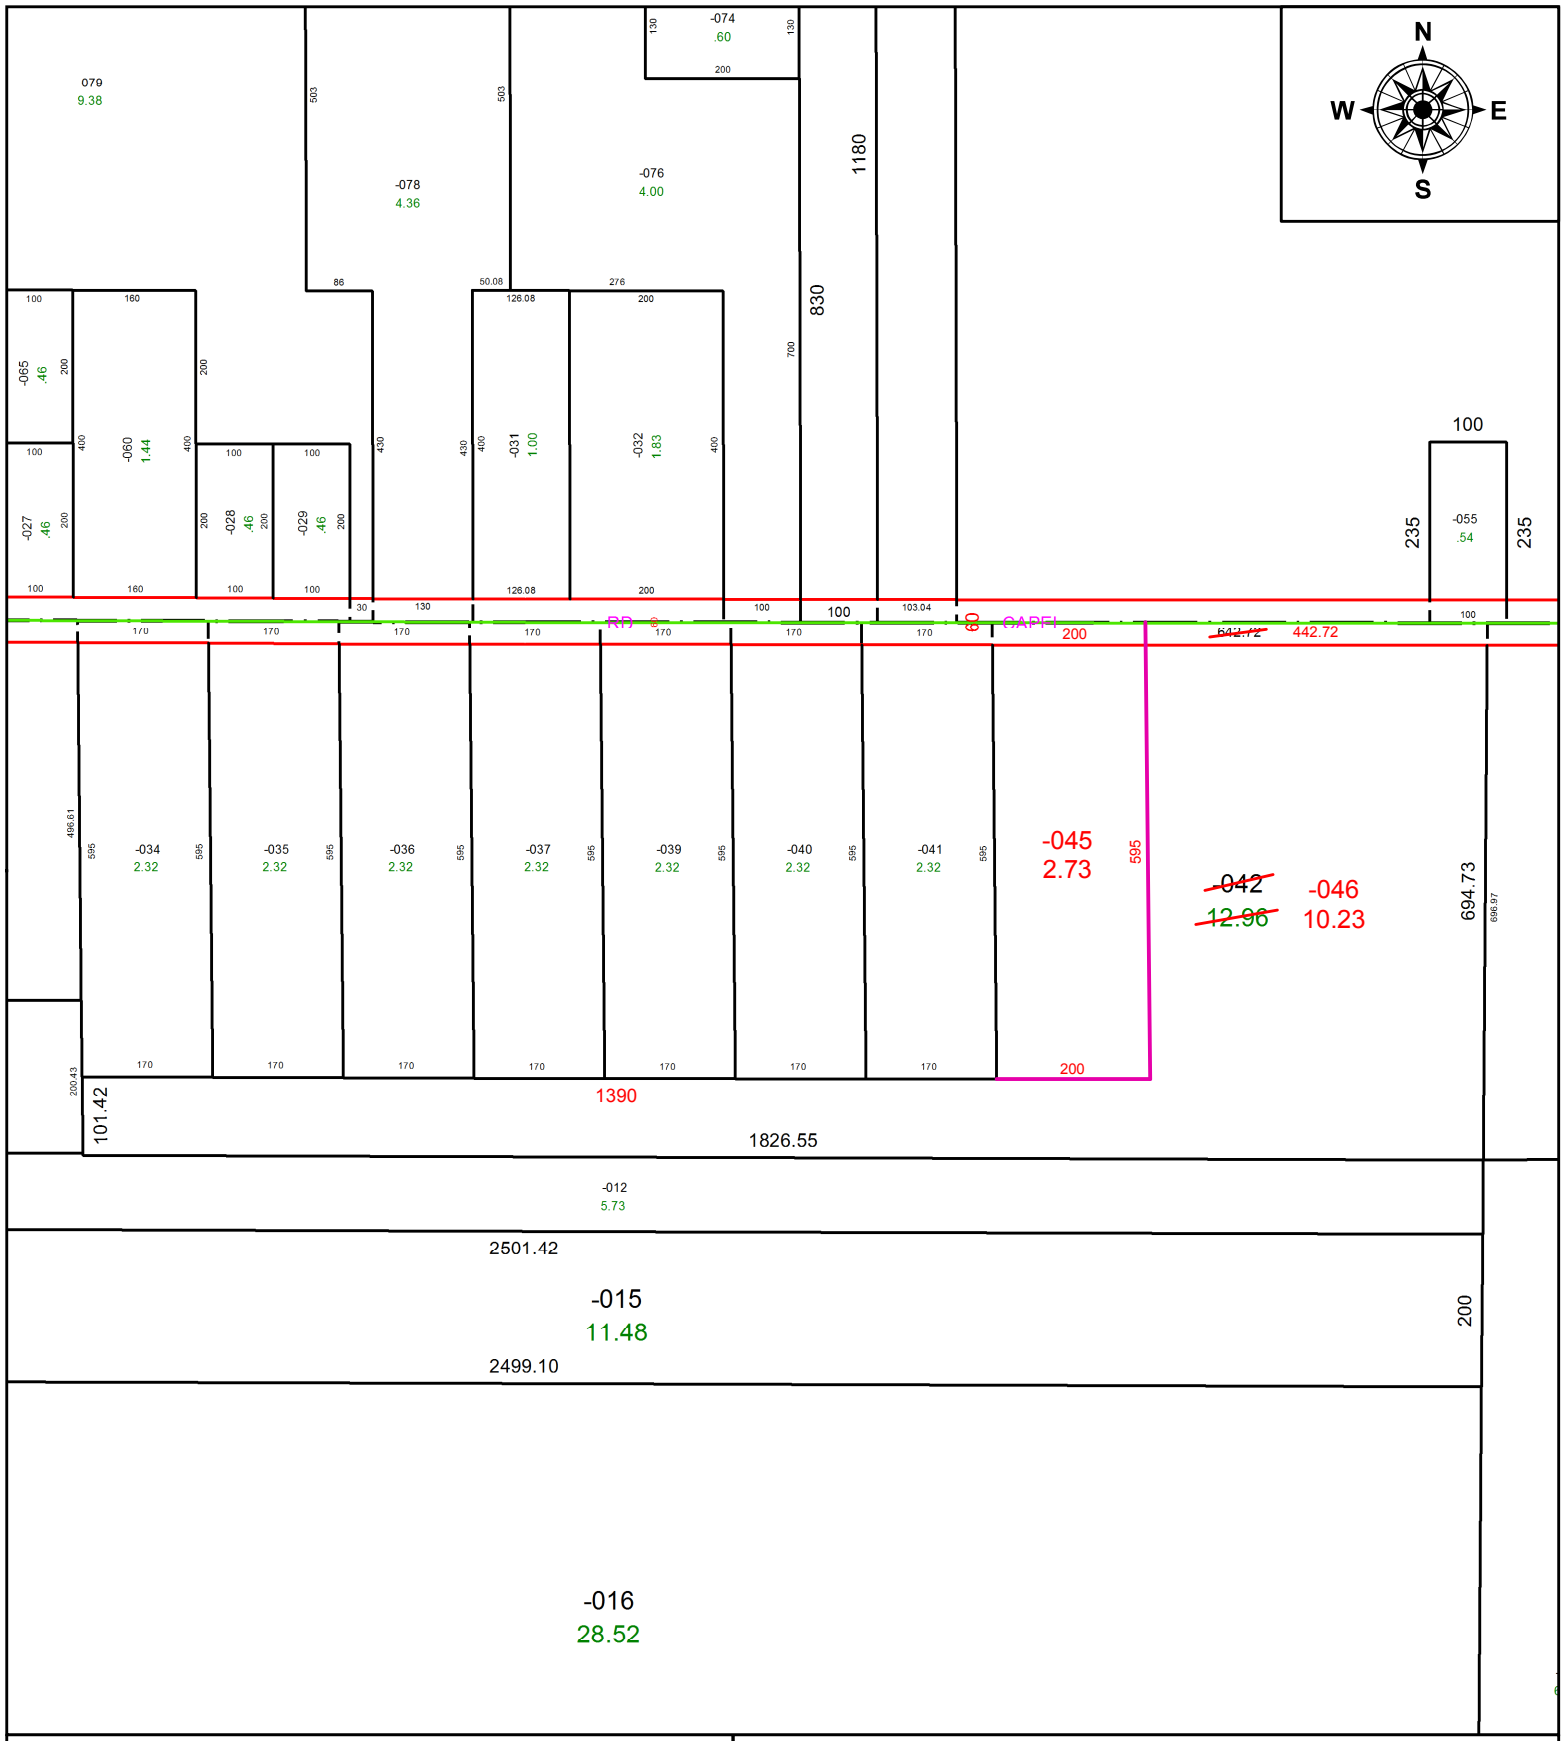

SPLITS/DEEDS PROCESSED

LORAIN COUNTY TAX MAP DEPARTMENT
226 MIDDLE AVE. ELYRIA, OH

SURVEYED BY: THOMAS A. SIMON
CLOSURE: 1:765,983
MAP PAGE(S): 11-00-078
APPOVED BY: RRM **DATE:** 10-14-20
SCALE: 1" = 250 **PRIOR INSTRUMENT:** 20100338939