PARENT PARCEL: 03-00-111-103-003, 03-00-112-103-005

CHILD PARCEL:

STARTING POINT: INTERSECTION OF C/L OF ELYRIA AVE. AND C/L OF NORTH RIDGE RD.

19-04196-C

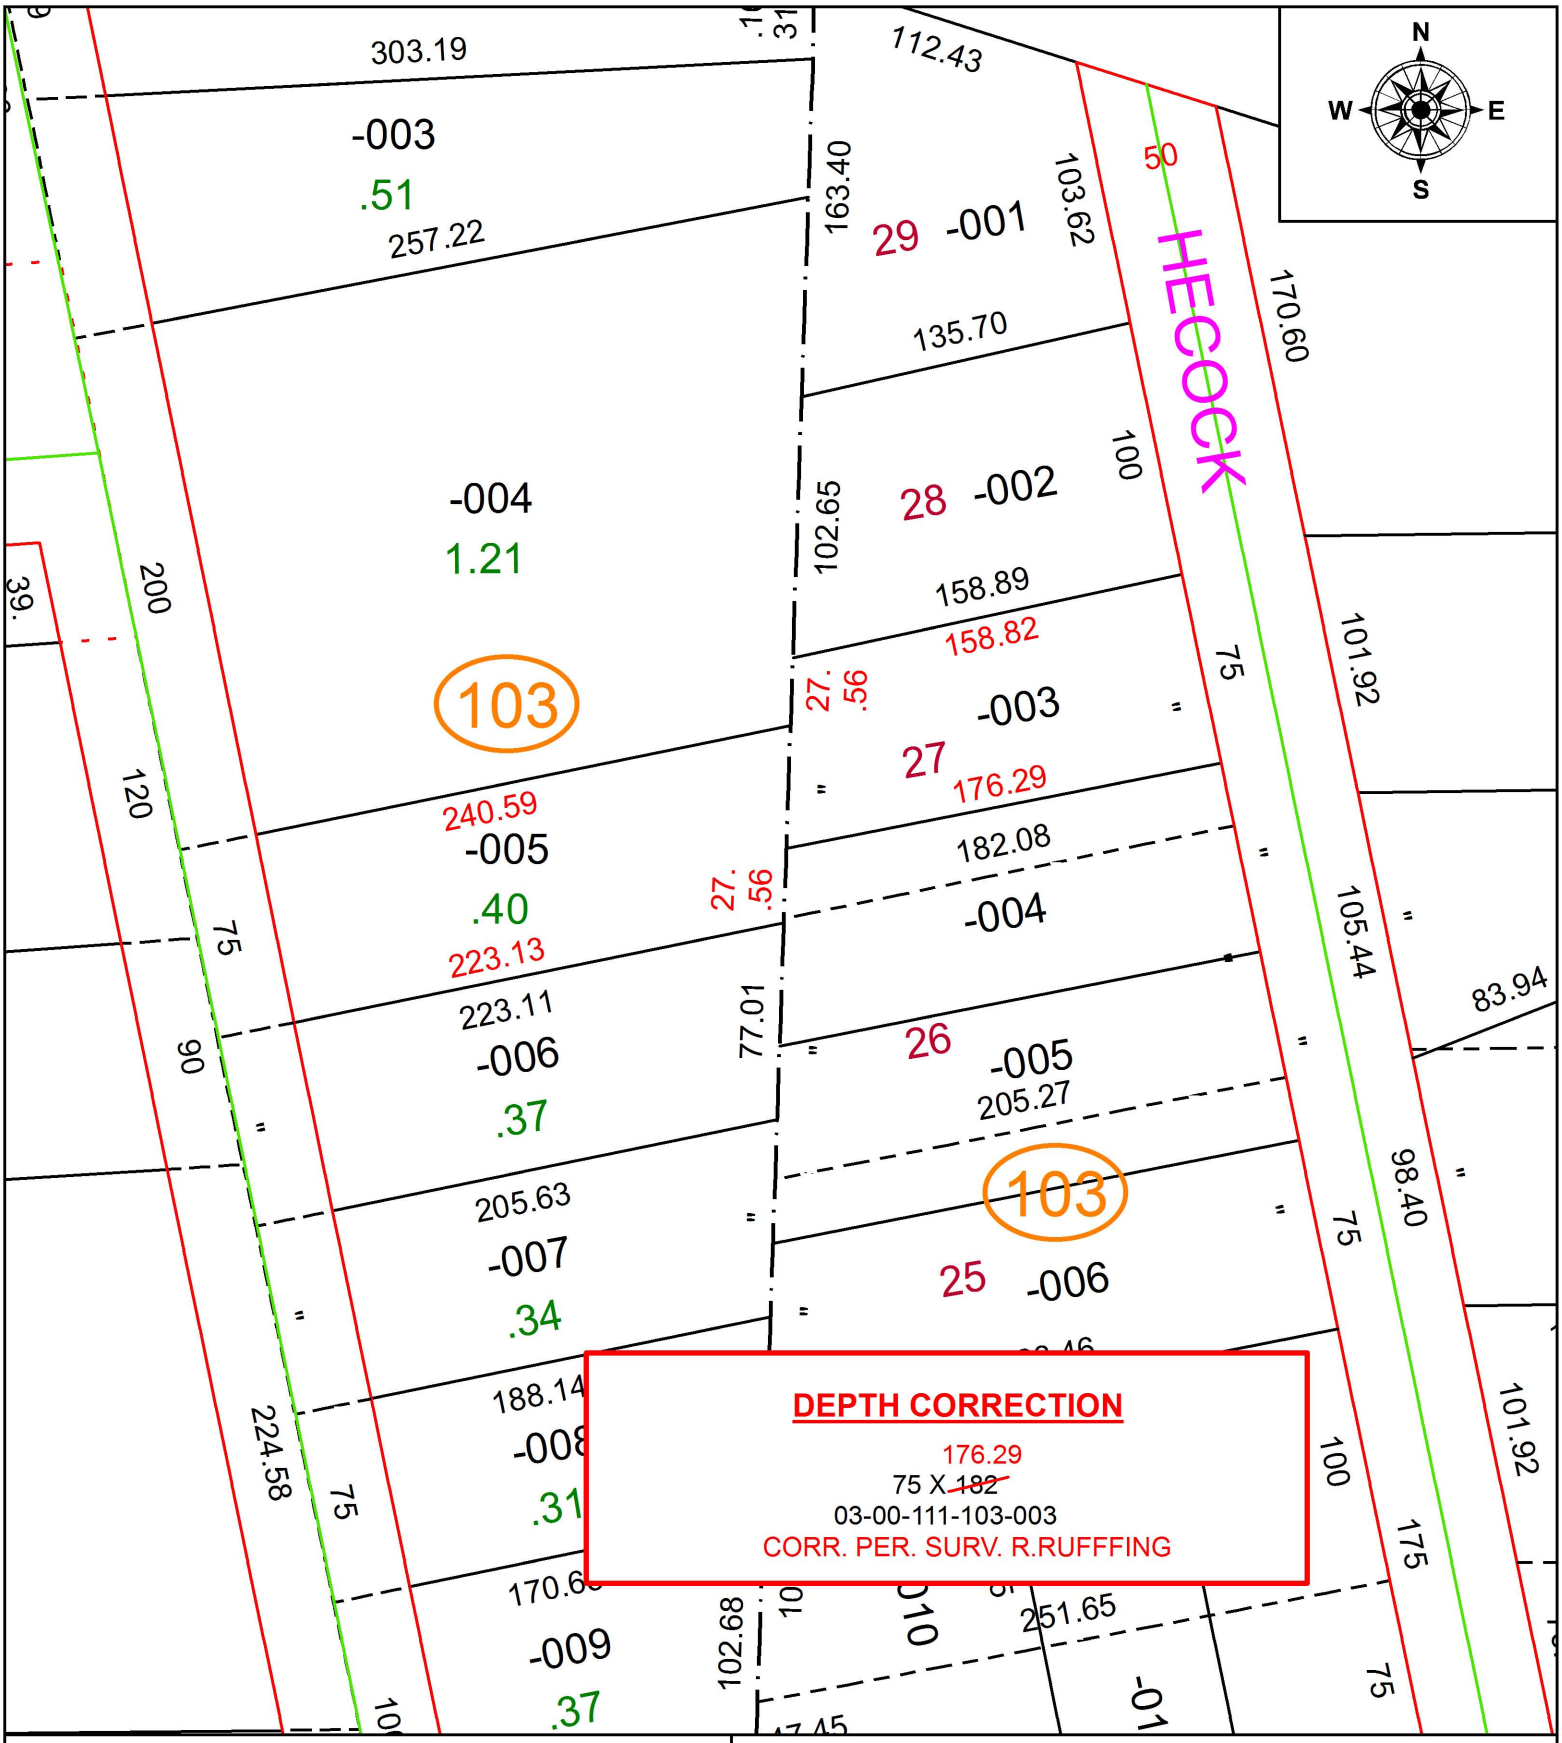

SPLITS/DEEDS PROCESSED

LORAIN COUNTY TAX MAP DEPARTMENT
226 MIDDLE AVE. ELYRIA, OH

SURVEYED BY: ROBERT M. RUFFING
CLOSURE: 1:100,395
MAP PAGE(S): 3-00-111
APPOVED BY: RRM **DATE:** 10-7-19
SCALE: 1" = 75 **PRIOR INSTRUMENT:** 20190713178