PARENT PARCEL: 11-00-055-000-024

CHILD PARCEL:

STARTING POINT: INTERSECTION OF C/L OF S.R. 82 AND C/L OF GILES RD.

19-04197-D

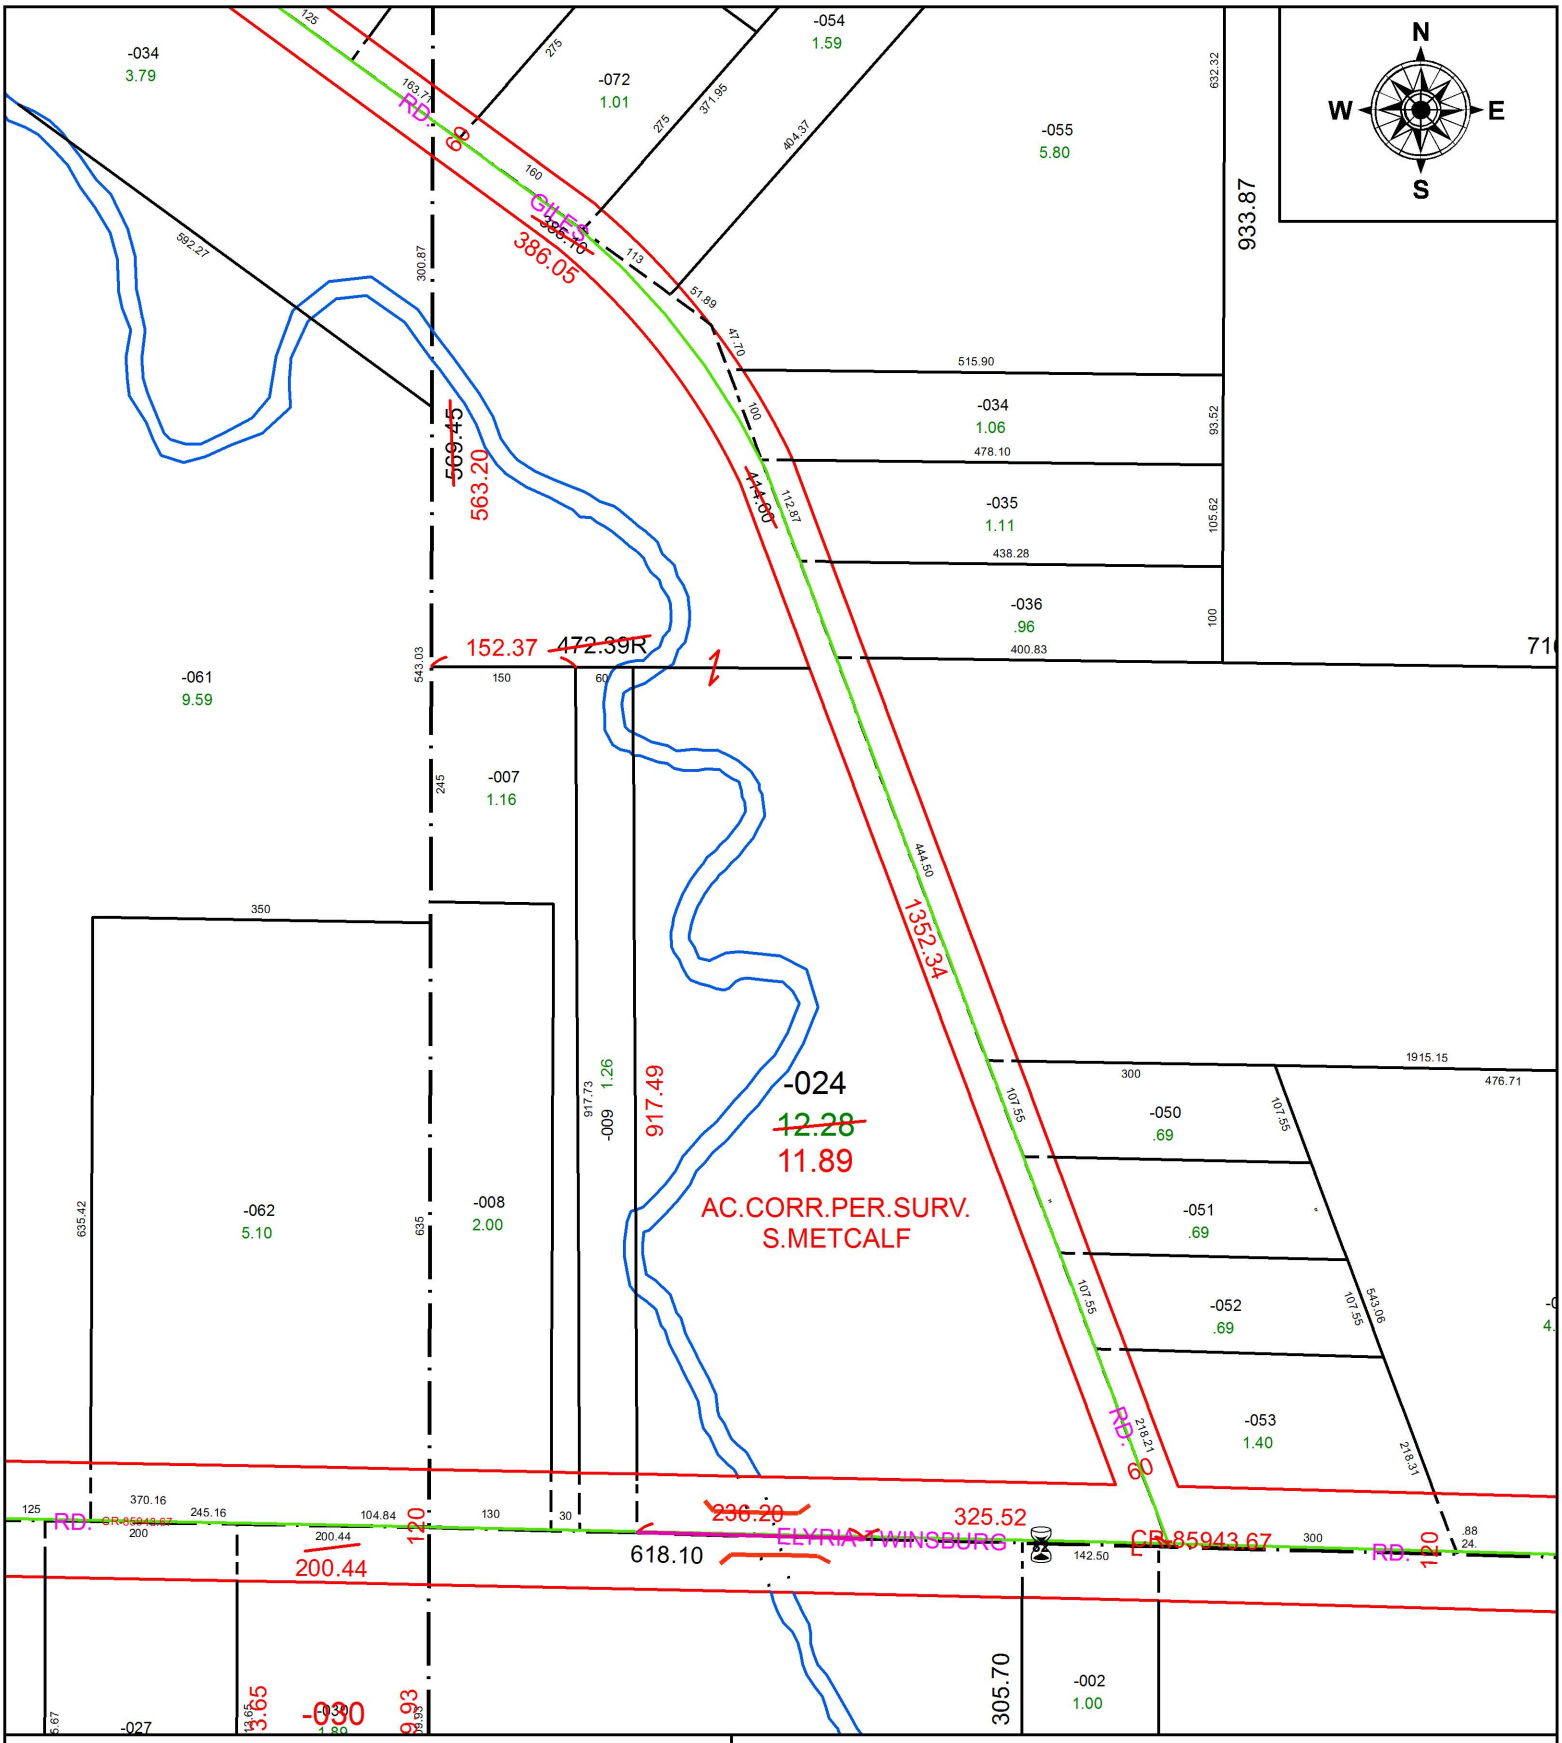

SPLITS/DEEDS PROCESSED

LORAIN COUNTY TAX MAP DEPARTMENT
226 MIDDLE AVE. ELYRIA, OH

SURVEYED BY: STEVEN J. METCALF
CLOSURE: 1:428,775
MAP PAGE(S): 11-00-055
APPOVED BY: RRM **DATE:** 9-26-19
SCALE: 1" = 200 **PRIOR INSTRUMENT:** 200400278628