PARENT PARCEL: 09-00-096-101-014

CHILD PARCEL:

STARTING POINT: INTERSECTION OF C/L OF S. MAIN ST. AND C/L OF LOCUST ST.

19-04199-D

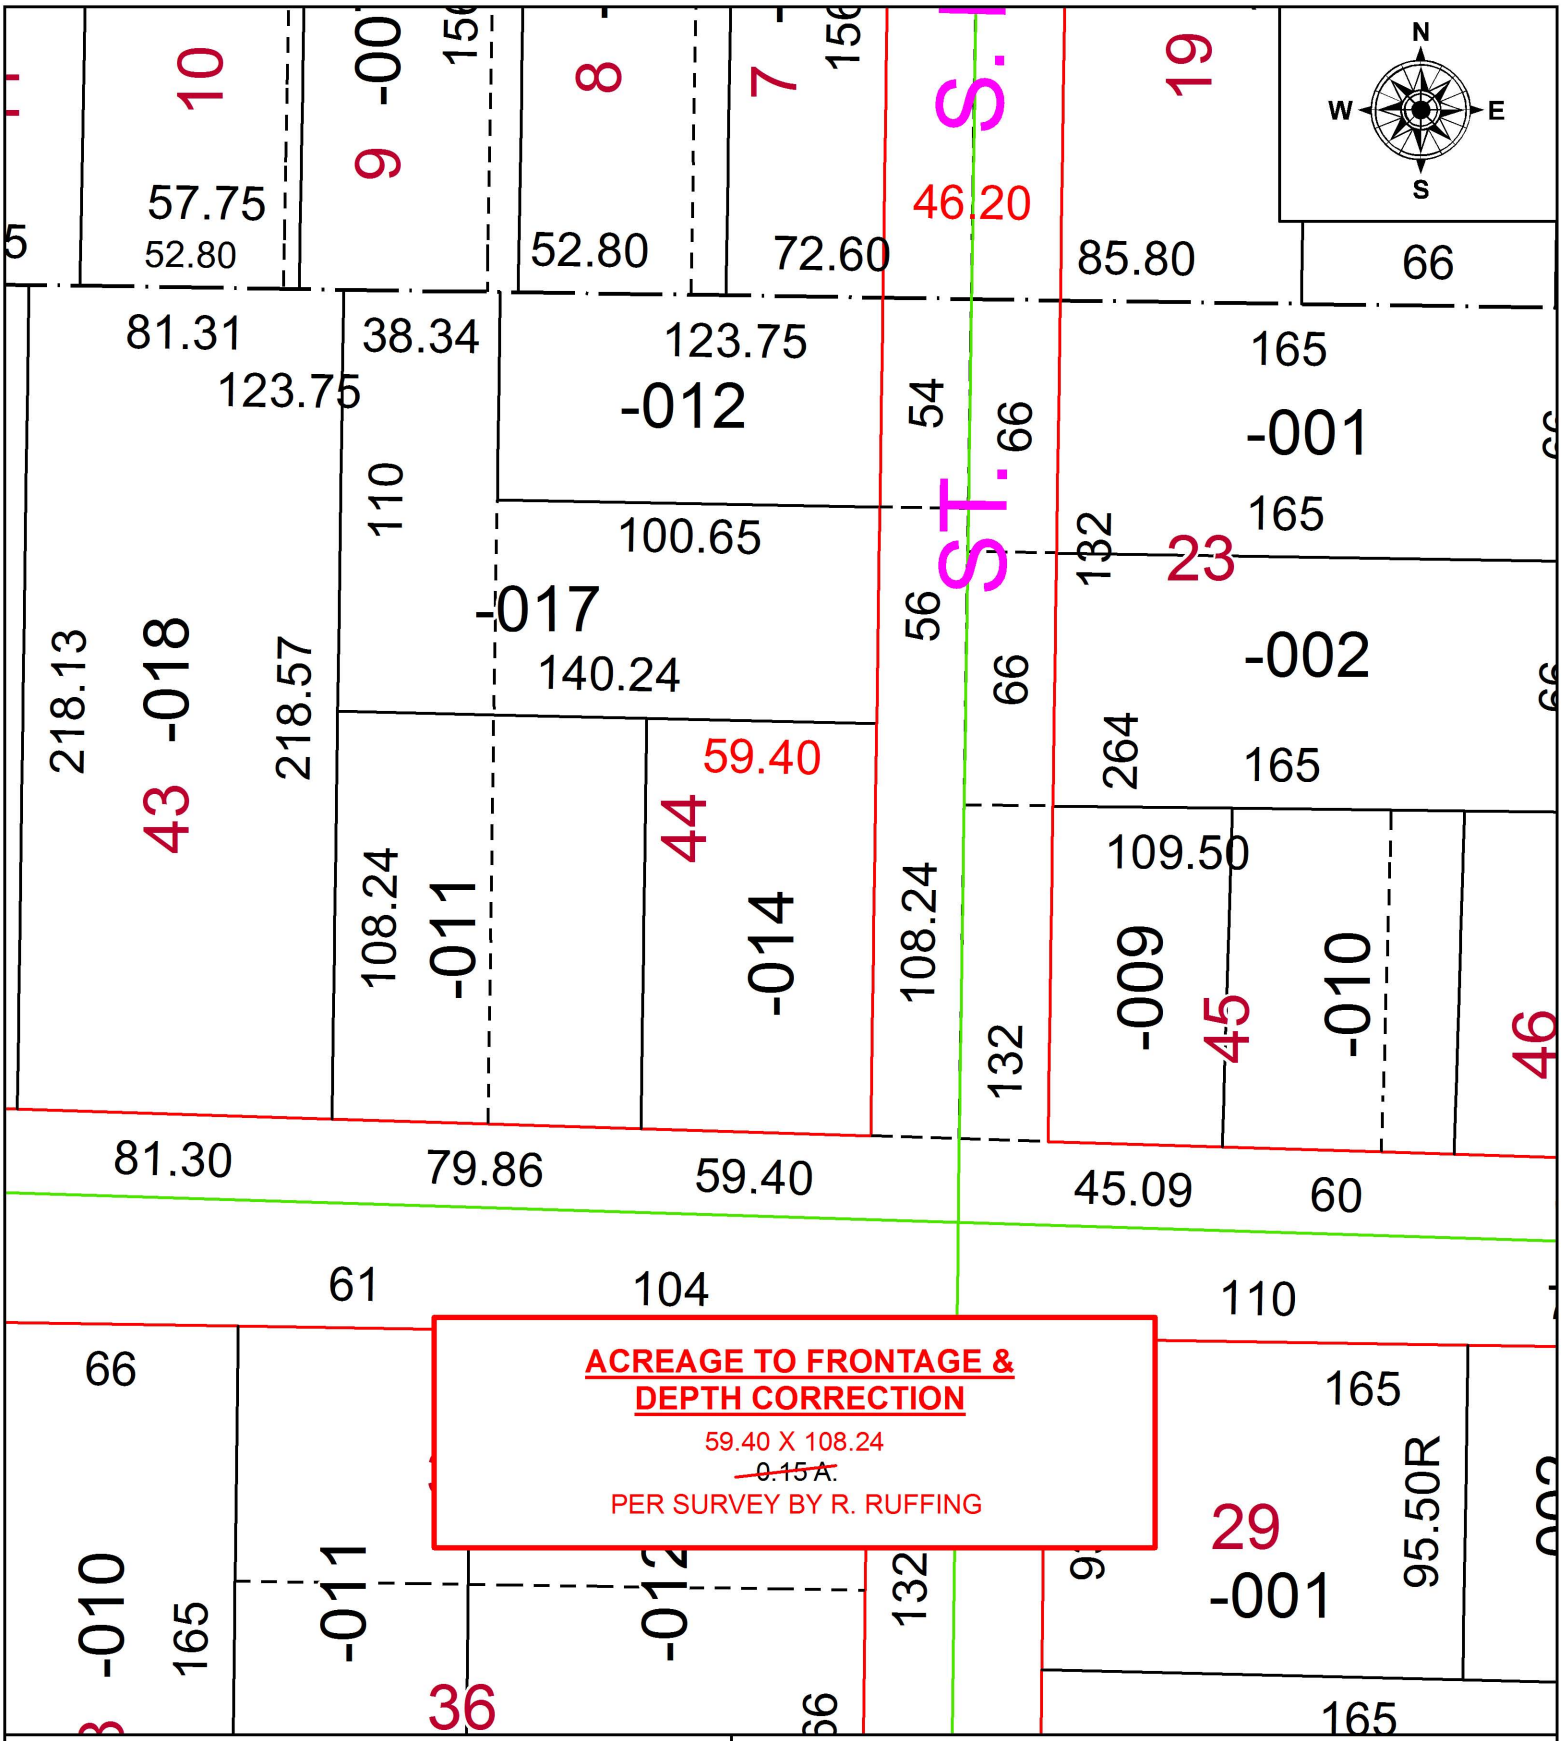

SPLITS/DEEDS PROCESSED

LORAIN COUNTY TAX MAP DEPARTMENT
226 MIDDLE AVE. ELYRIA, OH

SURVEYED BY: ROBERT M. RUFFING
CLOSURE: 1:2147483648
MAP PAGE(S): 9-00-096
APPOVED BY: RRM **DATE:** 10-1-19
SCALE: 1" = 50 **PRIOR INSTRUMENT:** 20190732150