PARENT PARCEL: 12-00-076-101-039, -040

CHILD PARCEL: 12-00-076-101-043 THRU -045

STARTING POINT: INTERSECTION OF C/L OF STATION RD. AND C/L OF S.R.82

20-04199

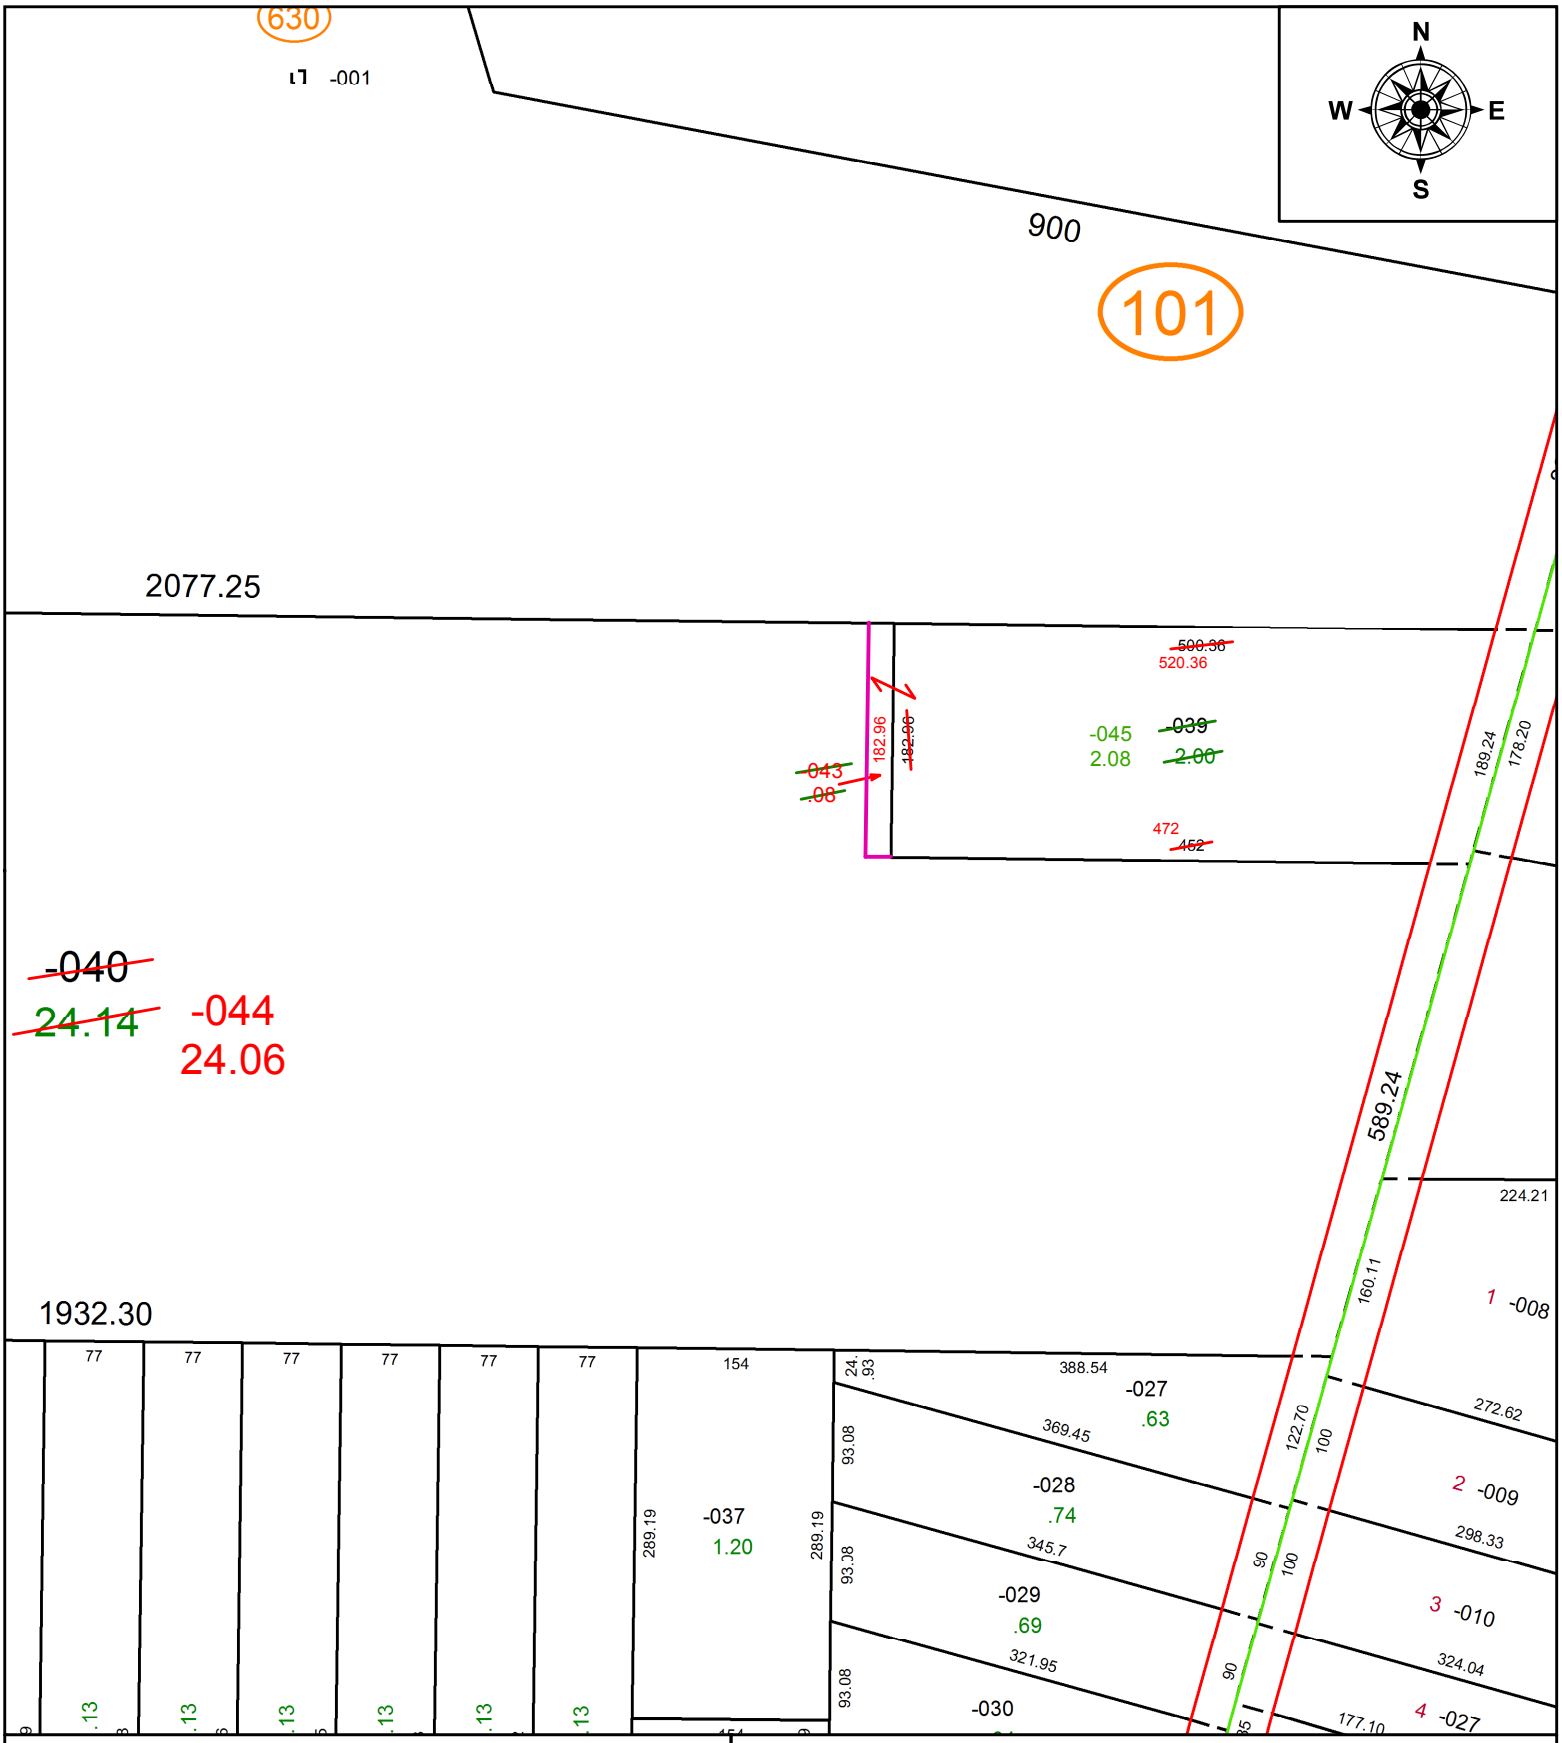

SPLITS/DEEDS PROCESSED

LORAIN COUNTY TAX MAP DEPARTMENT
226 MIDDLE AVE. ELYRIA, OH

SURVEYED BY: LOUIS J. GIFFELS
CLOSURE: 1:450,227
MAP PAGE(S): 12-00-076
APPOVED BY: RRM **DATE:** 10-22-20
SCALE: 1" = 150 **PRIOR INSTRUMENT:** OR 39/191