PARENT PARCEL: 12-00-037-000-004

CHILD PARCEL:

STARTING POINT: INTERSECTION OF C/L OF EAST RIVER RD. AND C/L OF EAGLE POINTE CT.

19-04200-D

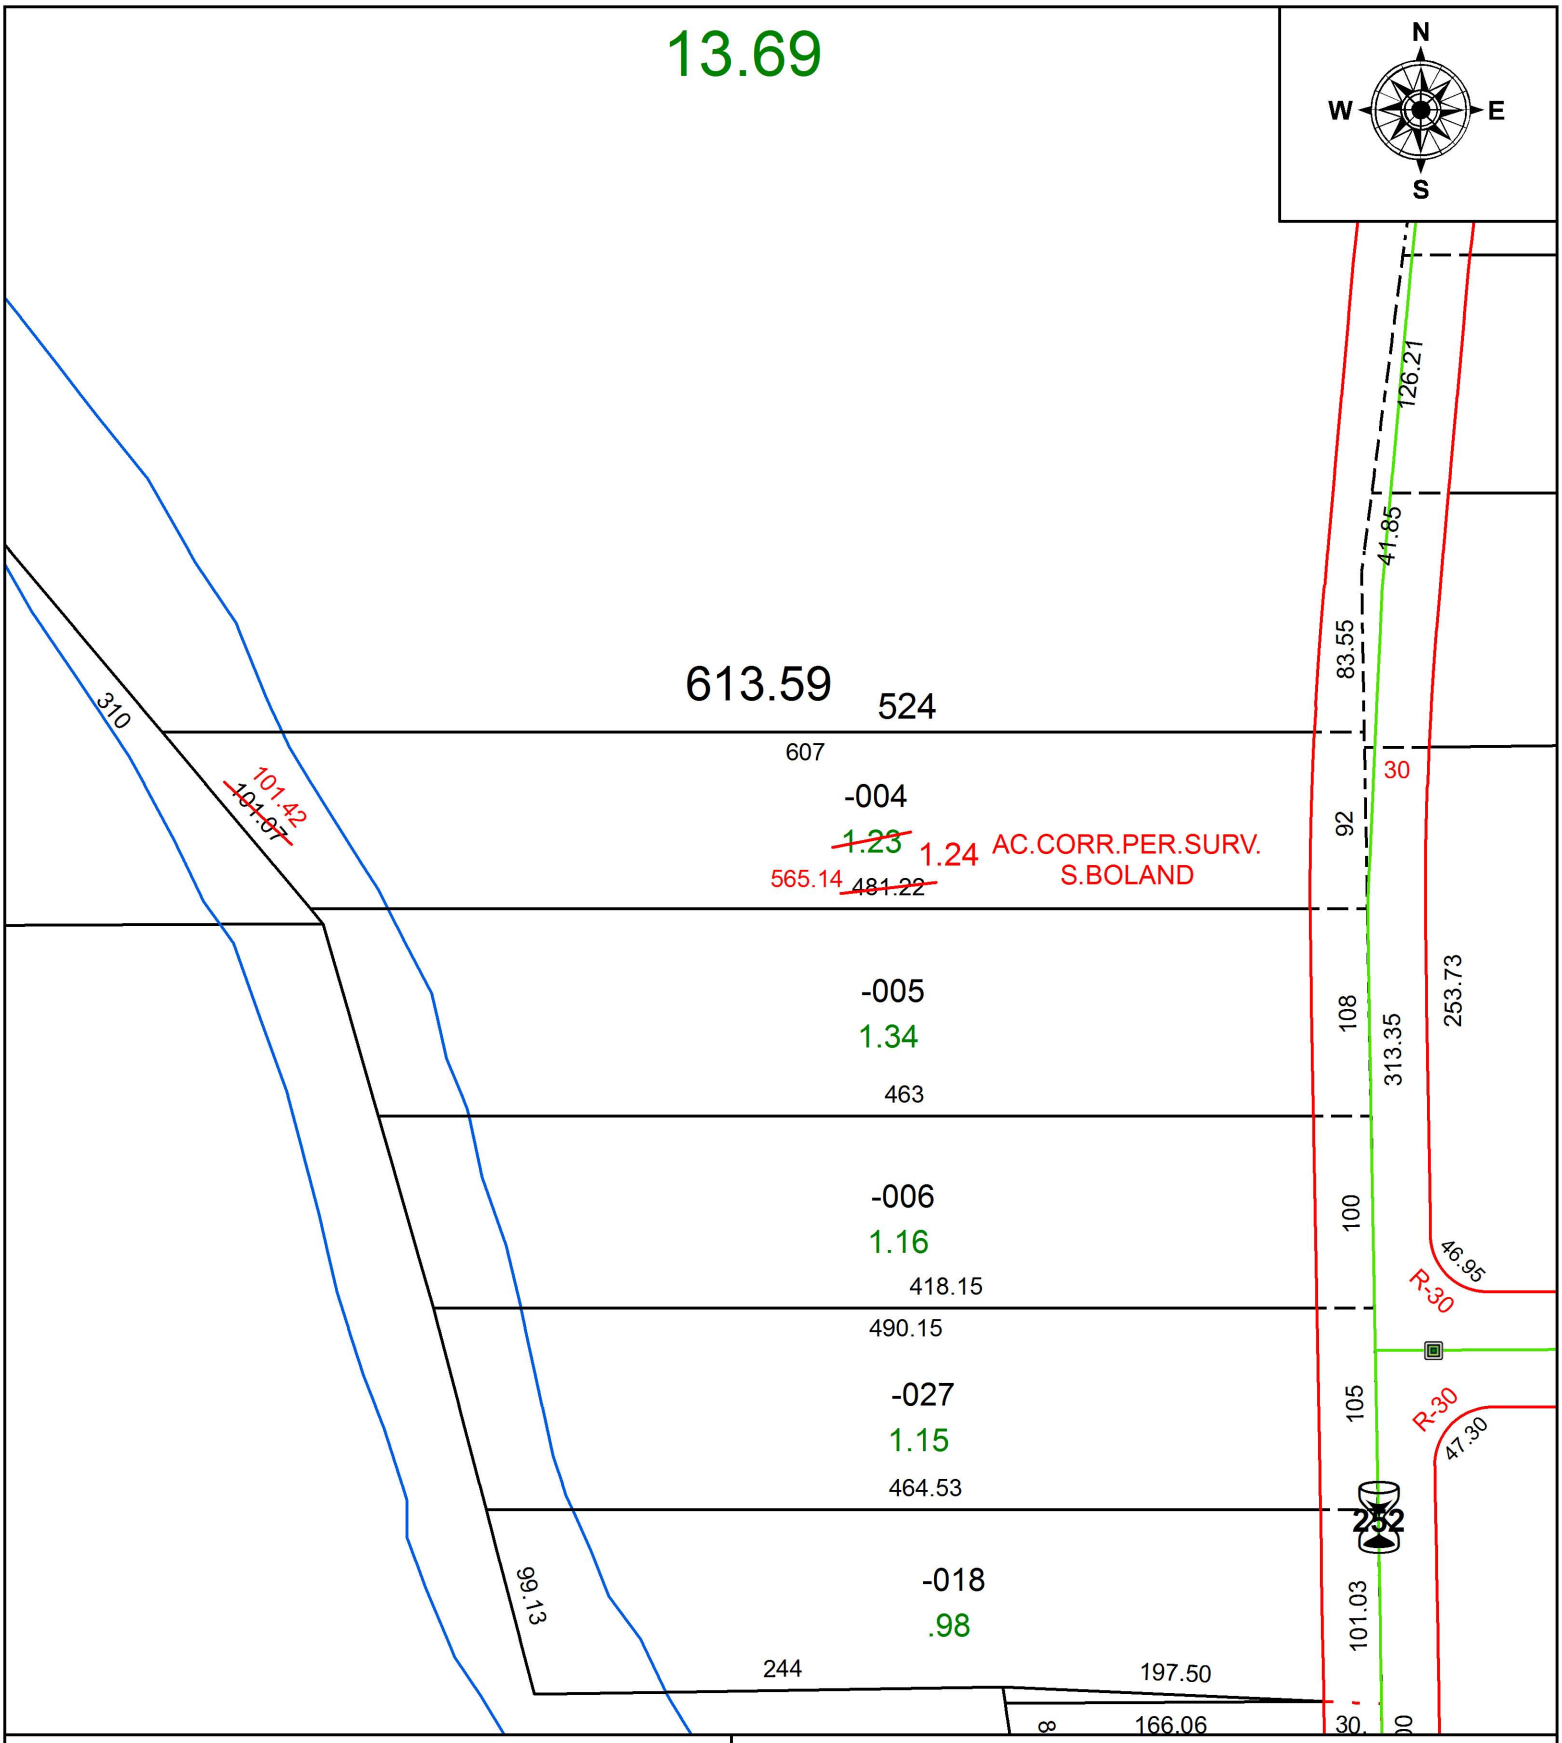

SPLITS/DEEDS PROCESSED

LORAIN COUNTY TAX MAP DEPARTMENT
226 MIDDLE AVE. ELYRIA, OH

SURVEYED BY: SEAN A. BOLAND
CLOSURE: 1:914,275
MAP PAGE(S): 12-00-037
APPOVED BY: RRM **DATE:** 10-1-19
SCALE: 1" = 100 **PRIOR INSTRUMENT:** 20130484468