PARENT PARCEL: 06-24-102-000-021, -022

CHILD PARCEL:

STARTING POINT: INTERSECTION OF C/L OF WOODFORD AVE AND C/L OF GARDEN ST.

19-04204-D

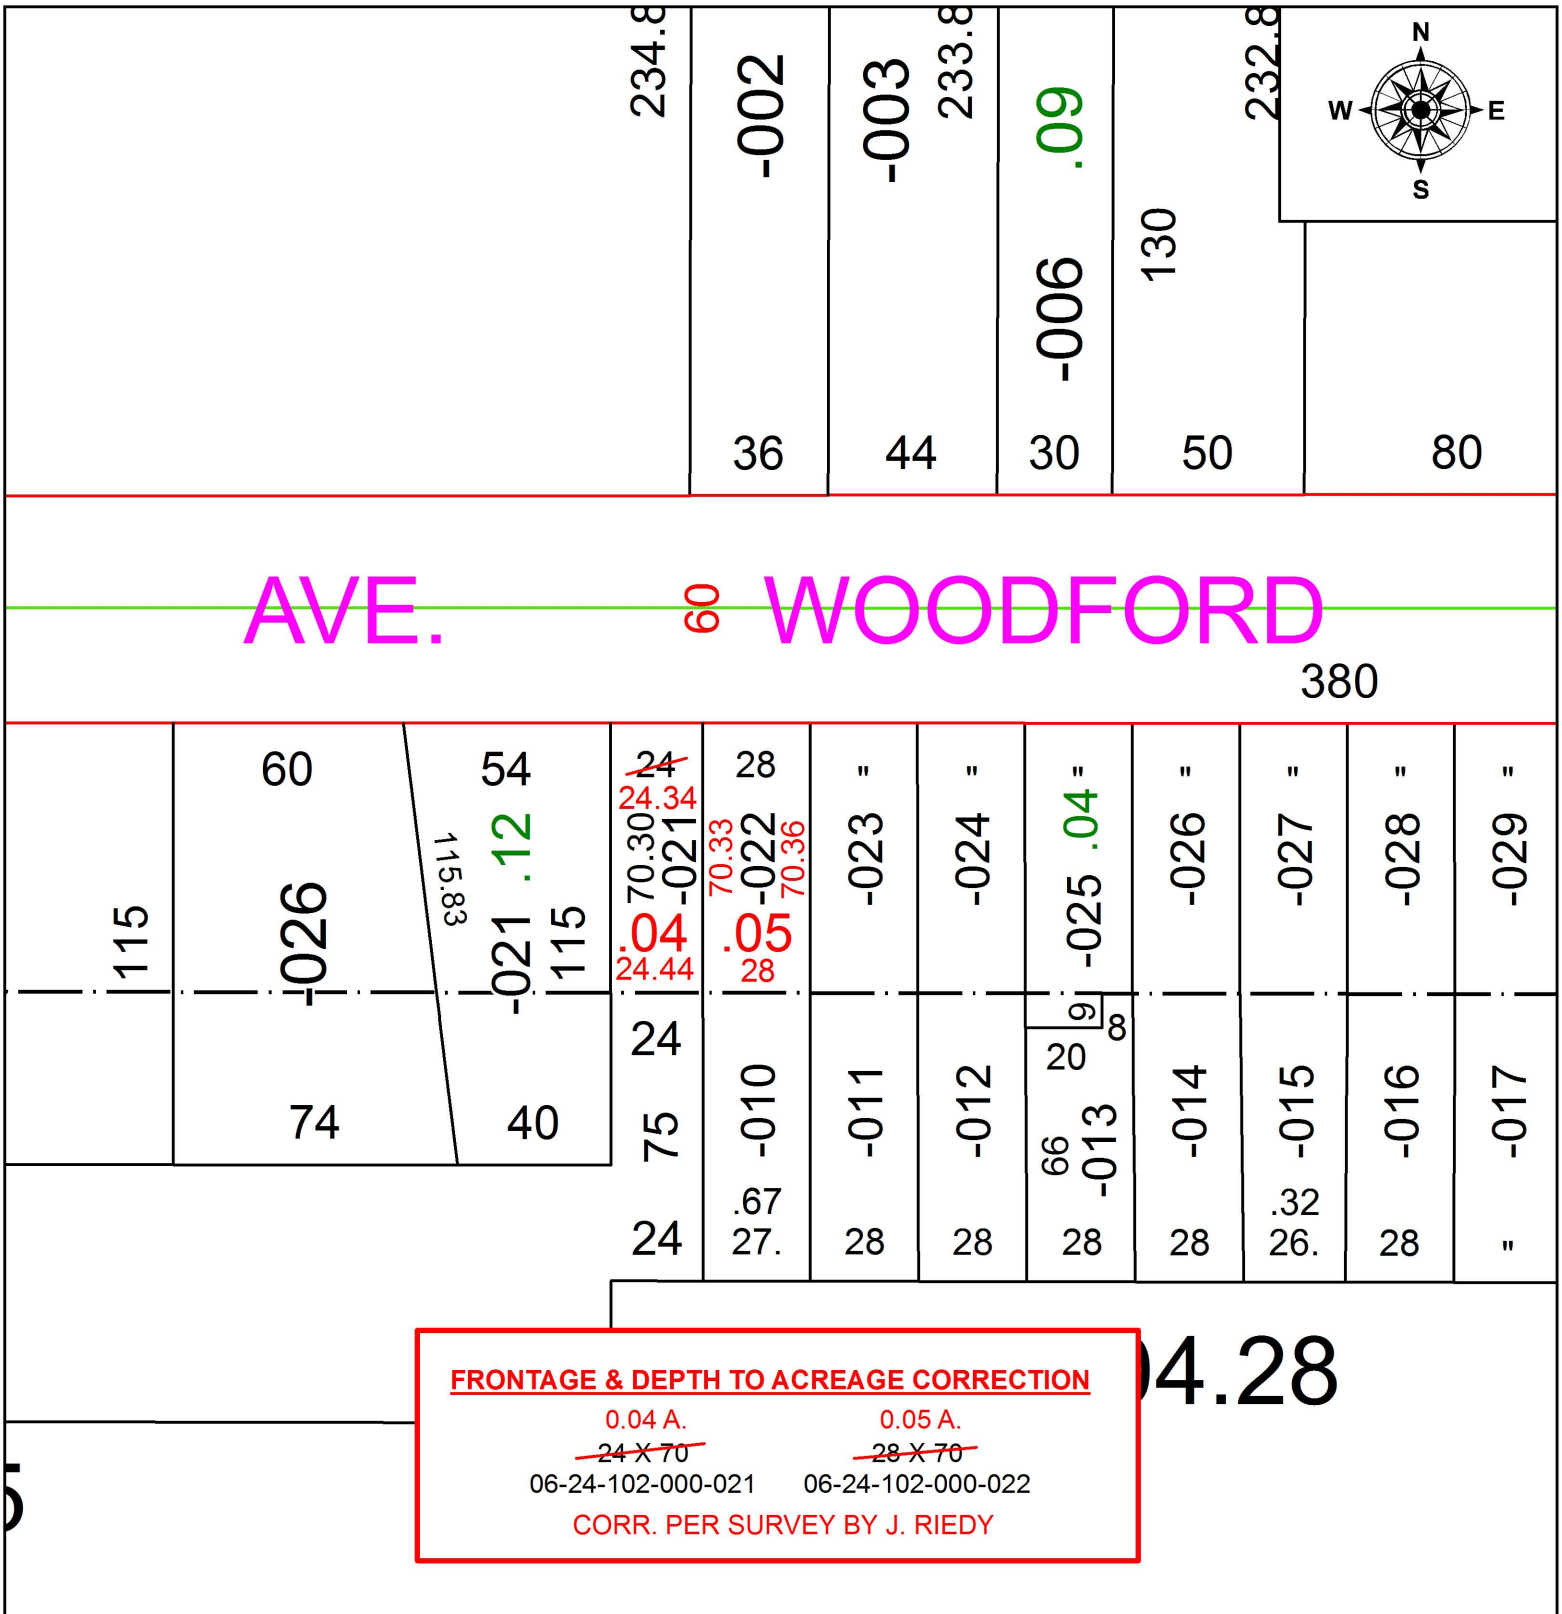

FRONTAGE & DEPTH TO ACREAGE CORRECTION

0.04 A.	0.05 A.
~~24 X 70~~	~~28 X 70~~
06-24-102-000-021	06-24-102-000-022

CORR. PER SURVEY BY J. RIEDY

SPLITS/DEEDS PROCESSED

LORAIN COUNTY TAX MAP DEPARTMENT
226 MIDDLE AVE. ELYRIA, OH

SURVEYED BY: JOSHUA S. RIEDY
CLOSURE: 1:1,435,944
MAP PAGE(S): 6-24-102
APPOVED BY: RRM **DATE:** 10-15-19
SCALE: 1" = 50 **PRIOR INSTRUMENT:** 20190703293