PARENT PARCEL: 12-00-078-000-004

CHILD PARCEL: 12-00-078-000-032, -033

STARTING POINT: INTERSECTION OF C/L OF OSBORNE RD. AND C/L OF STATION RD.

20-04204

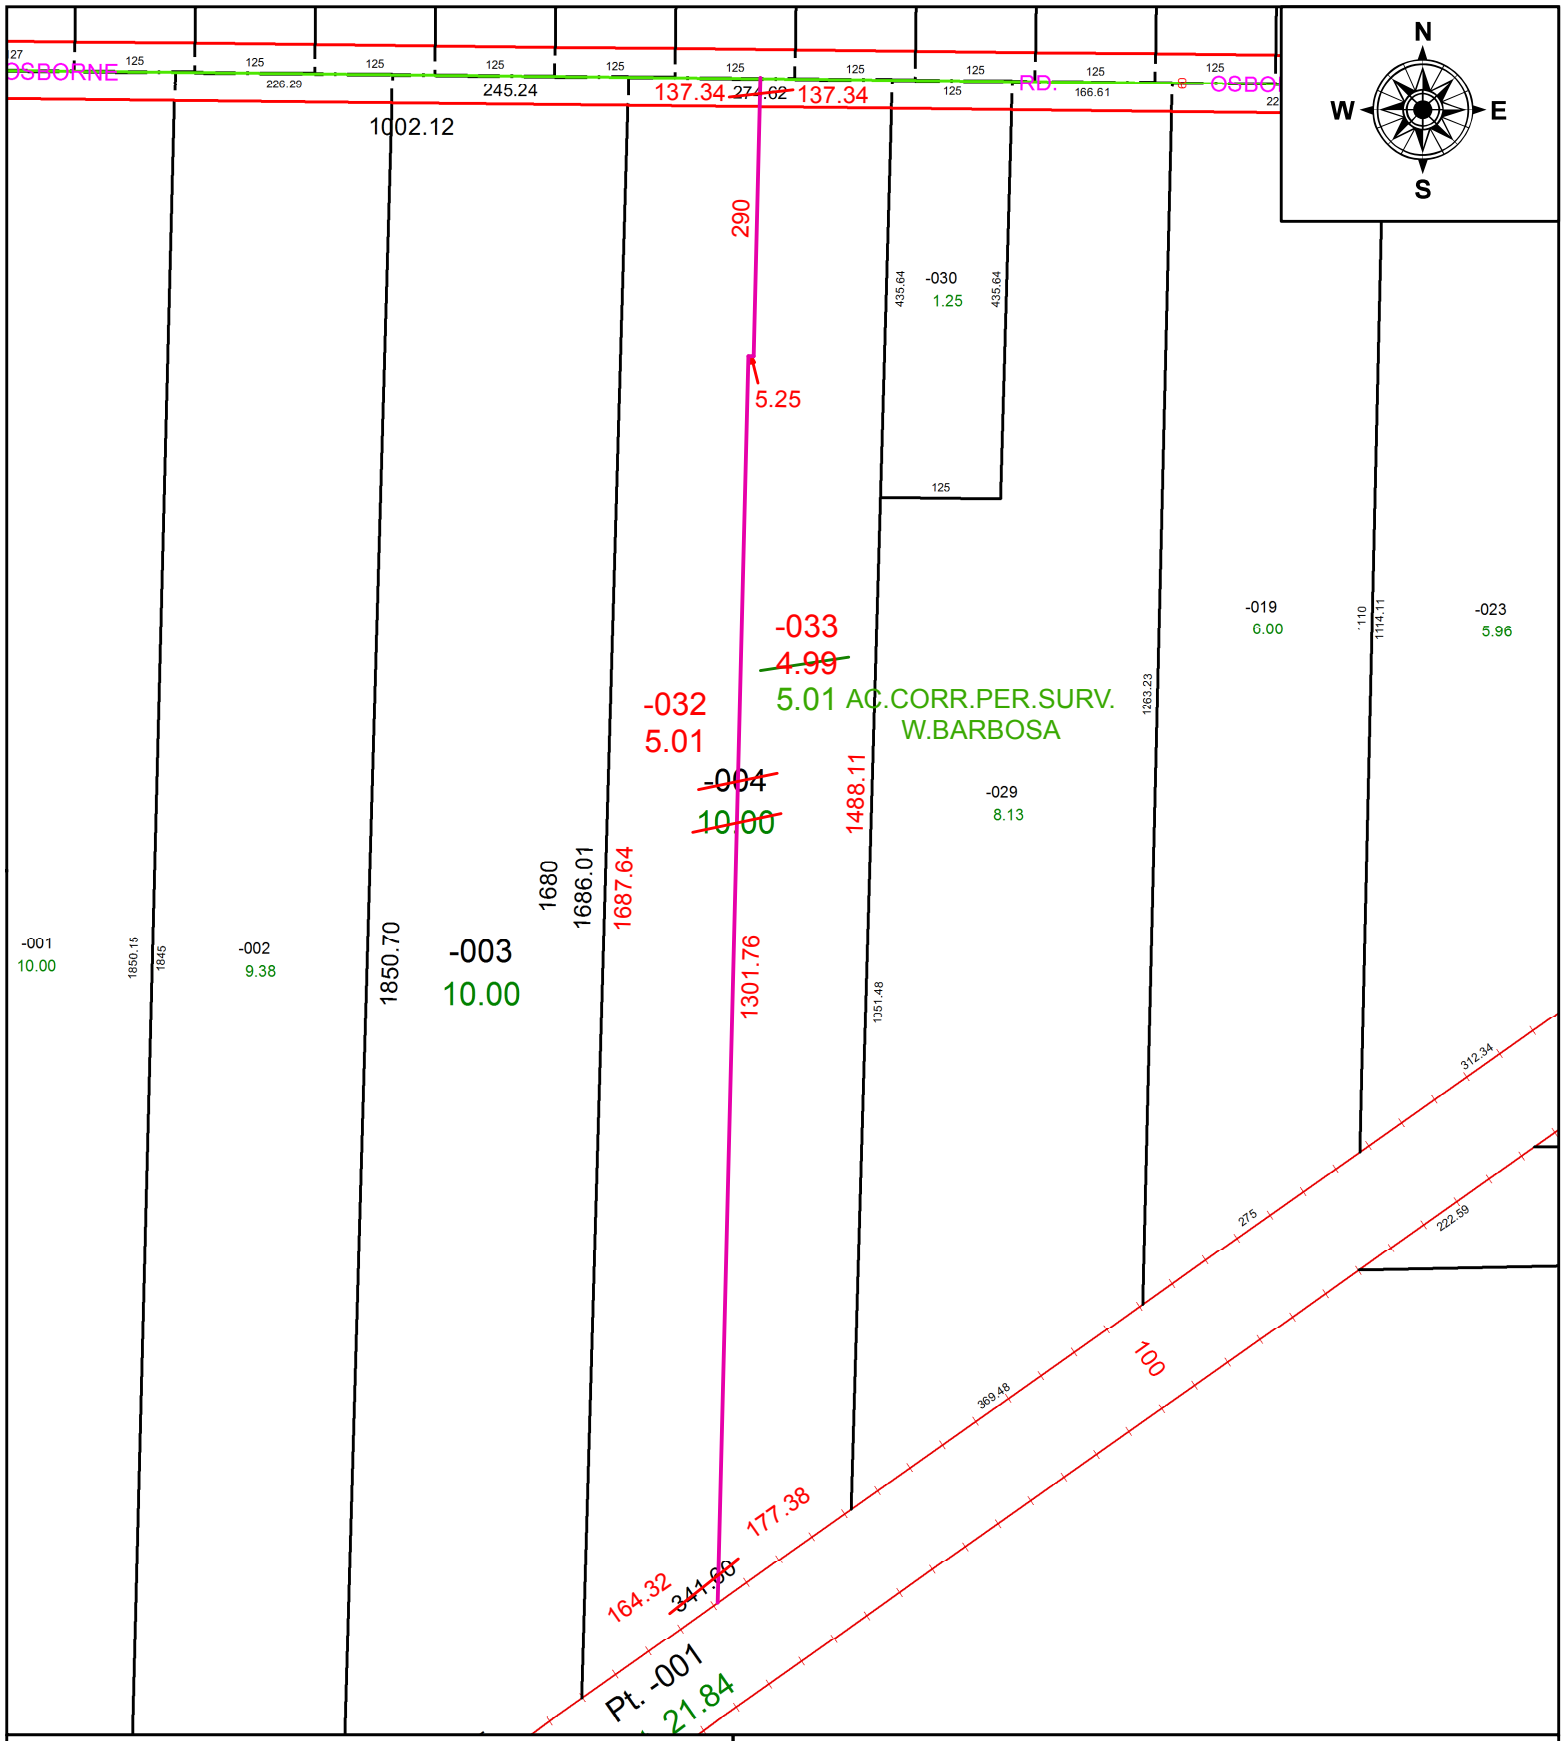

SPLITS/DEEDS PROCESSED

LORAIN COUNTY TAX MAP DEPARTMENT
226 MIDDLE AVE. ELYRIA, OH

SURVEYED BY: WILFREDO BARBOSA
CLOSURE: 1:4,391,315
MAP PAGE(S): 12-00-078
APPOVED BY: RRM **DATE:** 10-30-20
SCALE: 1" = 200 **PRIOR INSTRUMENT:** 2020780675