PARENT PARCEL: 11-00-007-000-074, 11-00-014-000-033

CHILD PARCEL:

STARTING POINT: NORTHWEST CORNER OF S/L 1 IN HAWKE-COOLEY ESTATES

19-04206-C

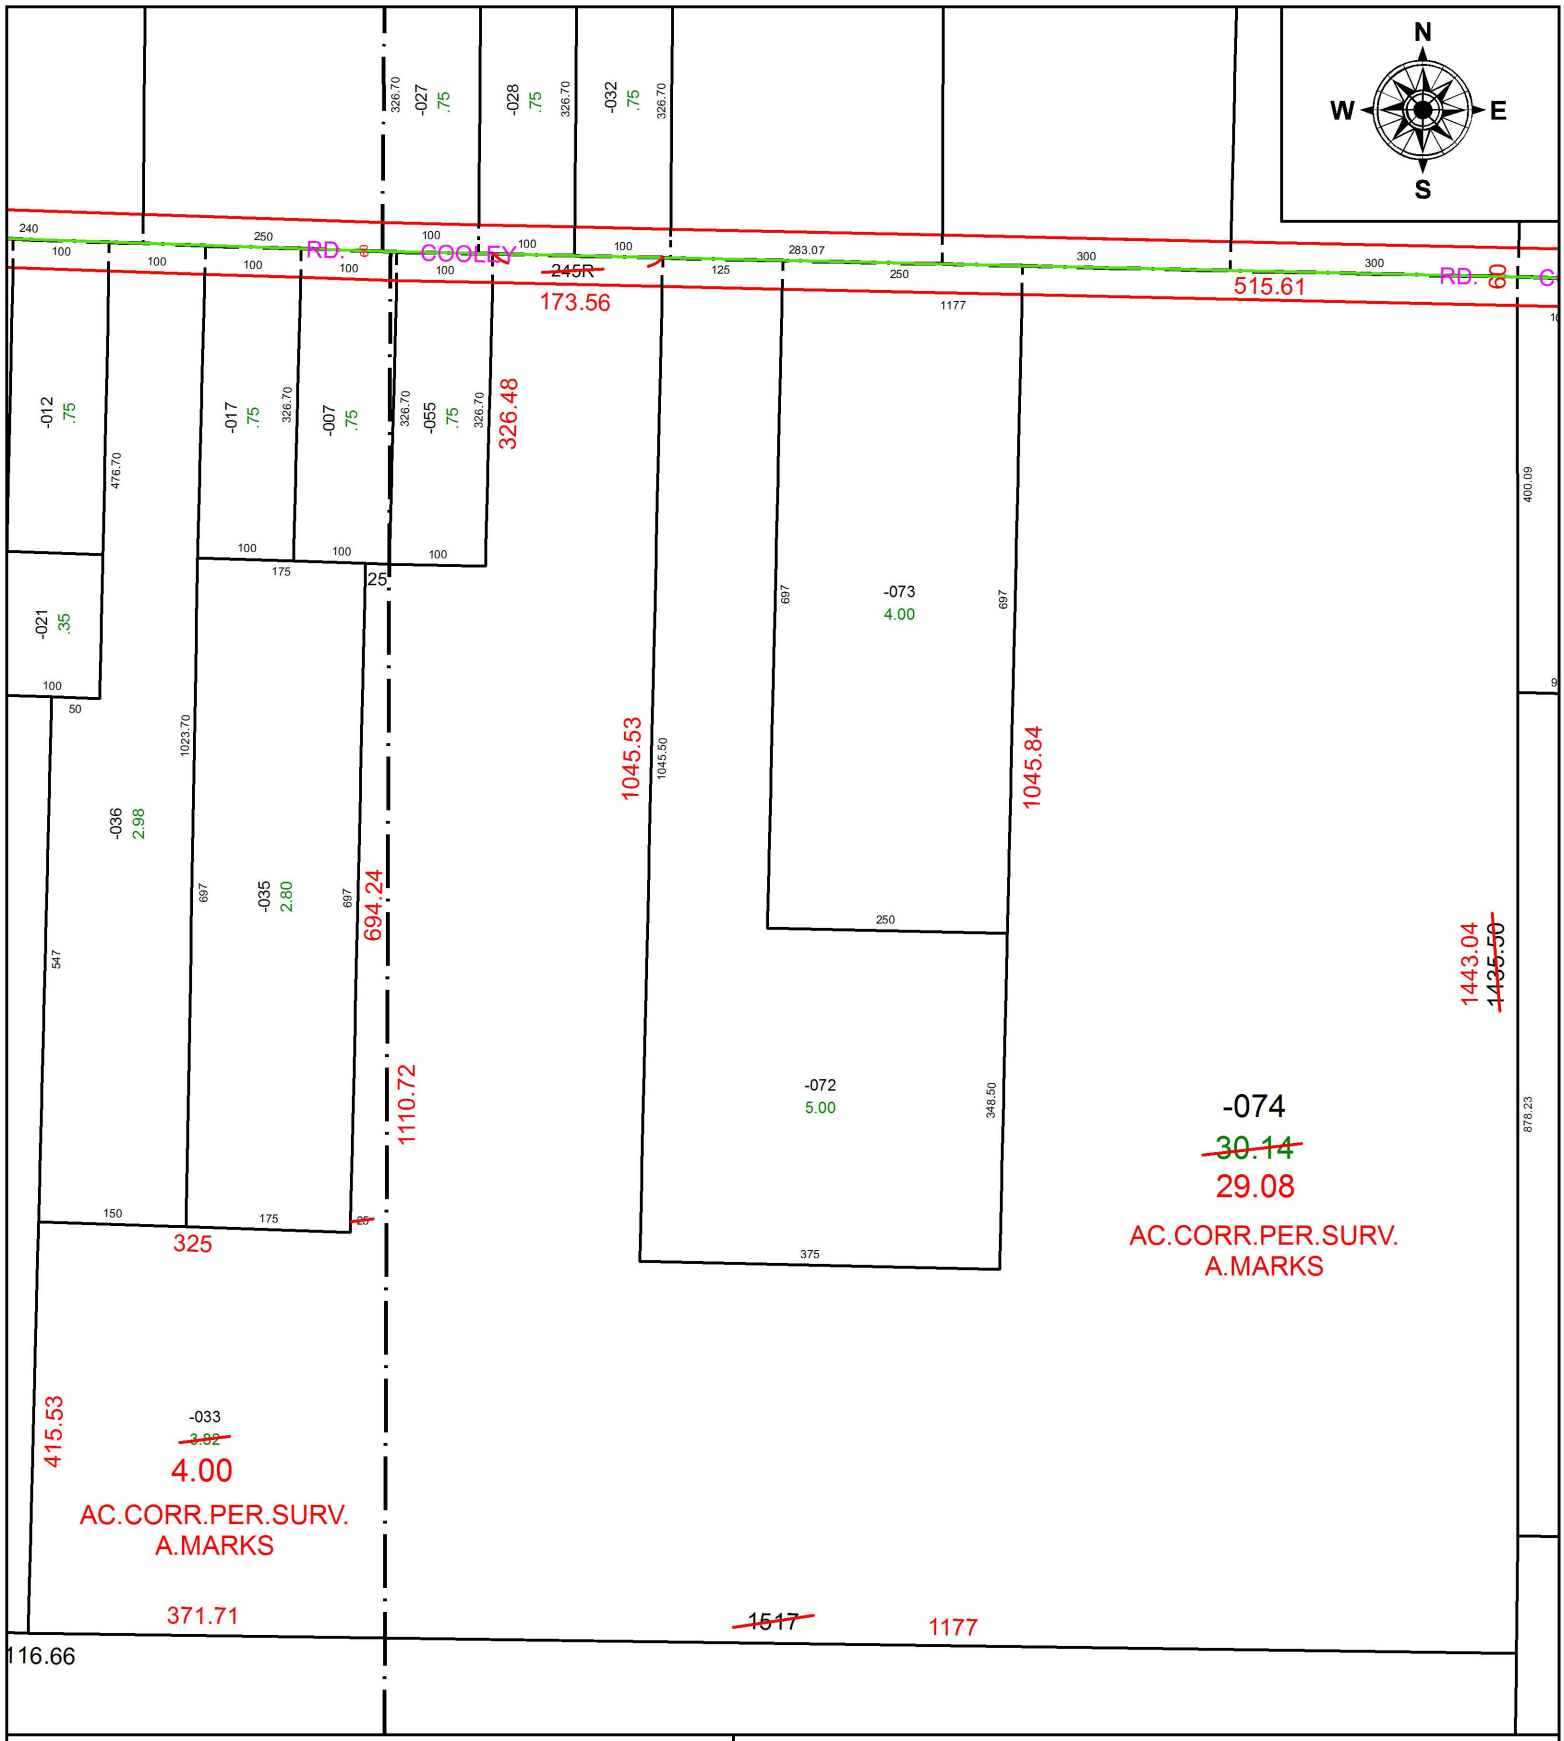

SPLITS/DEEDS PROCESSED

LORAIN COUNTY TAX MAP DEPARTMENT
226 MIDDLE AVE. ELYRIA, OH

SURVEYED BY: ALEX MARKS
CLOSURE: 1:840,796
MAP PAGE(S): 11-00-007
APPOVED BY: RRM **DATE:** 10-16-19
SCALE: 1" = 200 **PRIOR INSTRUMENT:** 20180691793