**PARENT PARCEL:** 06-24-007-104-031

**CHILD PARCEL:** 06-24-007-104-033, -034, 06-24-008-107-007

**STARTING POINT:** INTERSECTION OF C/L OF MUSSEY AVE. AND C/L OF WEST RIVER RD.

# 20-04207

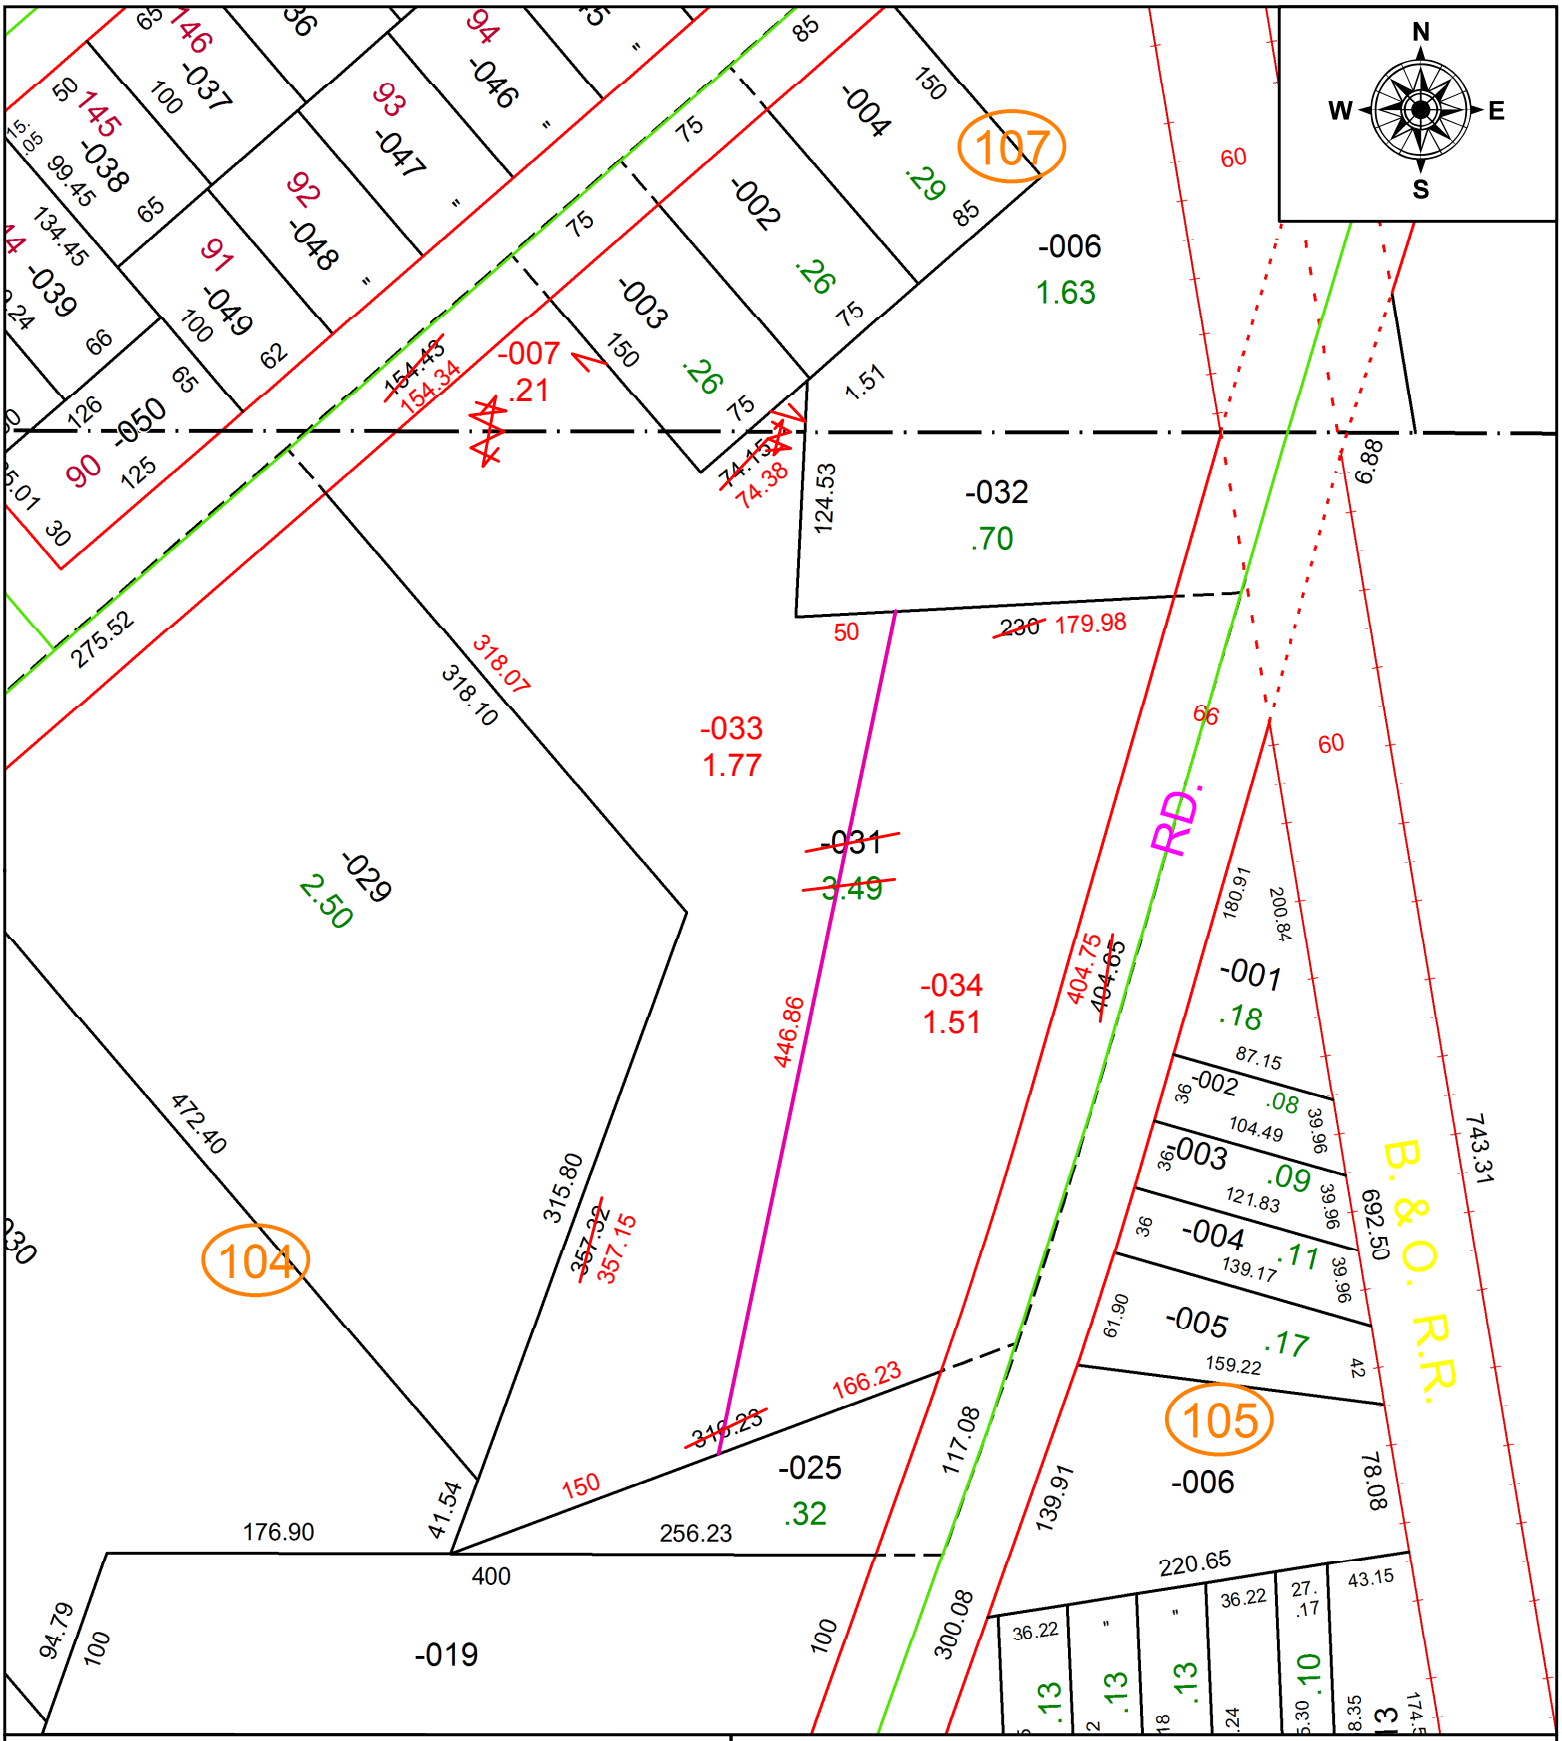


**SPLITS/DEEDS PROCESSED**

LORAIN COUNTY TAX MAP DEPARTMENT
226 MIDDLE AVE. ELYRIA, OH

**SURVEYED BY:** WILFREDO BARBOSA
**CLOSURE:** 1:134,421
**MAP PAGE(S):** 6-24-007
**APPOVED BY:** RRM **DATE:** 11-5-2020
**SCALE:** 1" = 100 **PRIOR INSTRUMENT:** 20150562707