PARENT PARCEL: 10-00-005-105-001
CHILD PARCEL: 10-00-004-131-084, 10-00-005-105-022
STARTING POINT: INTERSECTION OF C/L OF GRAFTON RD. AND C/L OF INDIAN HOLLOW RD.

19-04210-A

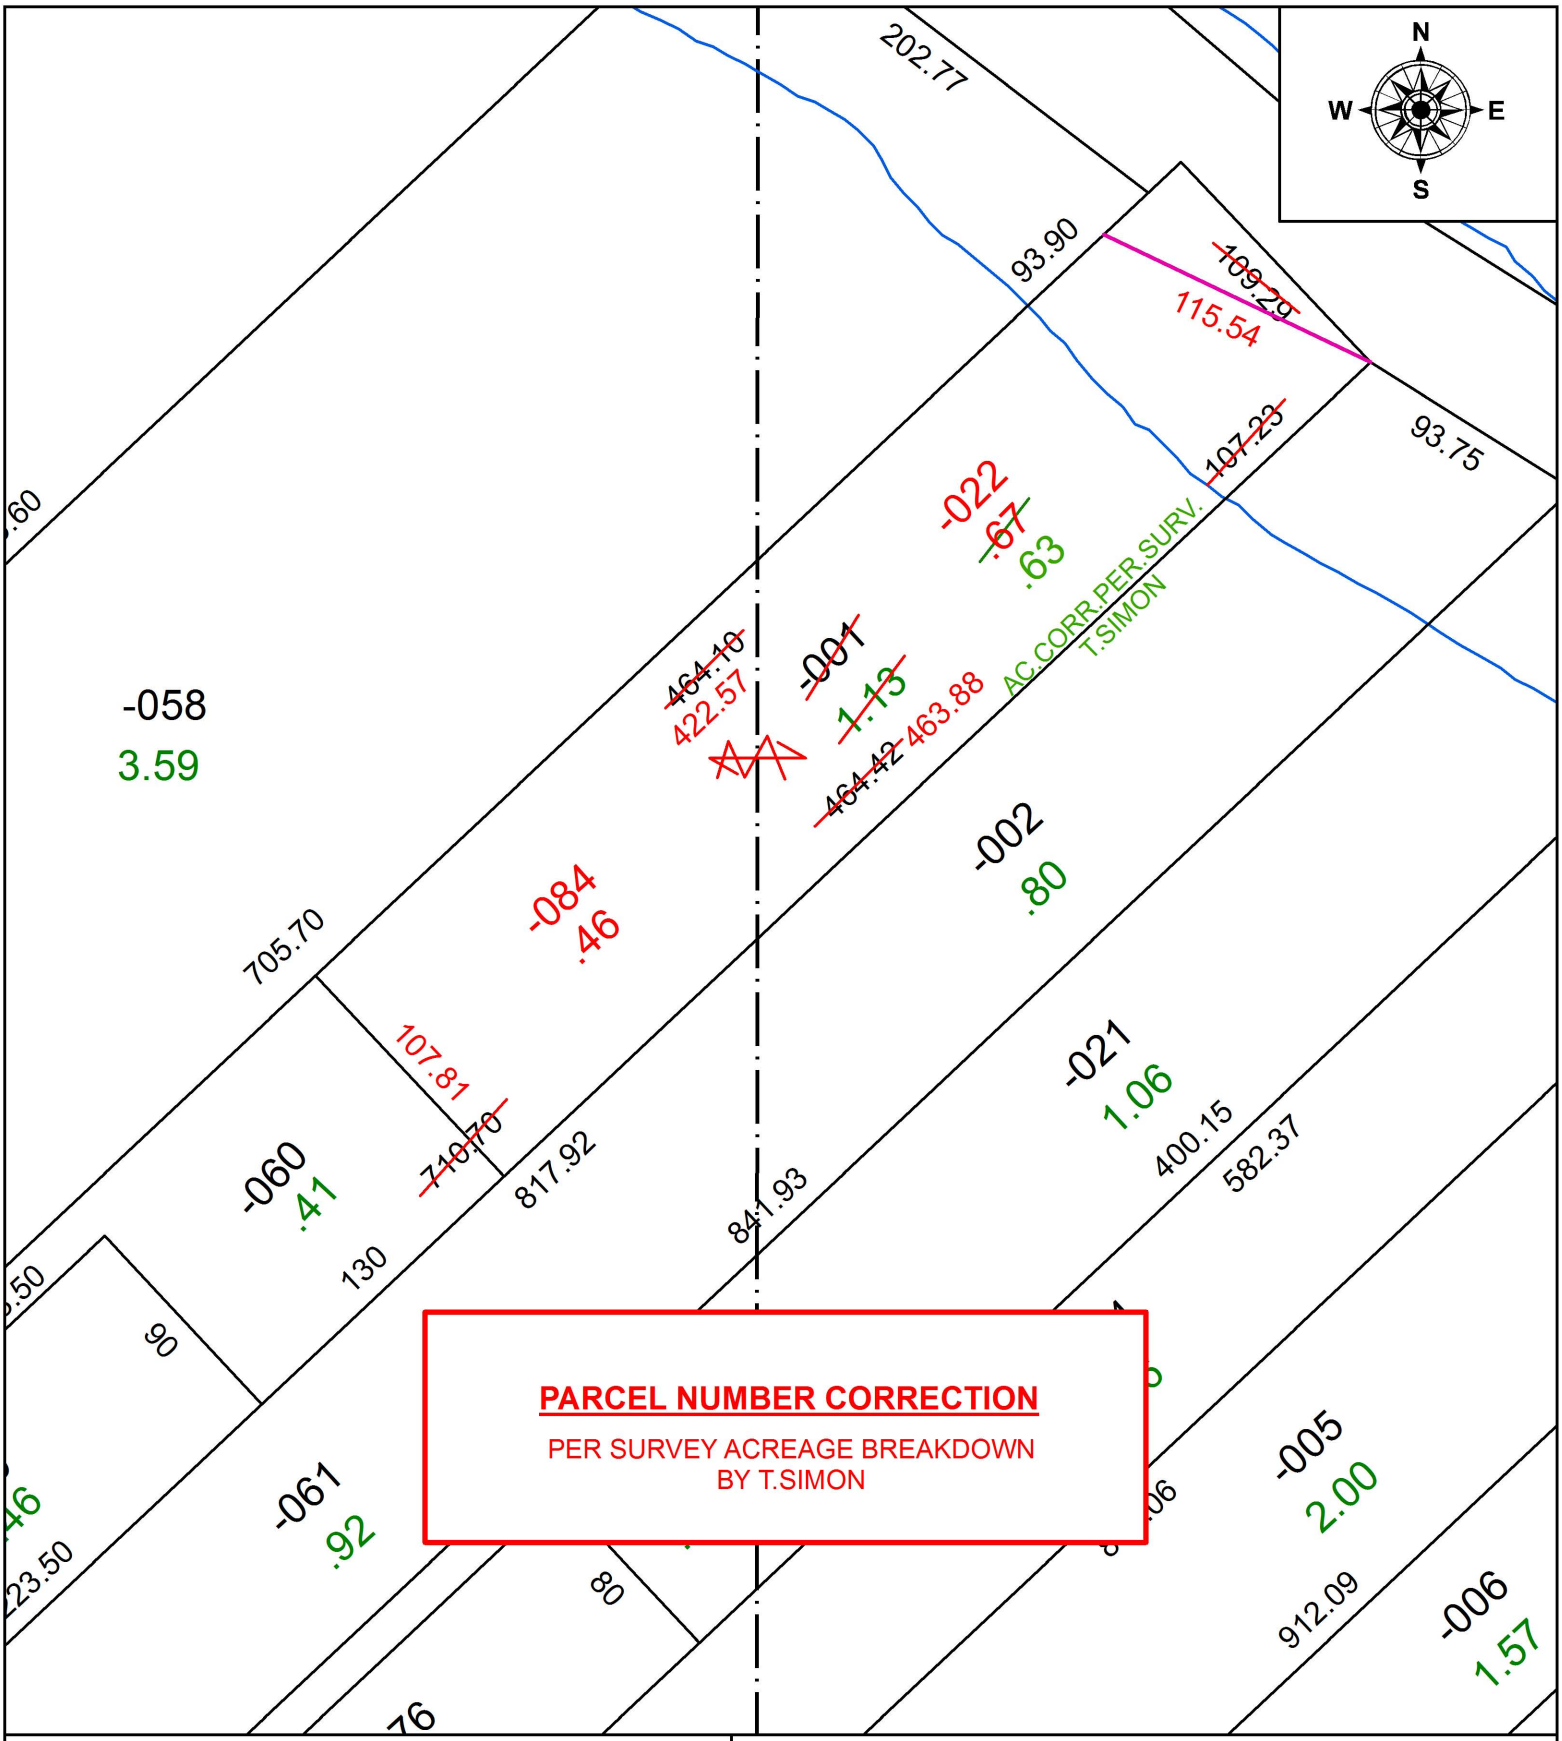

SPLITS/DEEDS PROCESSED
LORAIN COUNTY TAX MAP DEPARTMENT
226 MIDDLE AVE. ELYRIA, OH

SURVEYED BY: THOMAS A. SIMON
CLOSURE: 1:925,464
MAP PAGE(S): 10-00-005
APPOVED BY: RRM **DATE:** 10-21-19
SCALE: 1" = 75 **PRIOR INSTRUMENT:** 20190718699