PARENT PARCEL: 06-24-048-000-027

CHILD PARCEL:

STARTING POINT: INTERSECTION OF C/L OF STANG RD. AND C/L OF WEST RIDGE RD.

19-04215-D

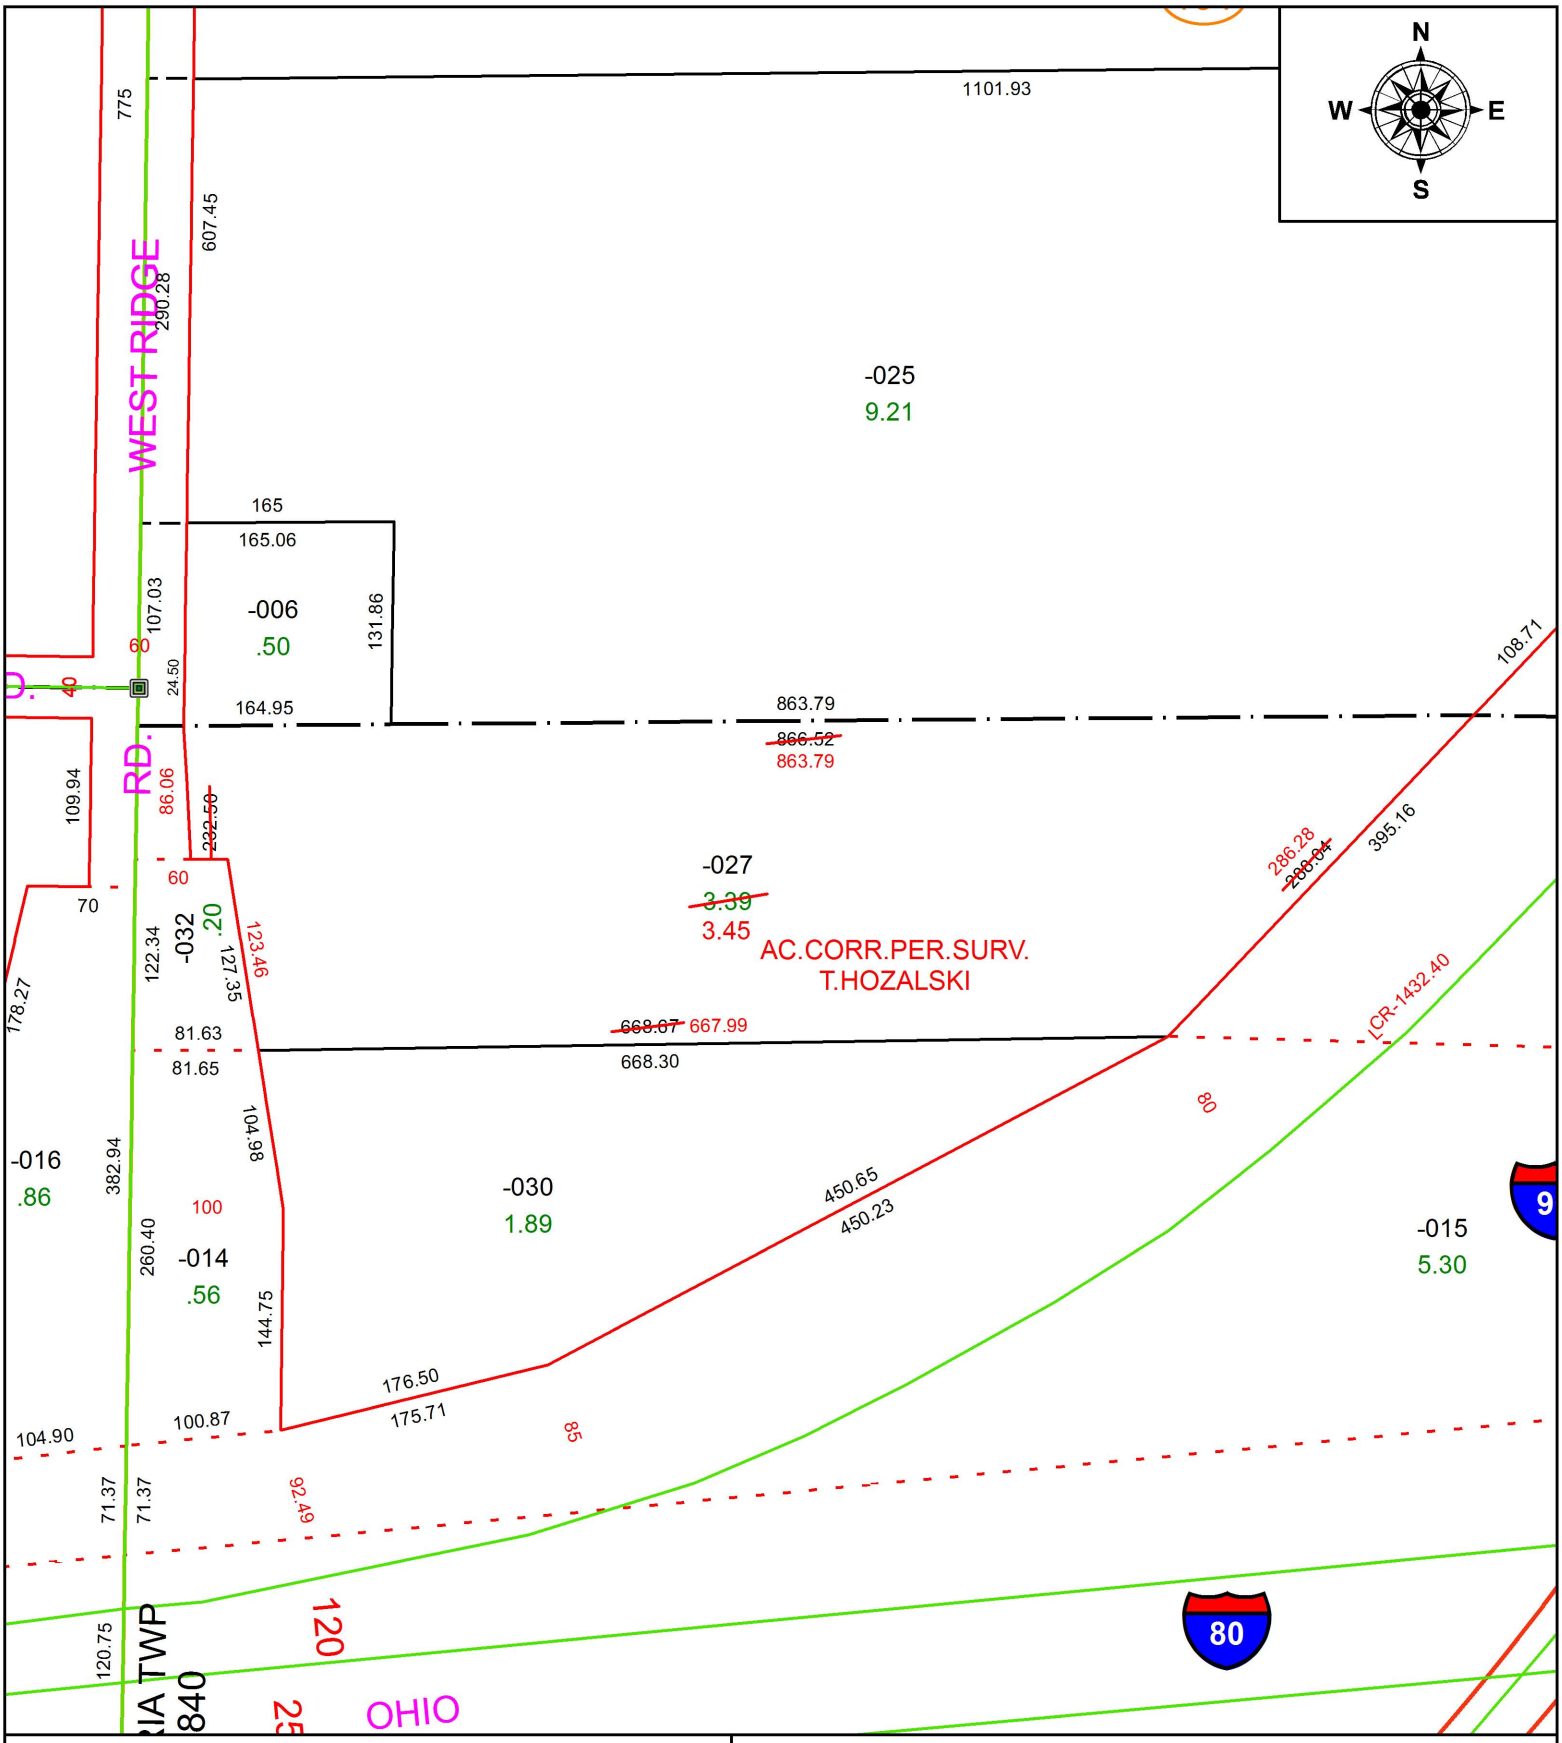

SPLITS/DEEDS PROCESSED

LORAIN COUNTY TAX MAP DEPARTMENT
226 MIDDLE AVE. ELYRIA, OH

SURVEYED BY: TIMOTHY D. HOZALSKI
CLOSURE: 1:809,643
MAP PAGE(S): 6-24-048
APPOVED BY: RRM **DATE:** 10-29-19
SCALE: 1" = 125 **PRIOR INSTRUMENT:** 20180679533