PARENT PARCEL: 12-00-088-000-013
CHILD PARCEL: 12-00-088-000-078 THRU -082
STARTING POINT: INTERSECTION OF C/L OF STATION RD. AND C/L OF CAPEL RD.

20-04216

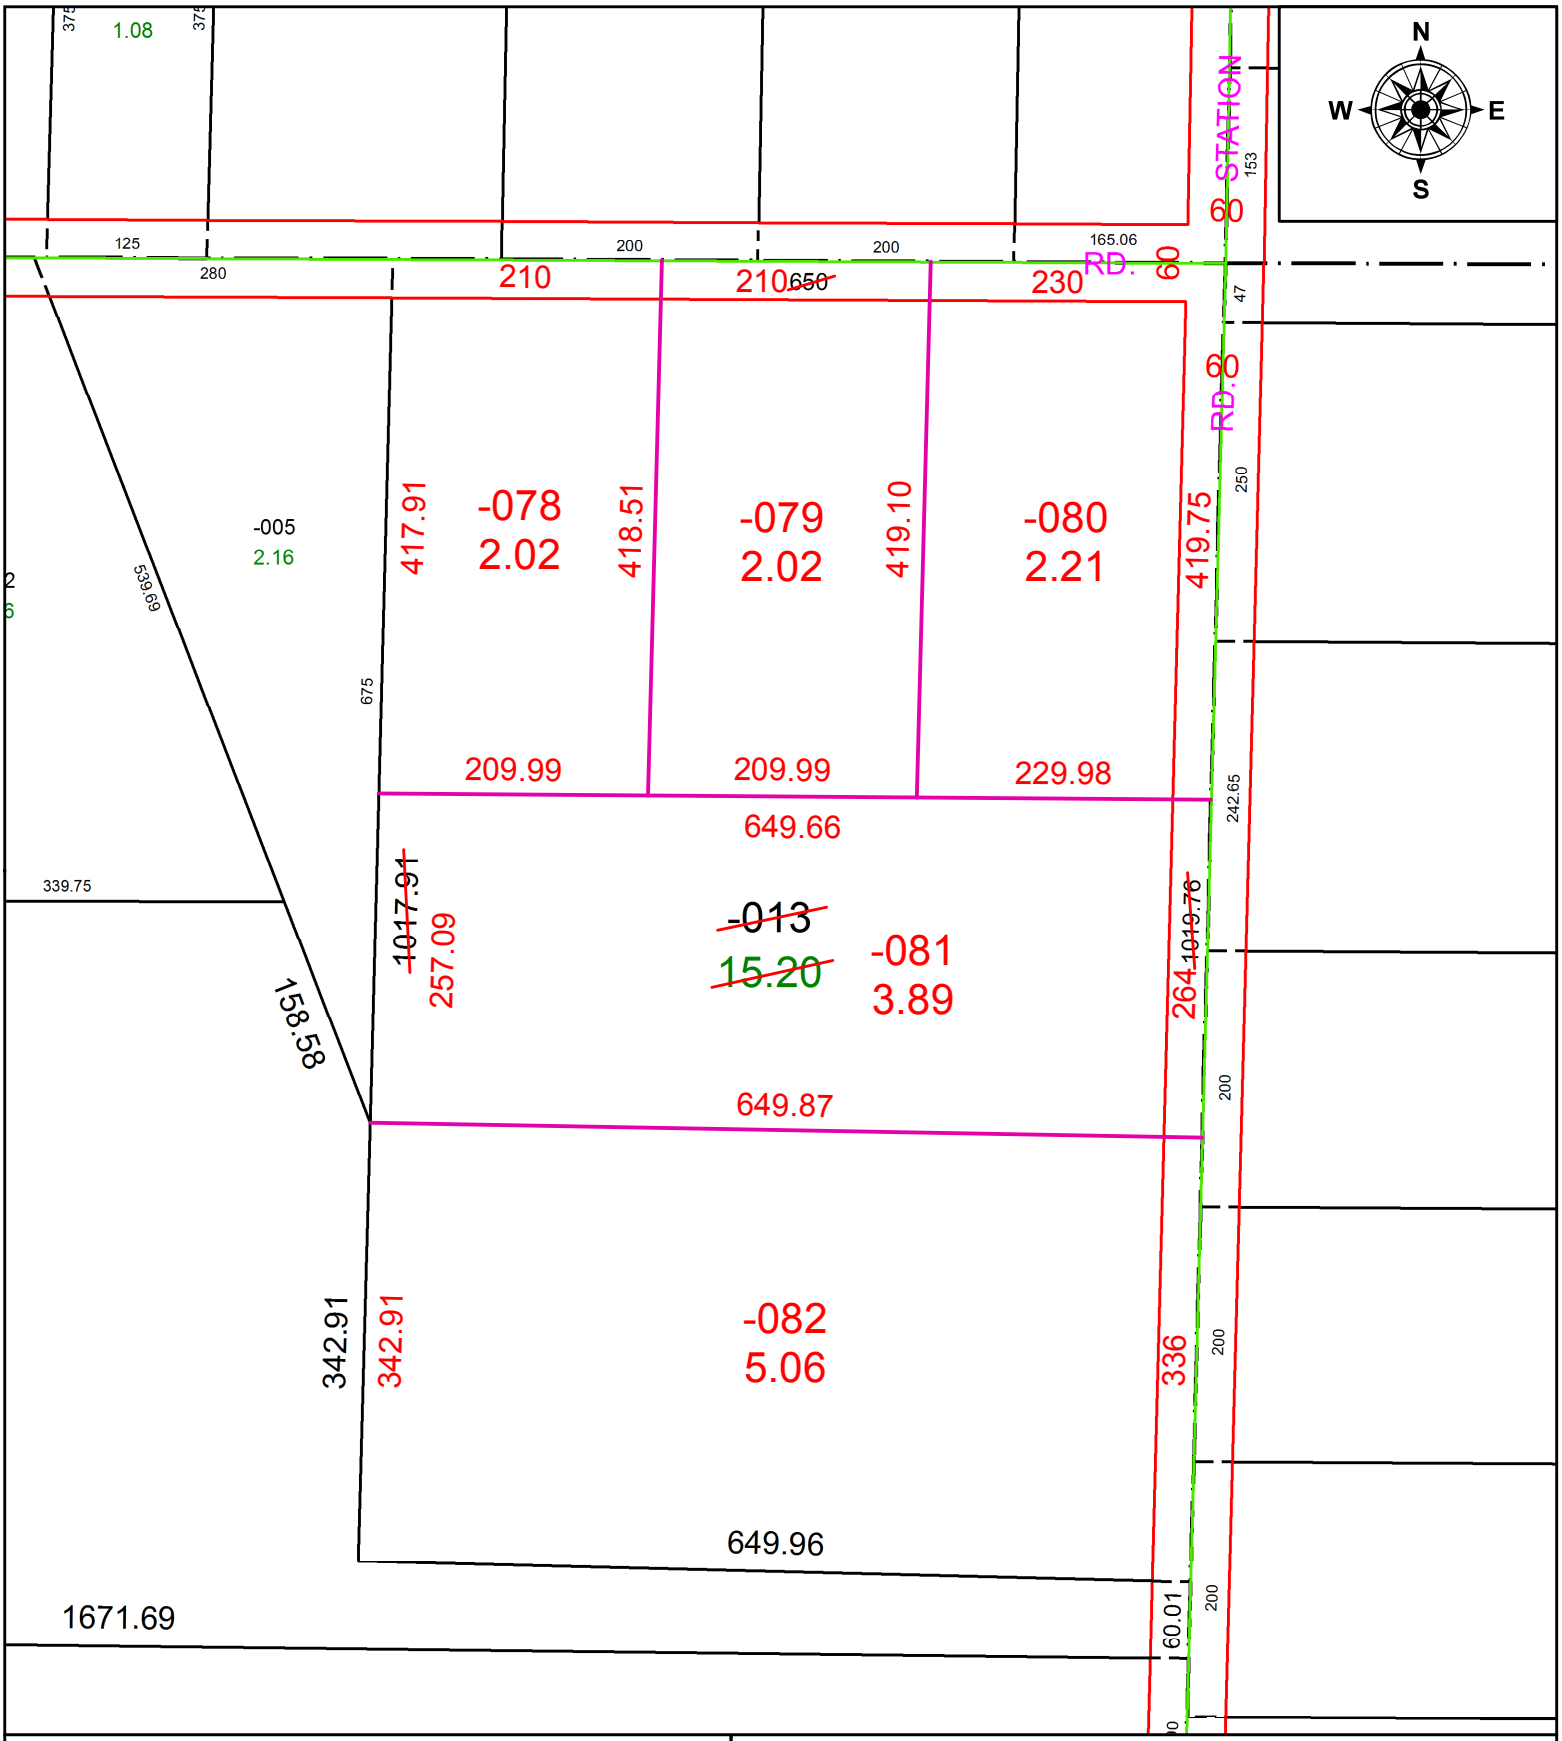

SPLITS/DEEDS PROCESSED
LORAIN COUNTY TAX MAP DEPARTMENT
226 MIDDLE AVE. ELYRIA, OH

SURVEYED BY: THOMAS M. SNEZEK
CLOSURE: 1:268,298
MAP PAGE(S): 12-00-088
APPOVED BY: RRM **DATE:** 11-17-20
SCALE: 1" = 150 **PRIOR INSTRUMENT:** 20190717844