PARENT PARCEL: 03-00-113-106-054

CHILD PARCEL: 03-00-113-106-061 & -062

STARTING POINT: S/L 242 & S/L 243

17-04217-U

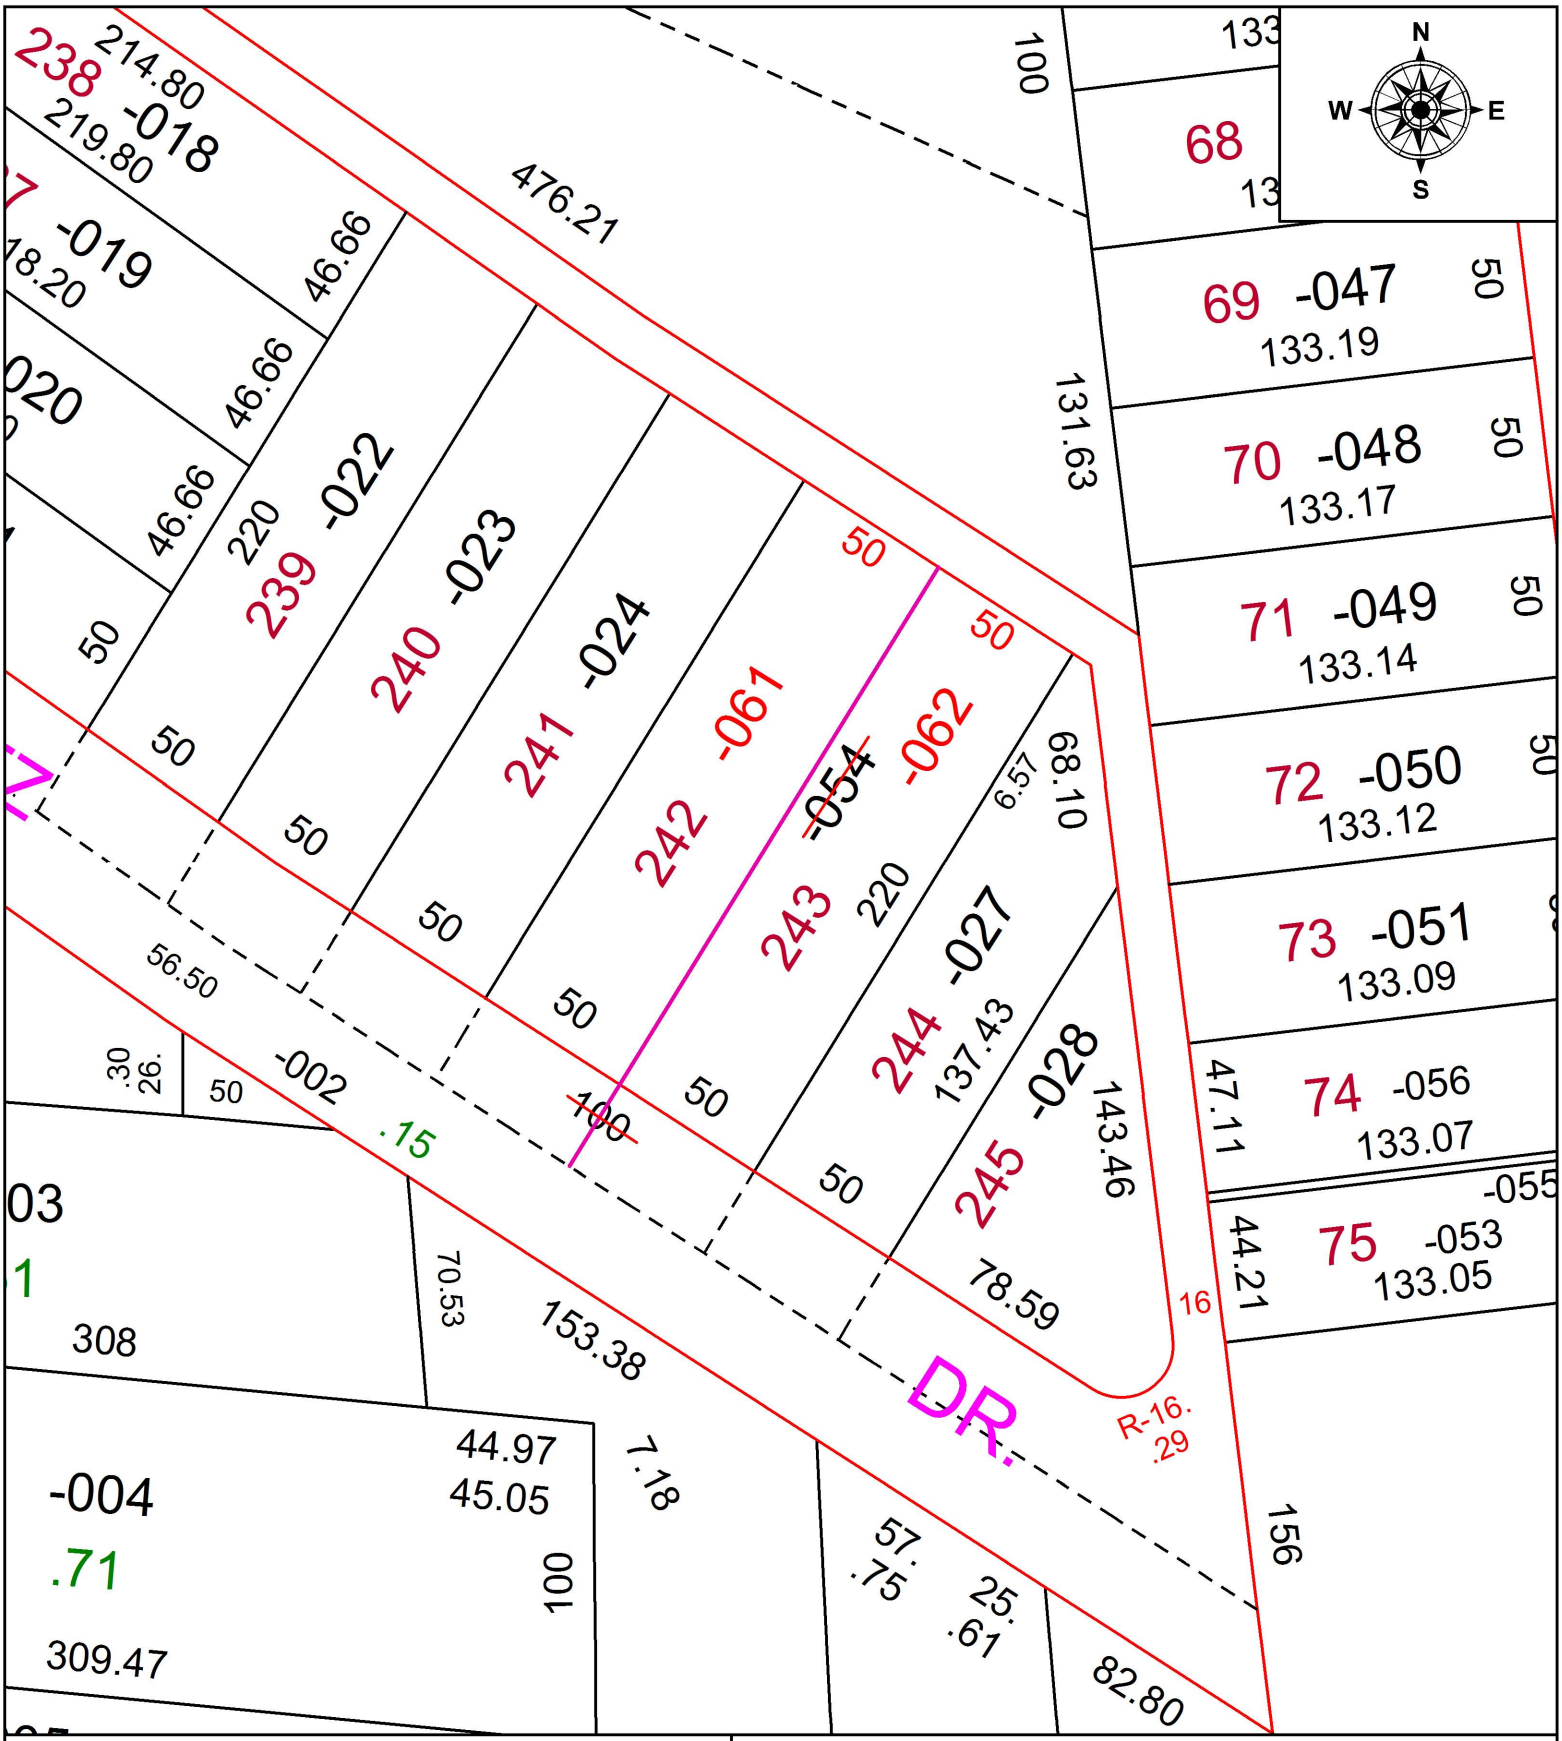

SPLITS/DEEDS PROCESSED

LORAIN COUNTY TAX MAP DEPARTMENT
226 MIDDLE AVE. ELYRIA, OH

SURVEYED BY: NA
CLOSURE: NA
MAP PAGE(S): 03-00-113
APPOVED BY: TJS **DATE:** 11/1/19
SCALE: 1" = 60' **PRIOR INSTRUMENT:** 2015-0538706