PARENT PARCEL: 01-00-021-000-055

CHILD PARCEL: 01-00-021-000-061, -062

STARTING POINT: INTERSECTION OF C/L OF CLAUS RD. AND EAST LINE OF O.L.21

20-04221

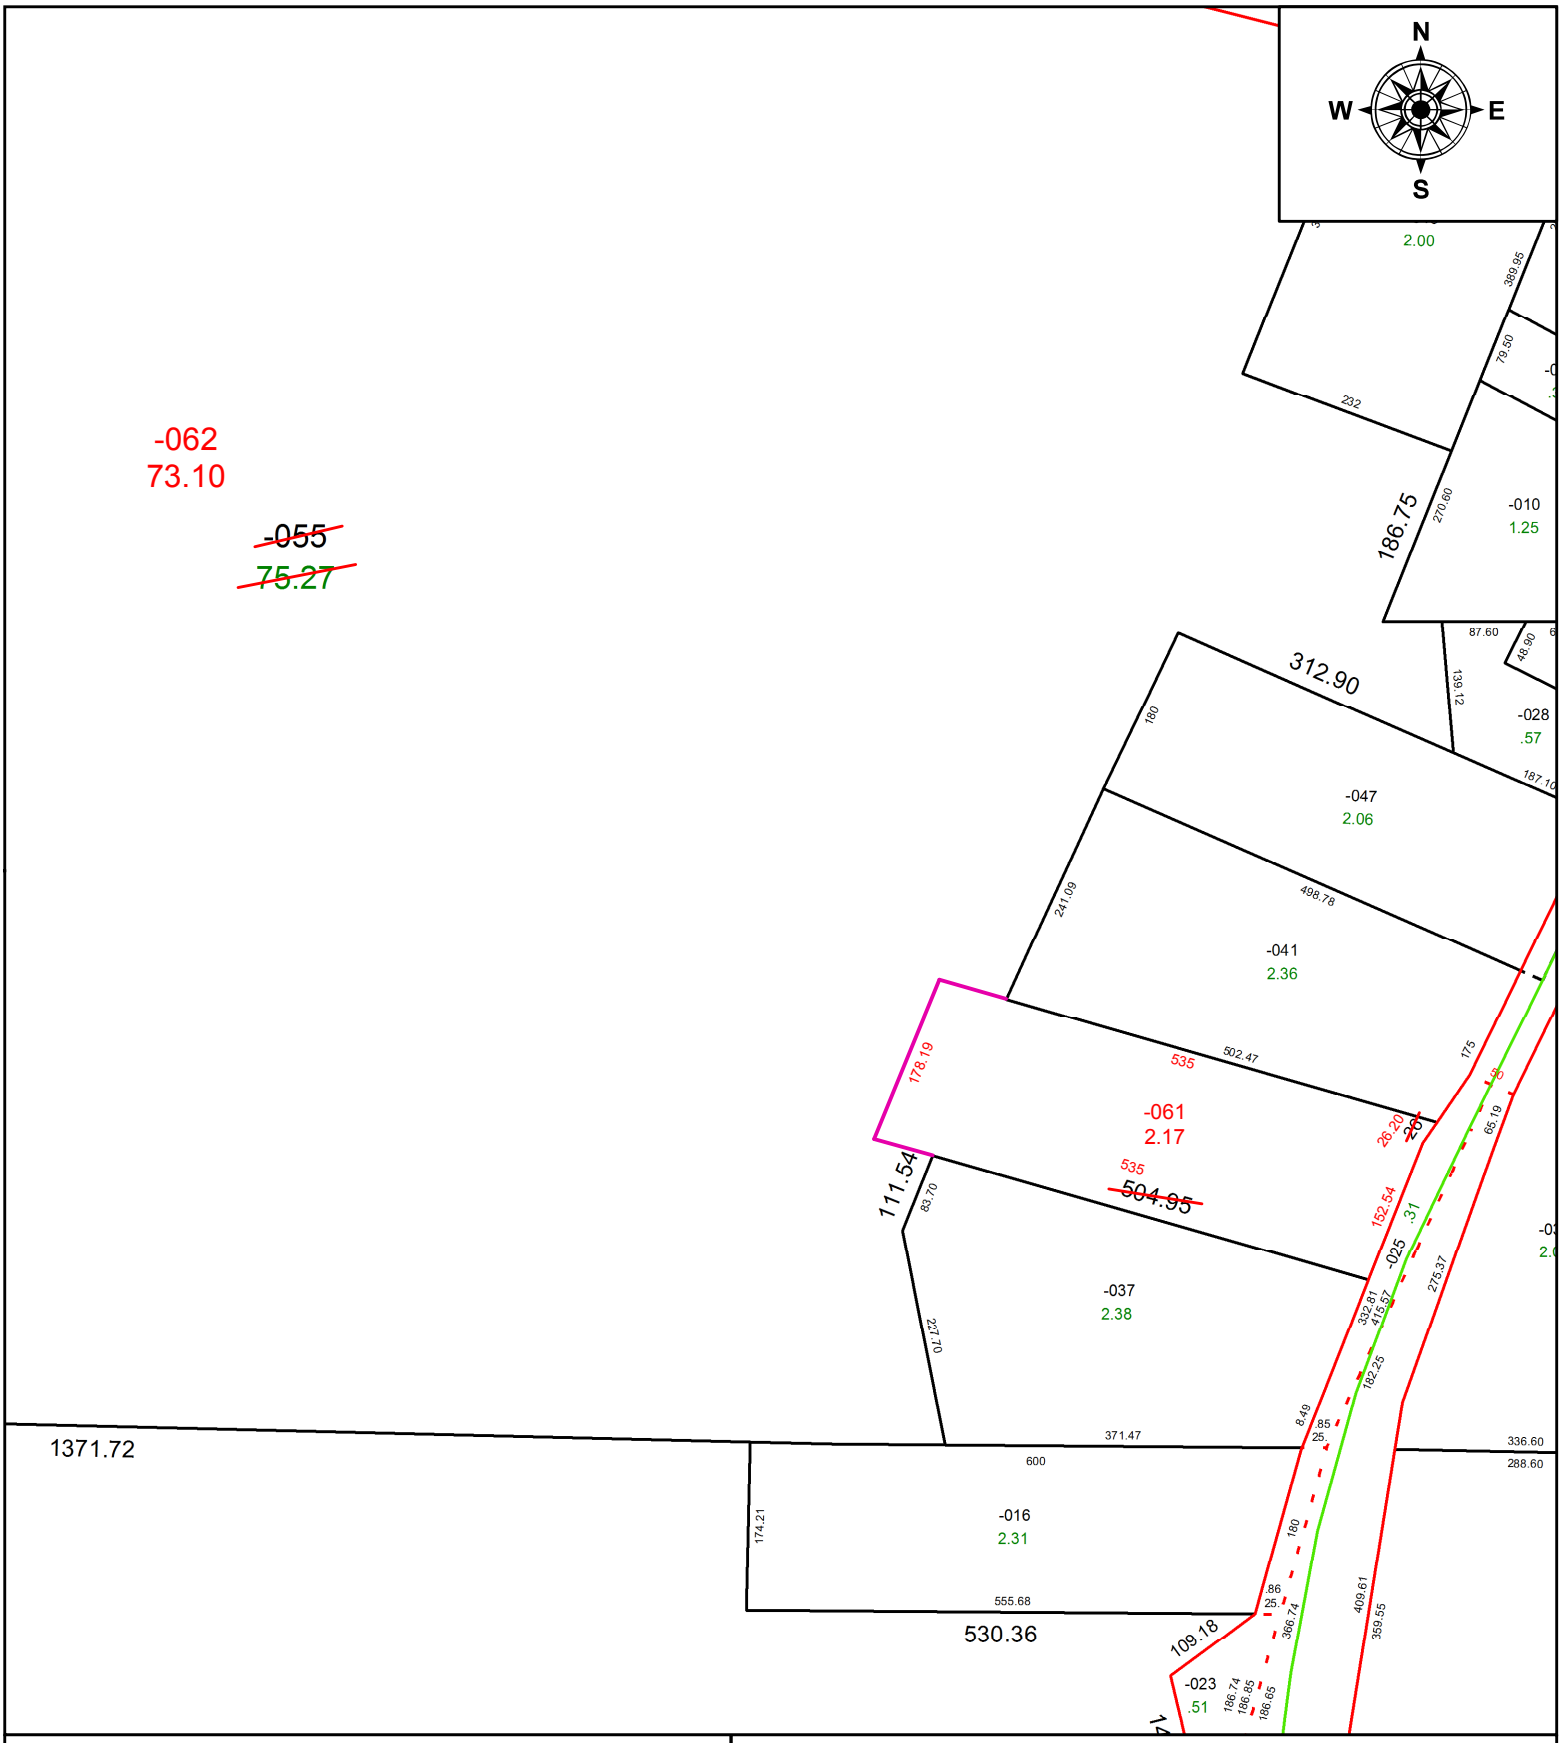

SPLITS/DEEDS PROCESSED

LORAIN COUNTY TAX MAP DEPARTMENT
226 MIDDLE AVE. ELYRIA, OH

SURVEYED BY: THOMAS A. SIMON
CLOSURE: 1:124,404
MAP PAGE(S): 1-00-021
APPOVED BY: RRM **DATE:** 12-7-20
SCALE: 1" = 200 **PRIOR INSTRUMENT:** OR 1060/796