PARENT PARCEL: 07-00-016-112-050, 07-00-017-130-012

CHILD PARCEL: 07-00-016-112-050, 07-00-017-130-032, -033

STARTING POINT: INTERSECTION OF C/L OF EMERALD ST. AND C/L OF CENTER RIDGE RD.

20-04224

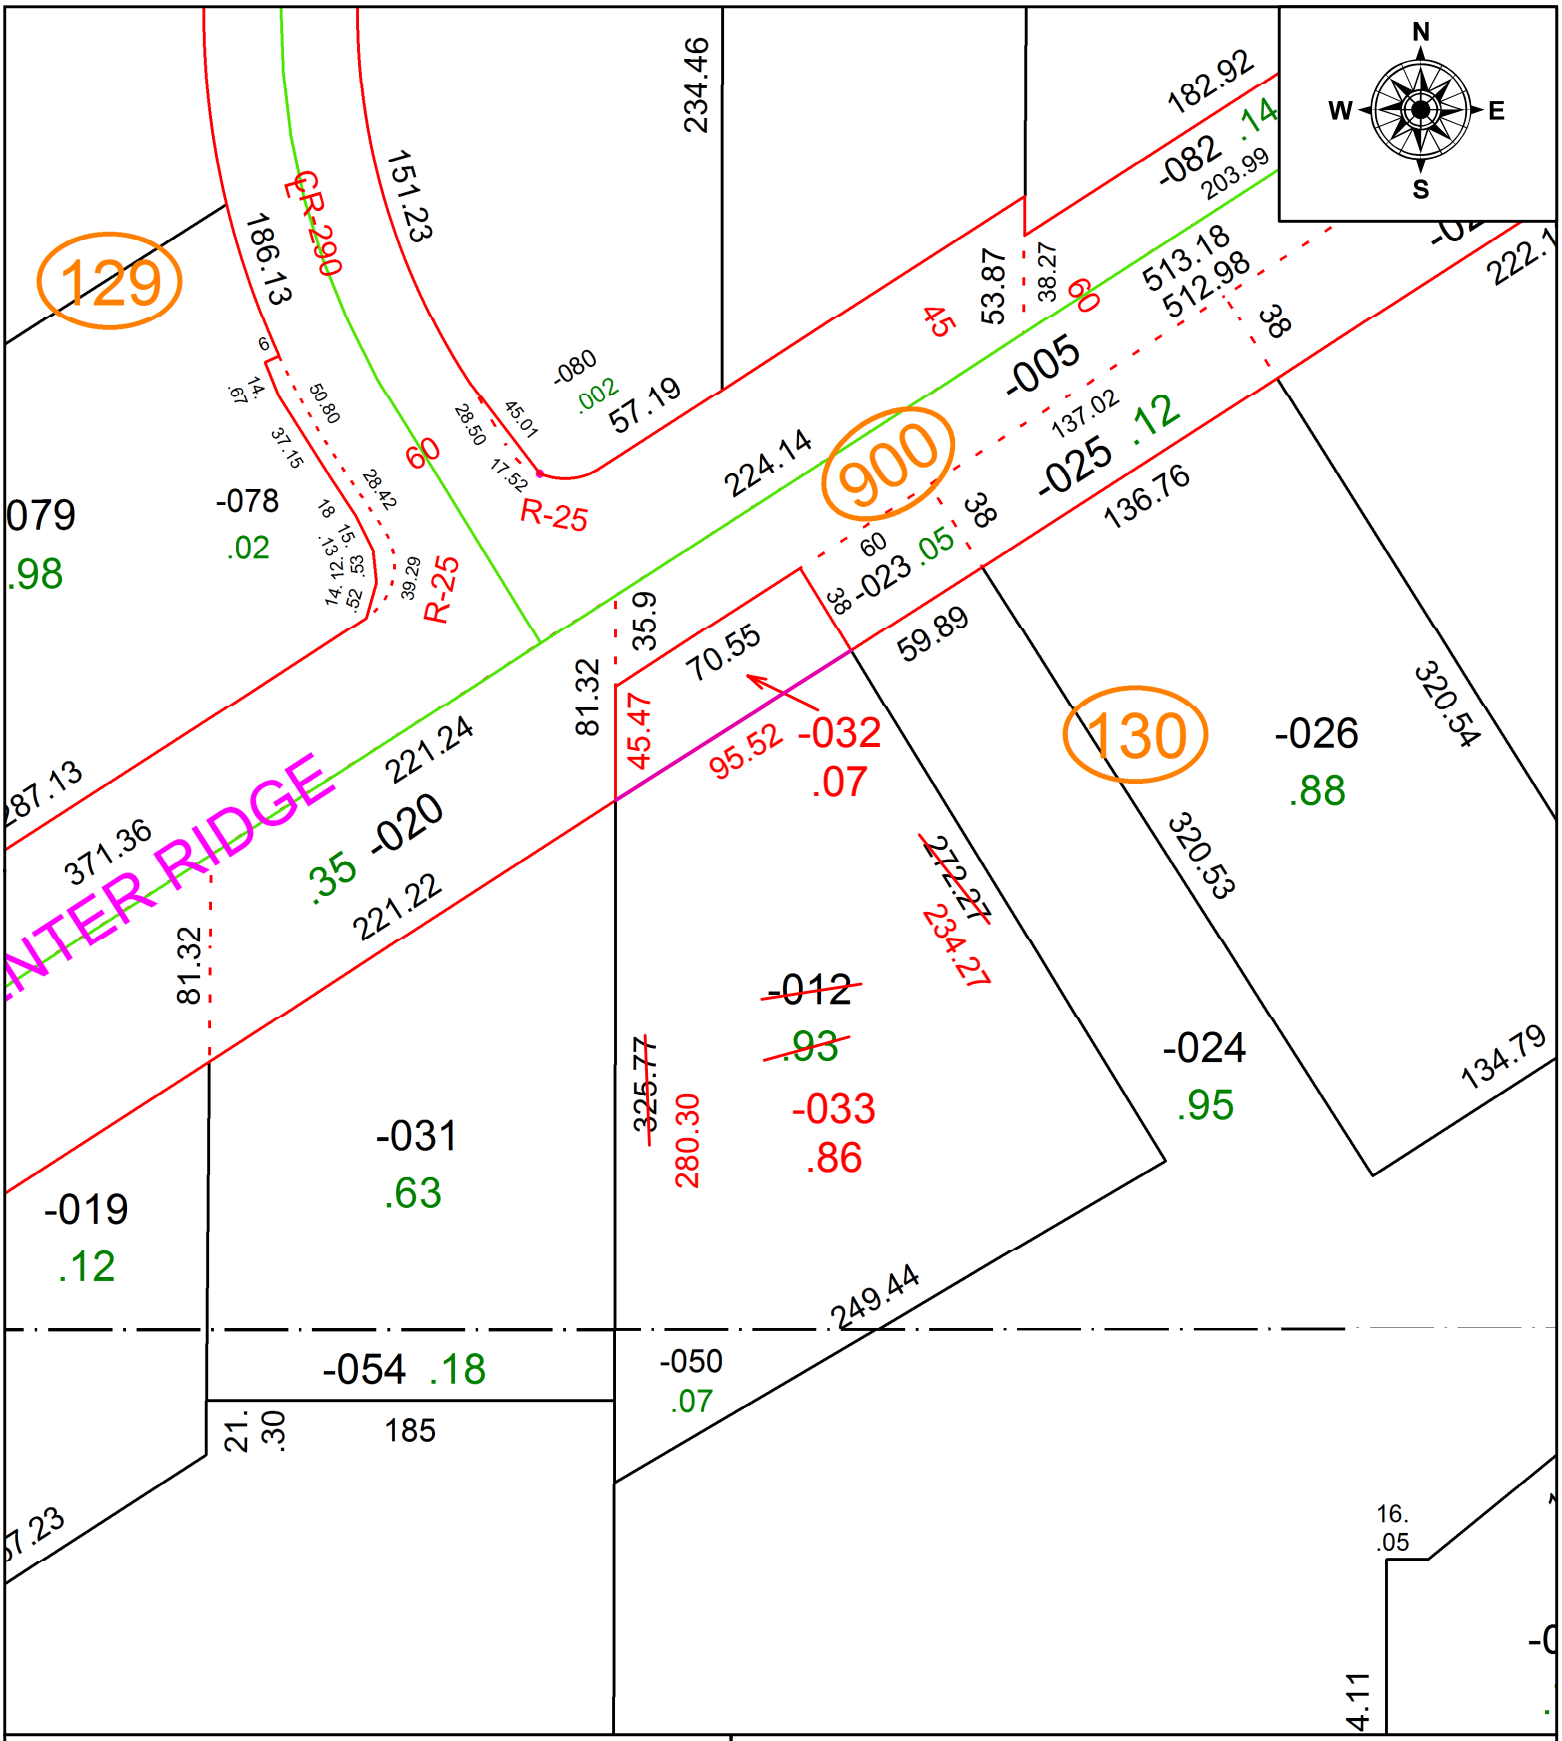

SPLITS/DEEDS PROCESSED

LORAIN COUNTY TAX MAP DEPARTMENT
226 MIDDLE AVE. ELYRIA, OH

SURVEYED BY: EHTESHAM M. SUHAIL
CLOSURE: 1:142,957
MAP PAGE(S): 7-00-017
APPOVED BY: RRM **DATE:** 12-11-20
SCALE: 1" = 75 **PRIOR INSTRUMENT:** 20200782928