PARENT PARCEL: 04-00-022-102-158

CHILD PARCEL: 04-00-022-102-159, -160

STARTING POINT: INTERSECTION OF WEST LINE OF NAGEL RD. AND C/L OF MIDDLETON RD.

20-04225

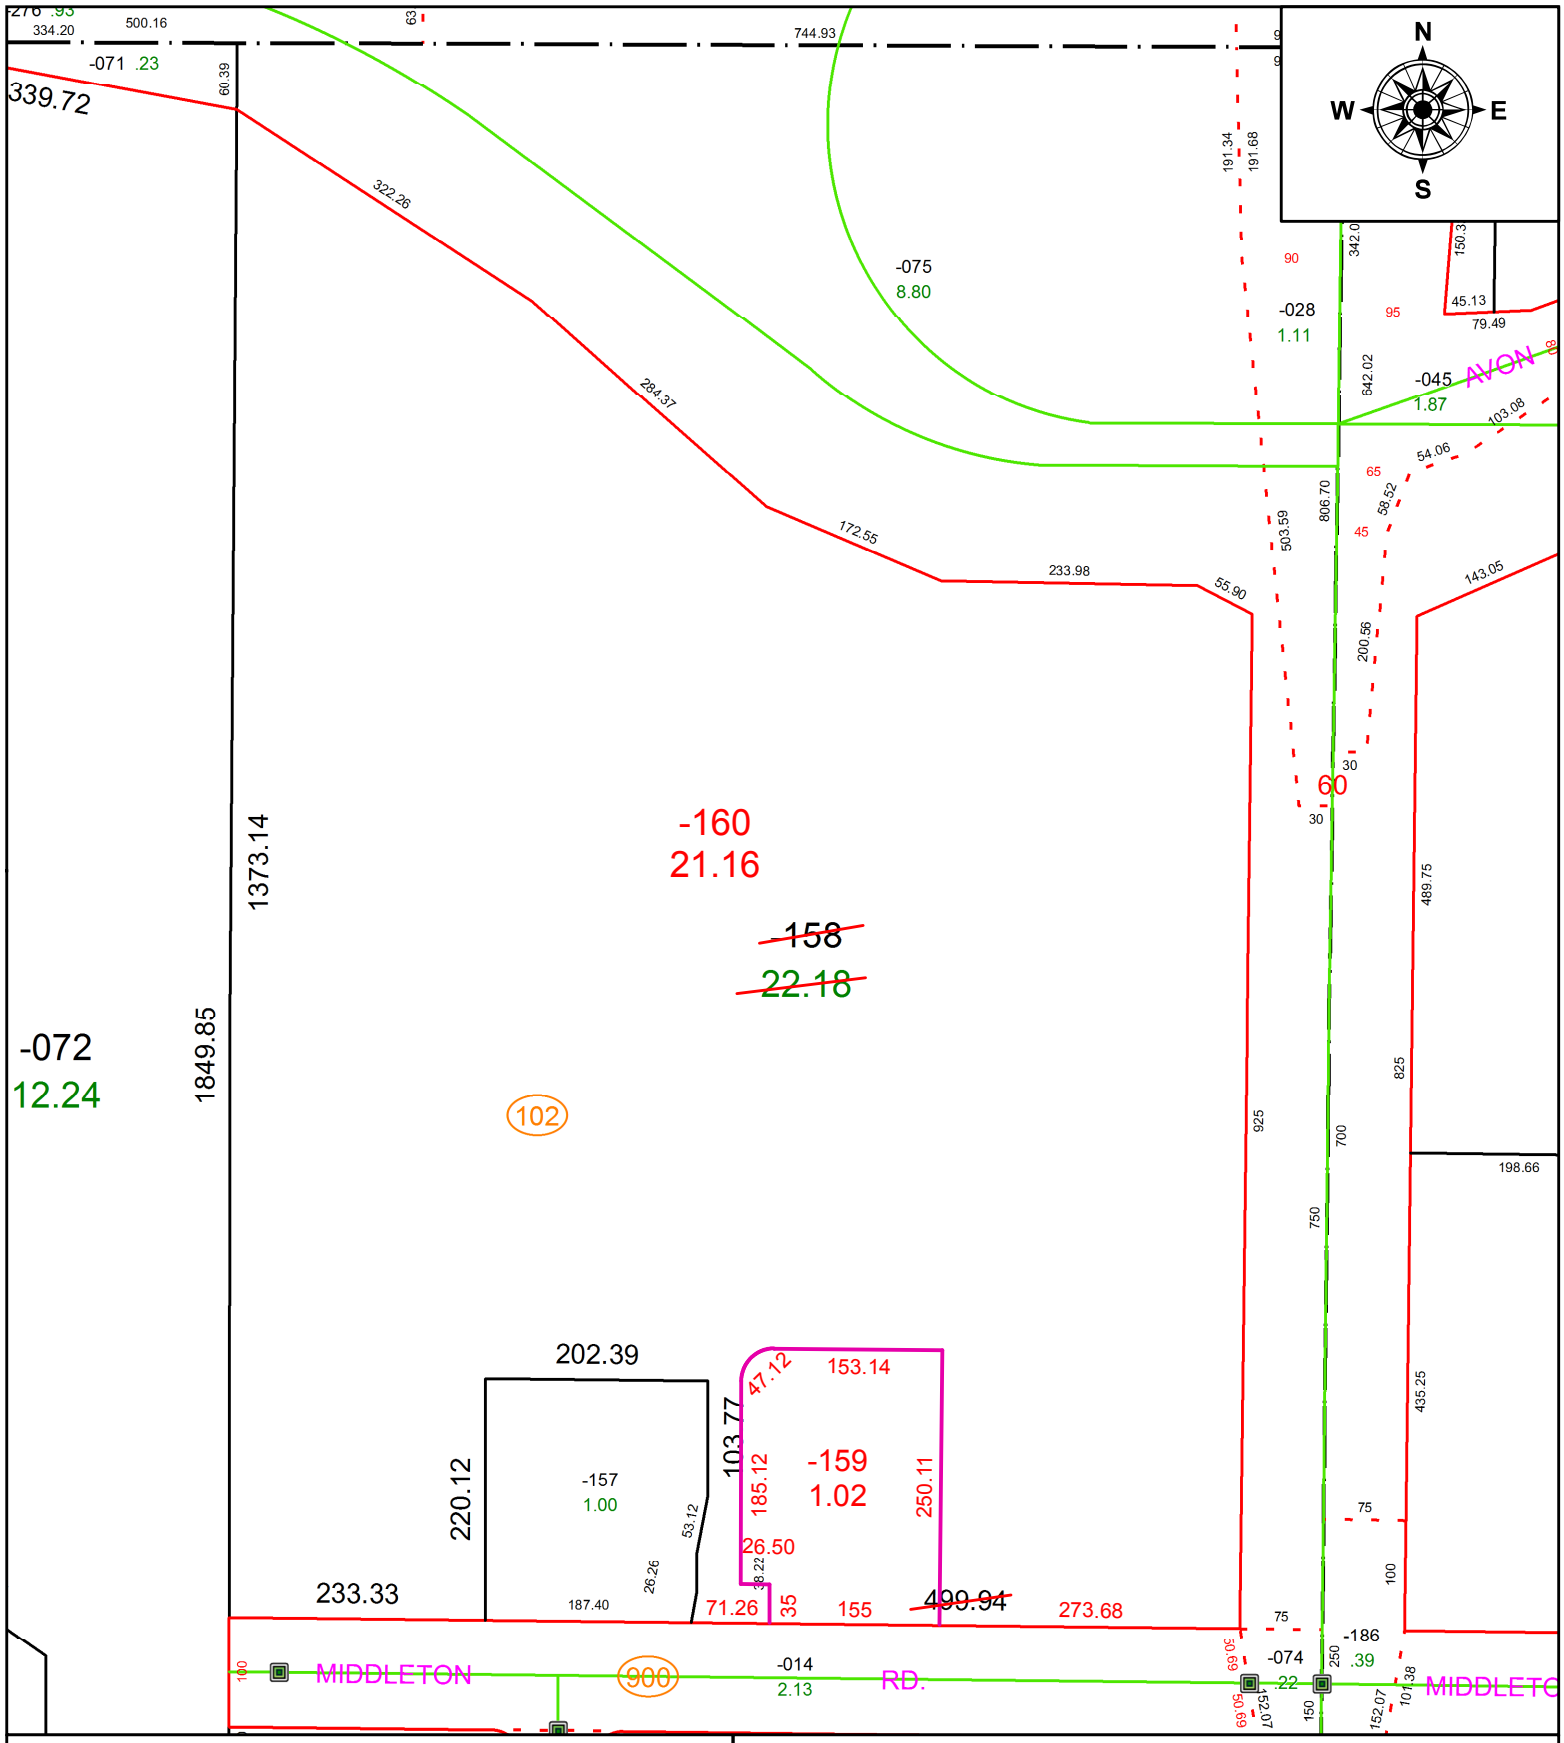

SPLITS/DEEDS PROCESSED

LORAIN COUNTY TAX MAP DEPARTMENT
226 MIDDLE AVE. ELYRIA, OH

SURVEYED BY: ERIC S. JACKSON
CLOSURE: 1:131,437
MAP PAGE(S): 4-00-022
APPOVED BY: RRM **DATE:** 12-11-20
SCALE: 1" = 175 **PRIOR INSTRUMENT:** 20200792055