PARENT PARCEL: 07-00-011-103-085
CHILD PARCEL: 07-00-011-103-193, -194
STARTING POINT: INTERSECTION OF C/L OF LORAIN RD. AND C/L OF BAGLEY RD.

19-04226-U

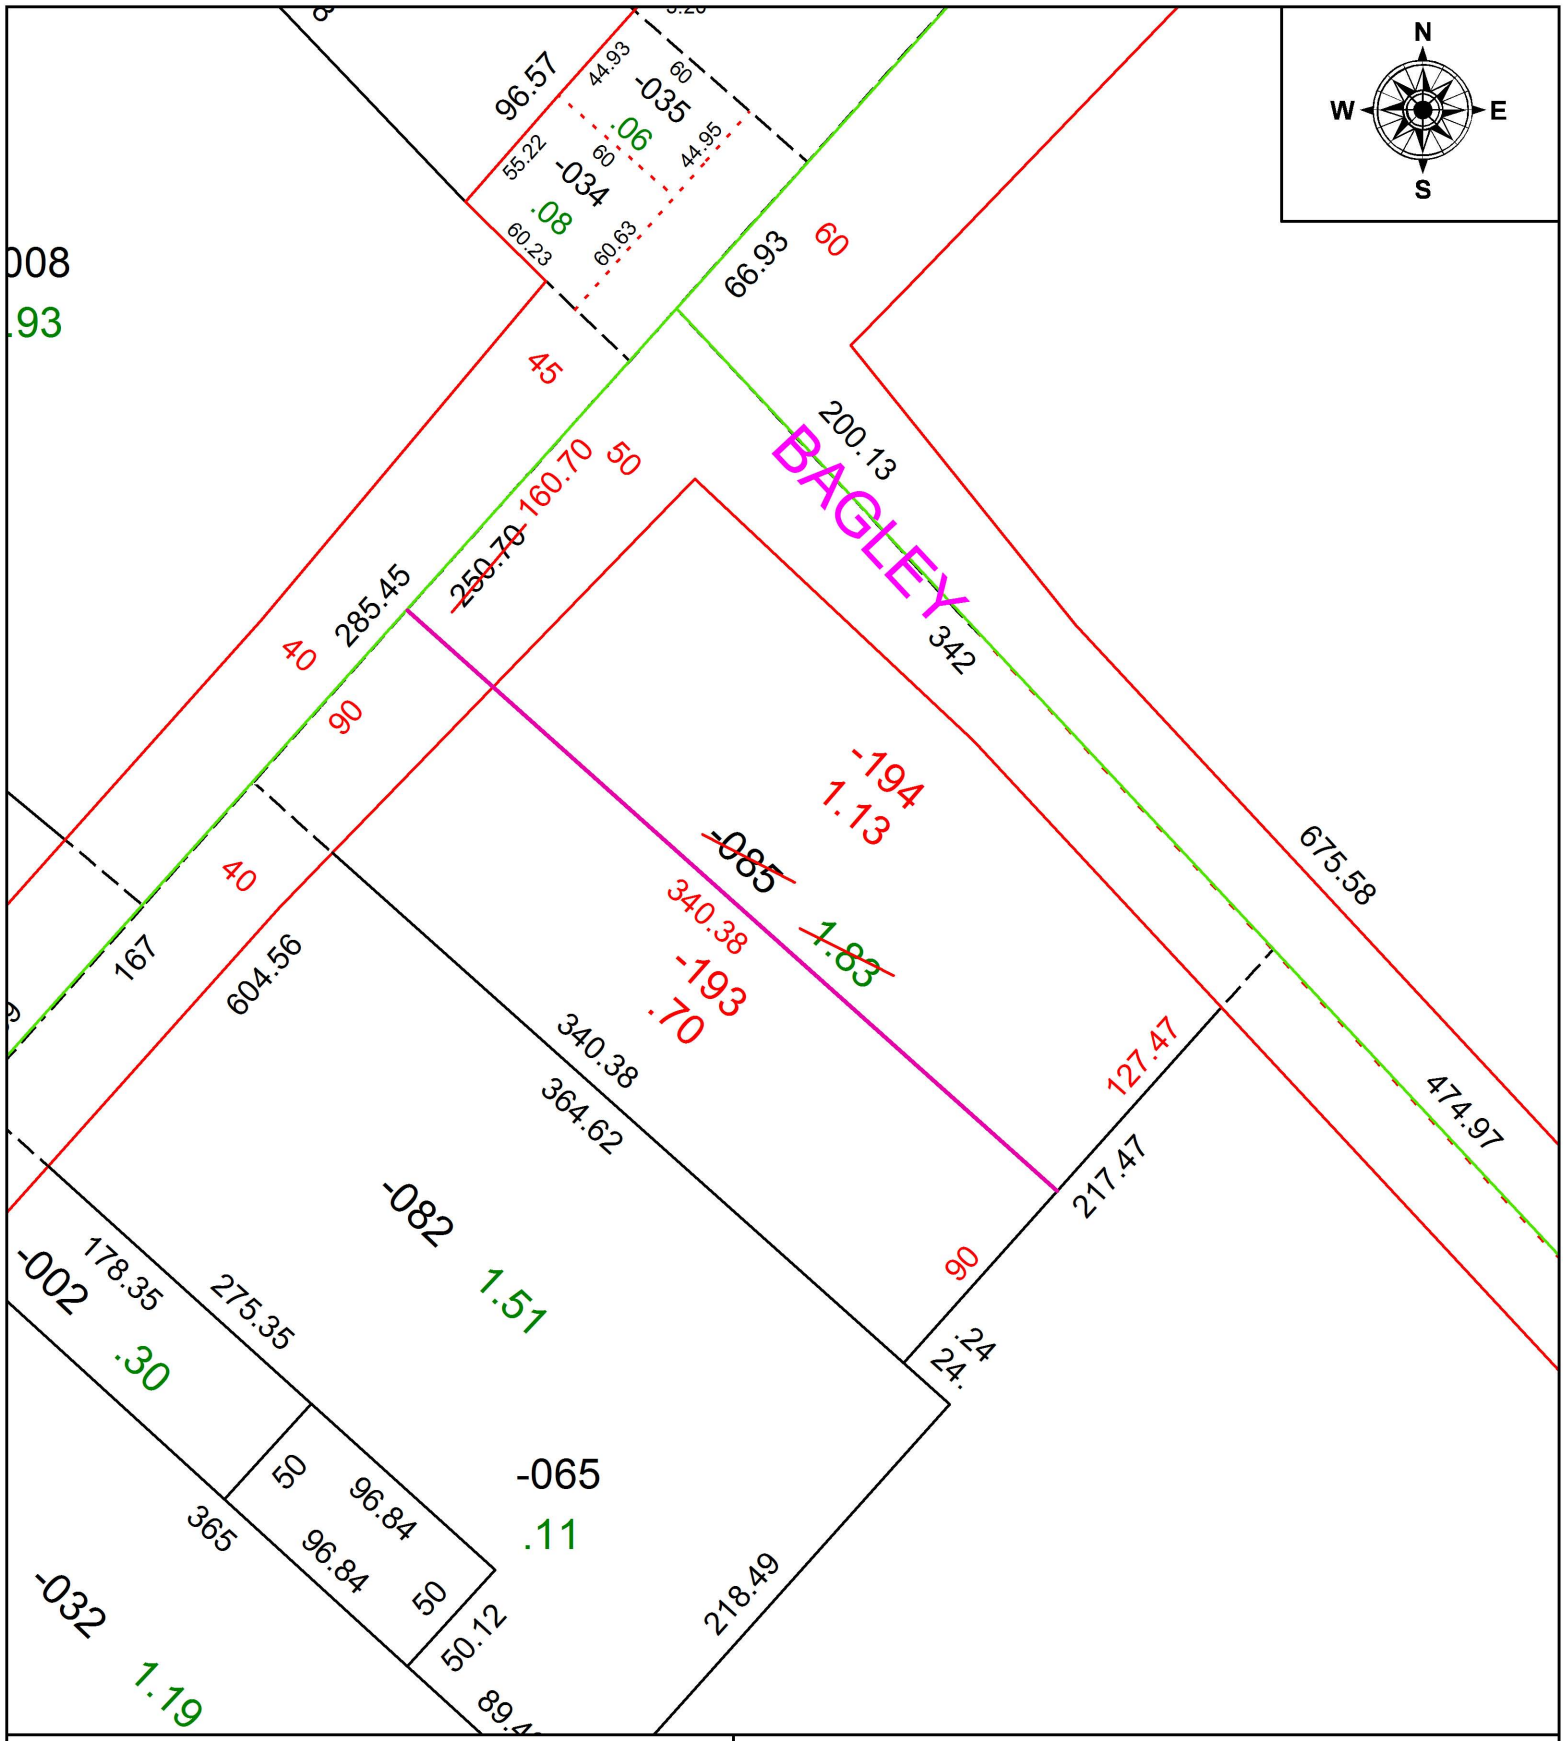

SPLITS/DEEDS PROCESSED
LORAIN COUNTY TAX MAP DEPARTMENT
226 MIDDLE AVE. ELYRIA, OH

SURVEYED BY: KS & ASSOC.
CLOSURE: 1:283,032
MAP PAGE(S): 7-00-011
APPOVED BY: RRM **DATE:** 11-25-19
SCALE: 1" = 75 **PRIOR INSTRUMENT:** 20160605082