PARENT PARCEL: AC. CORR. 03-00-032-102-012 PER DV 523/169
CHILD PARCEL: ADD TO DUP. 03-00-032-102-017 PER DV 417/392 & DV 90/601
STARTING POINT: CL OF LAKE RD. & EAST LINE OF O.L. 32

19-04230-A

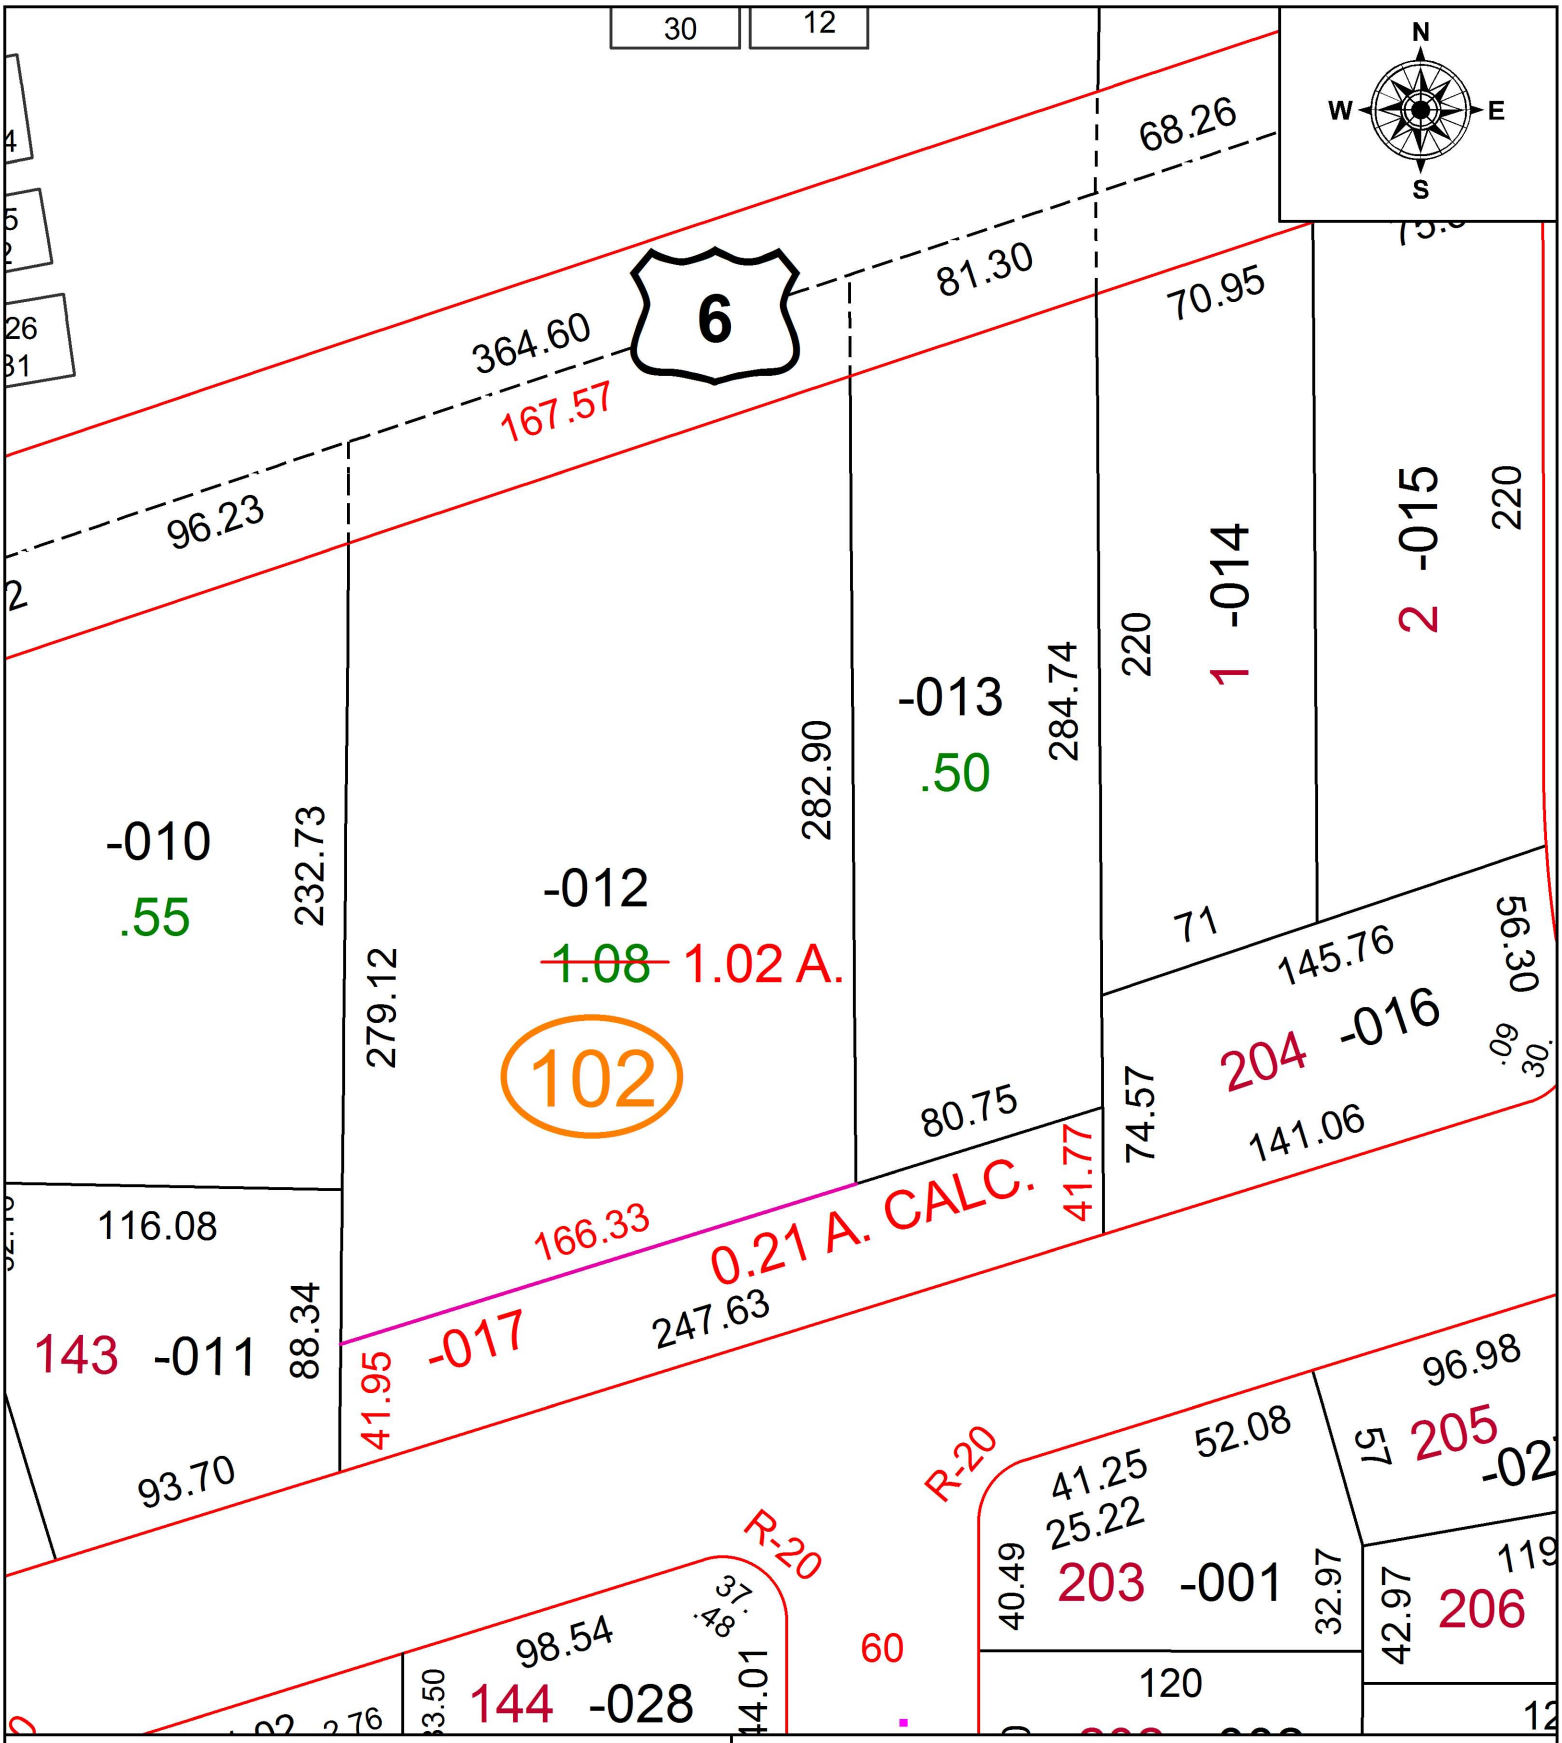

SPLITS/DEEDS PROCESSED
LORAIN COUNTY TAX MAP DEPARTMENT
226 MIDDLE AVE. ELYRIA, OH

SURVEYED BY: J.W. WARDEN
CLOSURE: 1: 33,000
MAP PAGE(S): 03-00-032
APPOVED BY: TJS **DATE:** 12/3/19
SCALE: 1" = 60' **PRIOR INSTRUMENT:** DV XXXX/XXXX