PARENT PARCEL: 01-00-021-000-049 & -056

CHILD PARCEL: 01-00-021-000-063 THRU -065

STARTING POINT: S.E. CORNER OF O.L. 21

20-04231

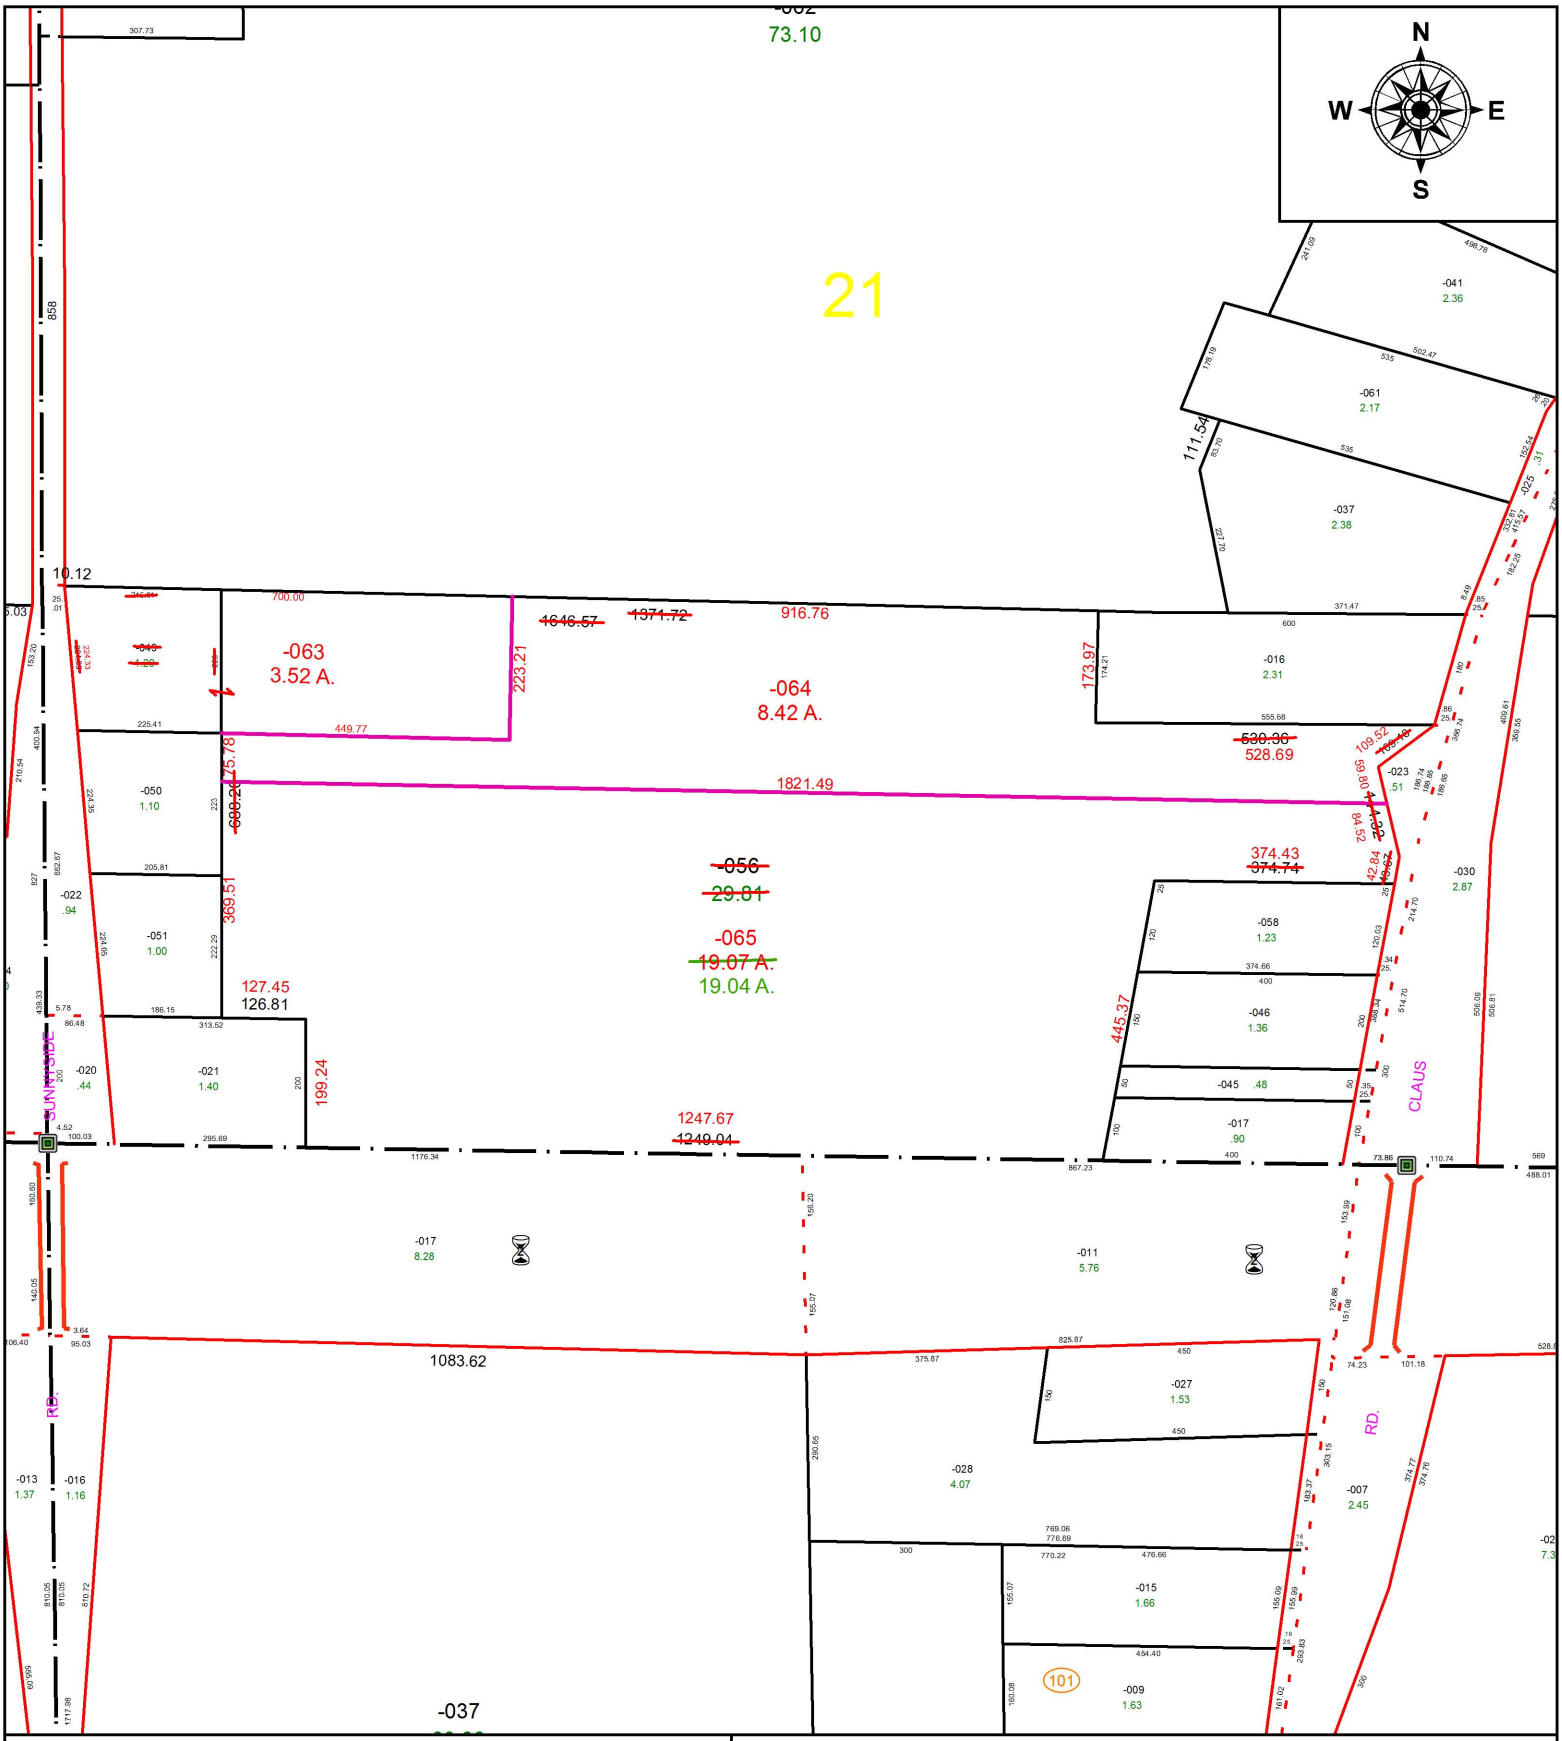

SPLITS/DEEDS PROCESSED

LORAIN COUNTY TAX MAP DEPARTMENT
226 MIDDLE AVE. ELYRIA, OH

SURVEYED BY: JOHN A. DECHANT JR.

CLOSURE: 1:1116790

MAP PAGE(S): 01-00-021

APPOVED BY: TJS **DATE:** 12/30/2020

SCALE: 1" = 300' **PRIOR INSTRUMENT:** 2018-0687208