PARENT PARCEL: 15-00-019-000-002
CHILD PARCEL: 15-00-019-000-017, -018, -019
STARTING POINT: SOUTHWEST CORNER OF LAND CONVEYED TO TRUSTEES OF LAGRANGE TOWNSHIP (DV 88/335)

21-04233

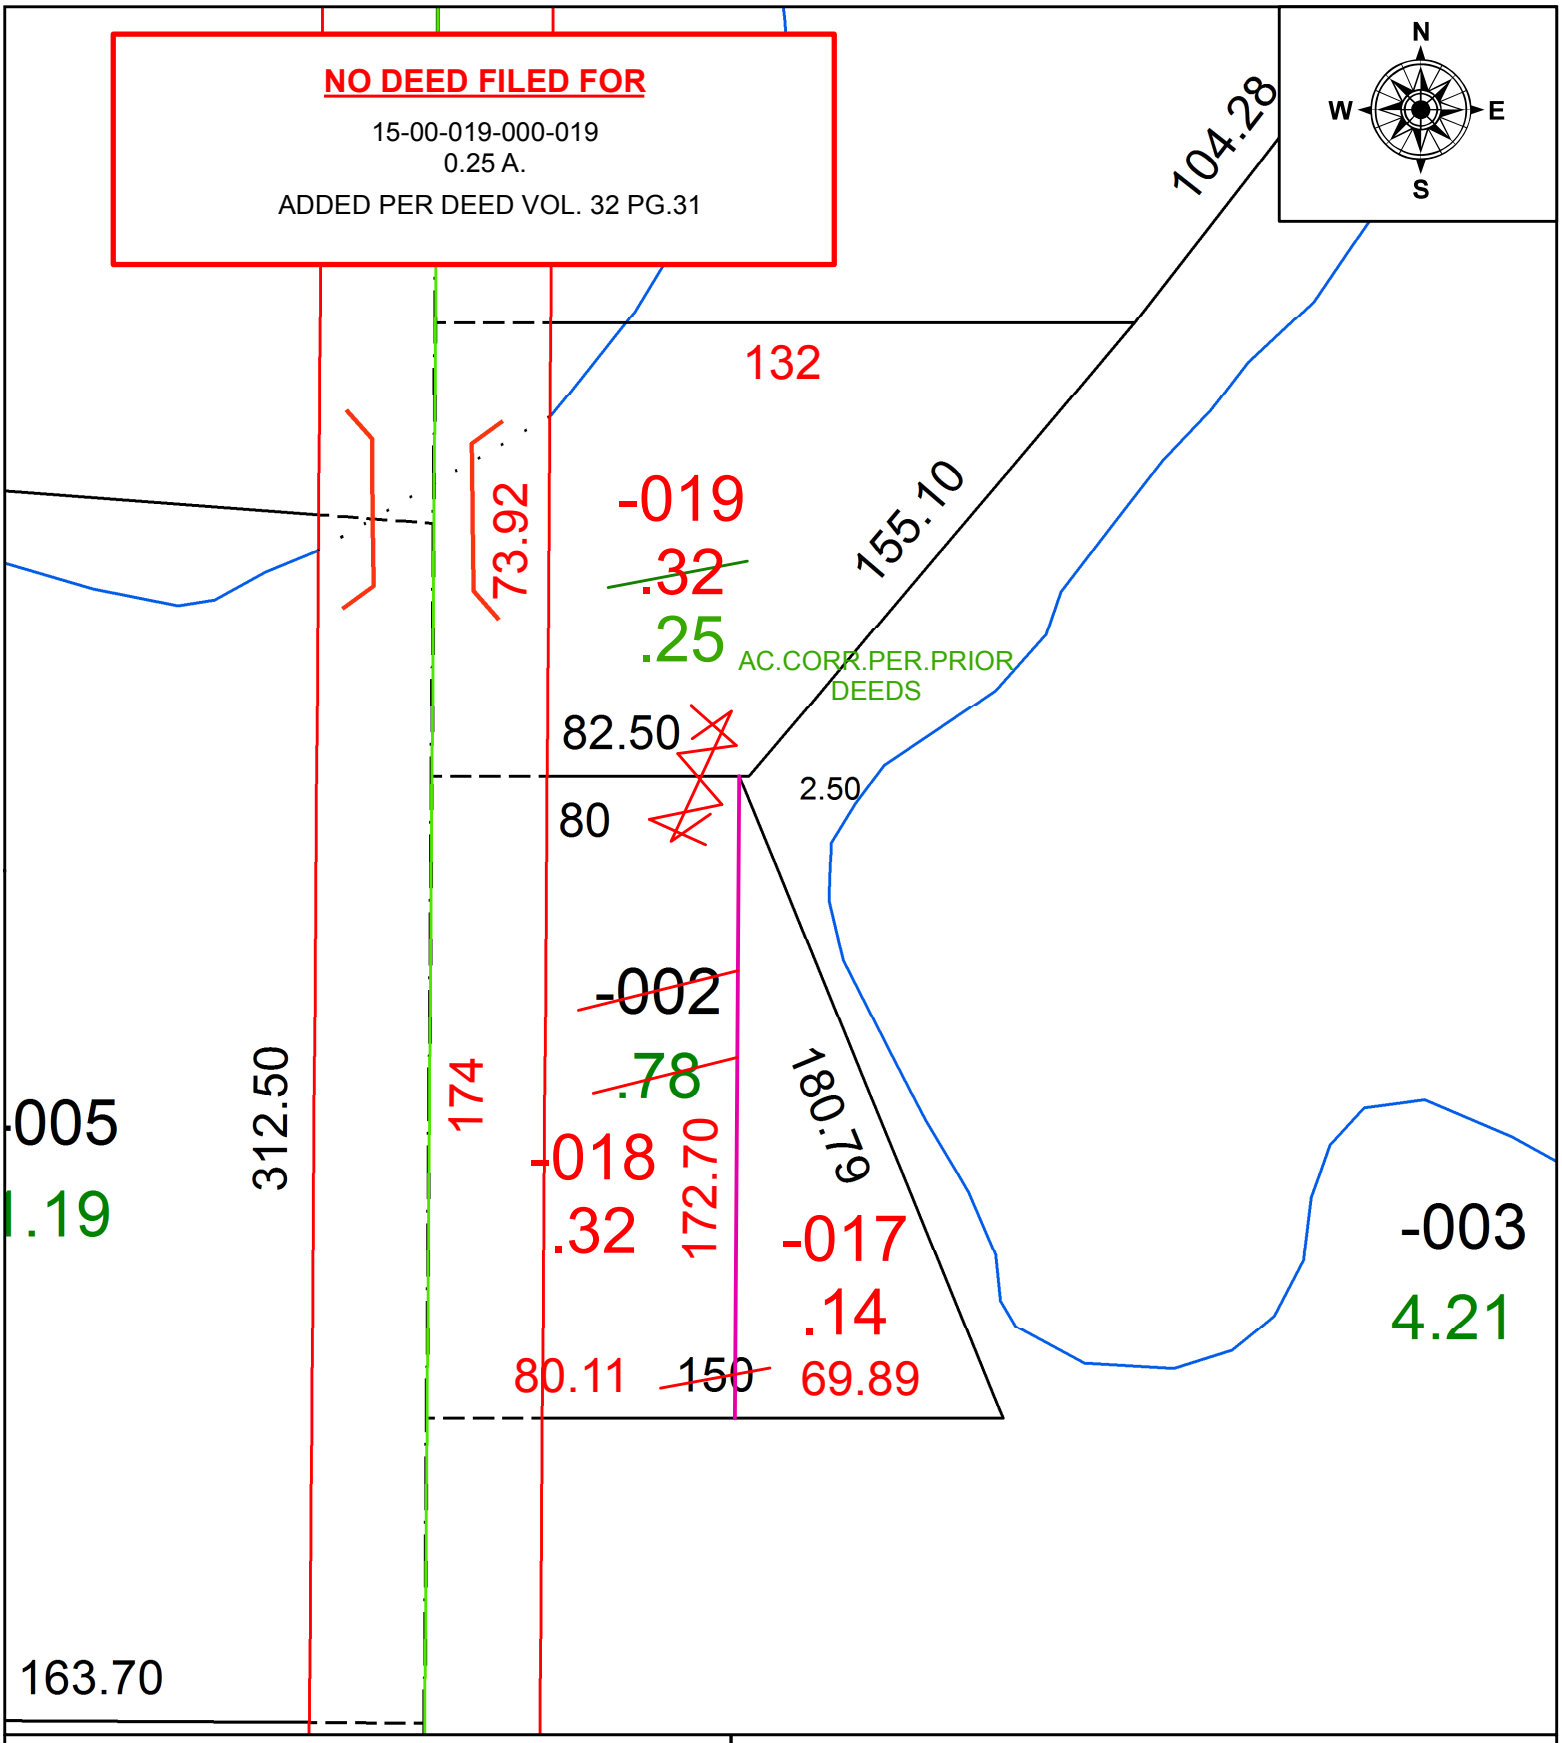

SPLITS/DEEDS PROCESSED
LORAIN COUNTY TAX MAP DEPARTMENT
226 MIDDLE AVE. ELYRIA, OH

SURVEYED BY: DAVID L. ELWELL
CLOSURE: 1: 70,975
MAP PAGE(S): 15-00-019
APPOVED BY: RRM **DATE:** 1-7-21
SCALE: 1" = 50 **PRIOR INSTRUMENT:** DV 88/335