PARENT PARCEL: 05-00-024-102-013, -048

CHILD PARCEL: 05-00-024-102-053

STARTING POINT: INTERSECTION OF SOUTH LINE OF PARK AVE. AND EAST LIN OF S. MAIN ST.

19-04234-C

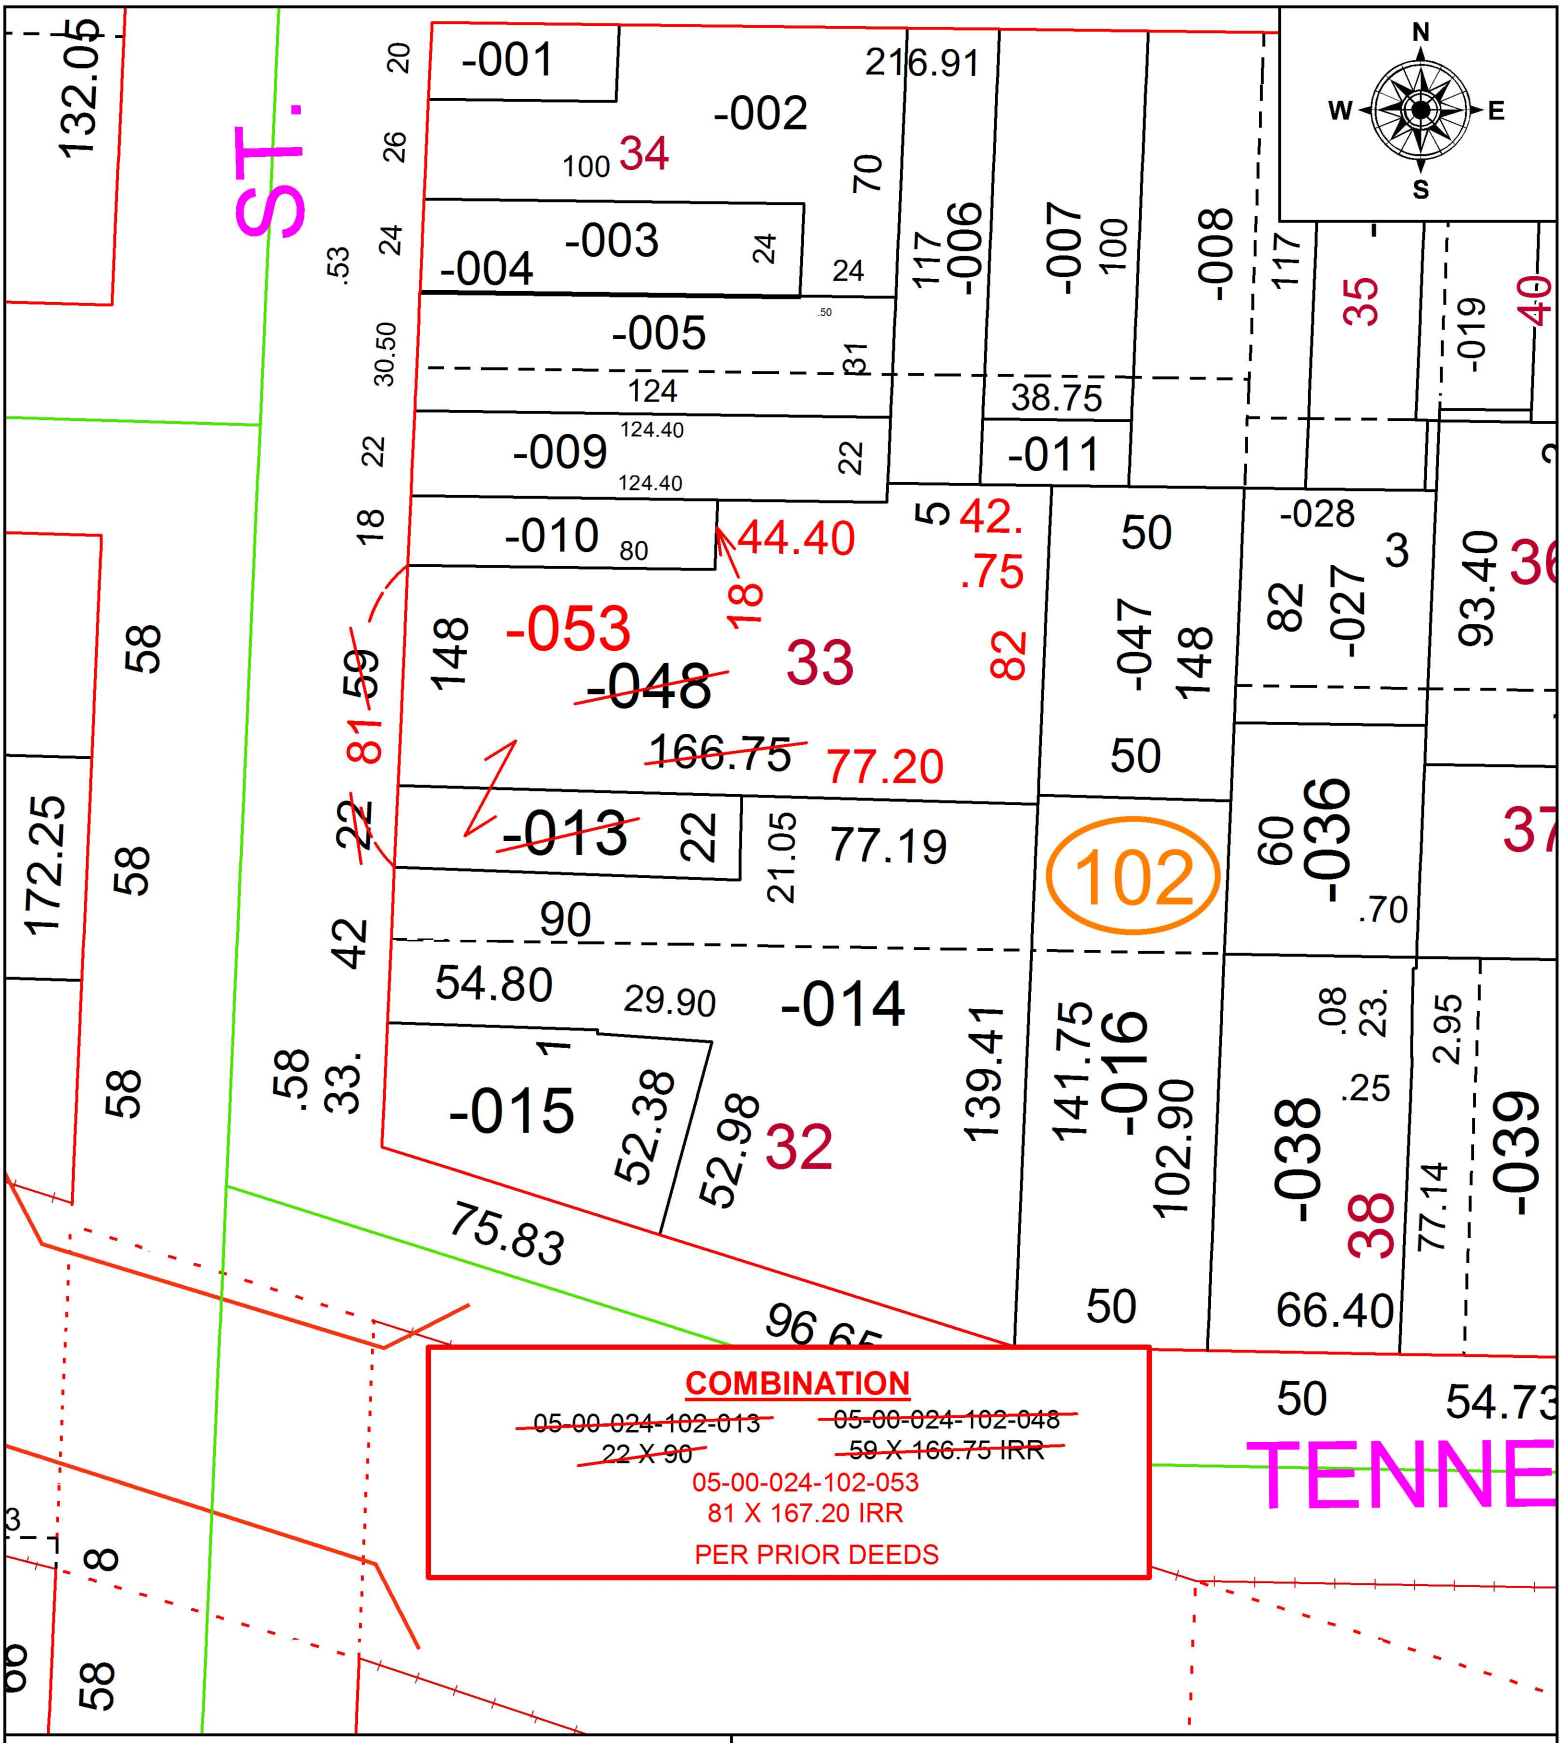

COMBINATION

~~05-00-024-102-013~~ ~~22 X 90~~

~~05-00-024-102-048~~ ~~59 X 166.75 IRR~~

05-00-024-102-053

81 X 167.20 IRR

PER PRIOR DEEDS

SPLITS/DEEDS PROCESSED

LORAIN COUNTY TAX MAP DEPARTMENT

226 MIDDLE AVE. ELYRIA, OH

SURVEYED BY: N/A

CLOSURE: N/A

MAP PAGE(S): 5-00-024

APPOVED BY: RRM **DATE:** 12-19-19

SCALE: 1" = 50 **PRIOR INSTRUMENT:** 20090298116