PARENT PARCEL: 04-00-003-101-577, -579, -581, -582

CHILD PARCEL: 04-00-003-101-588 THRU -596

STARTING POINT: INTERSECTION OF C/L OF SHEFFIELD -FRENCH CREEK RD. AND C/L OF MUIRFIELD RD.

21-04238

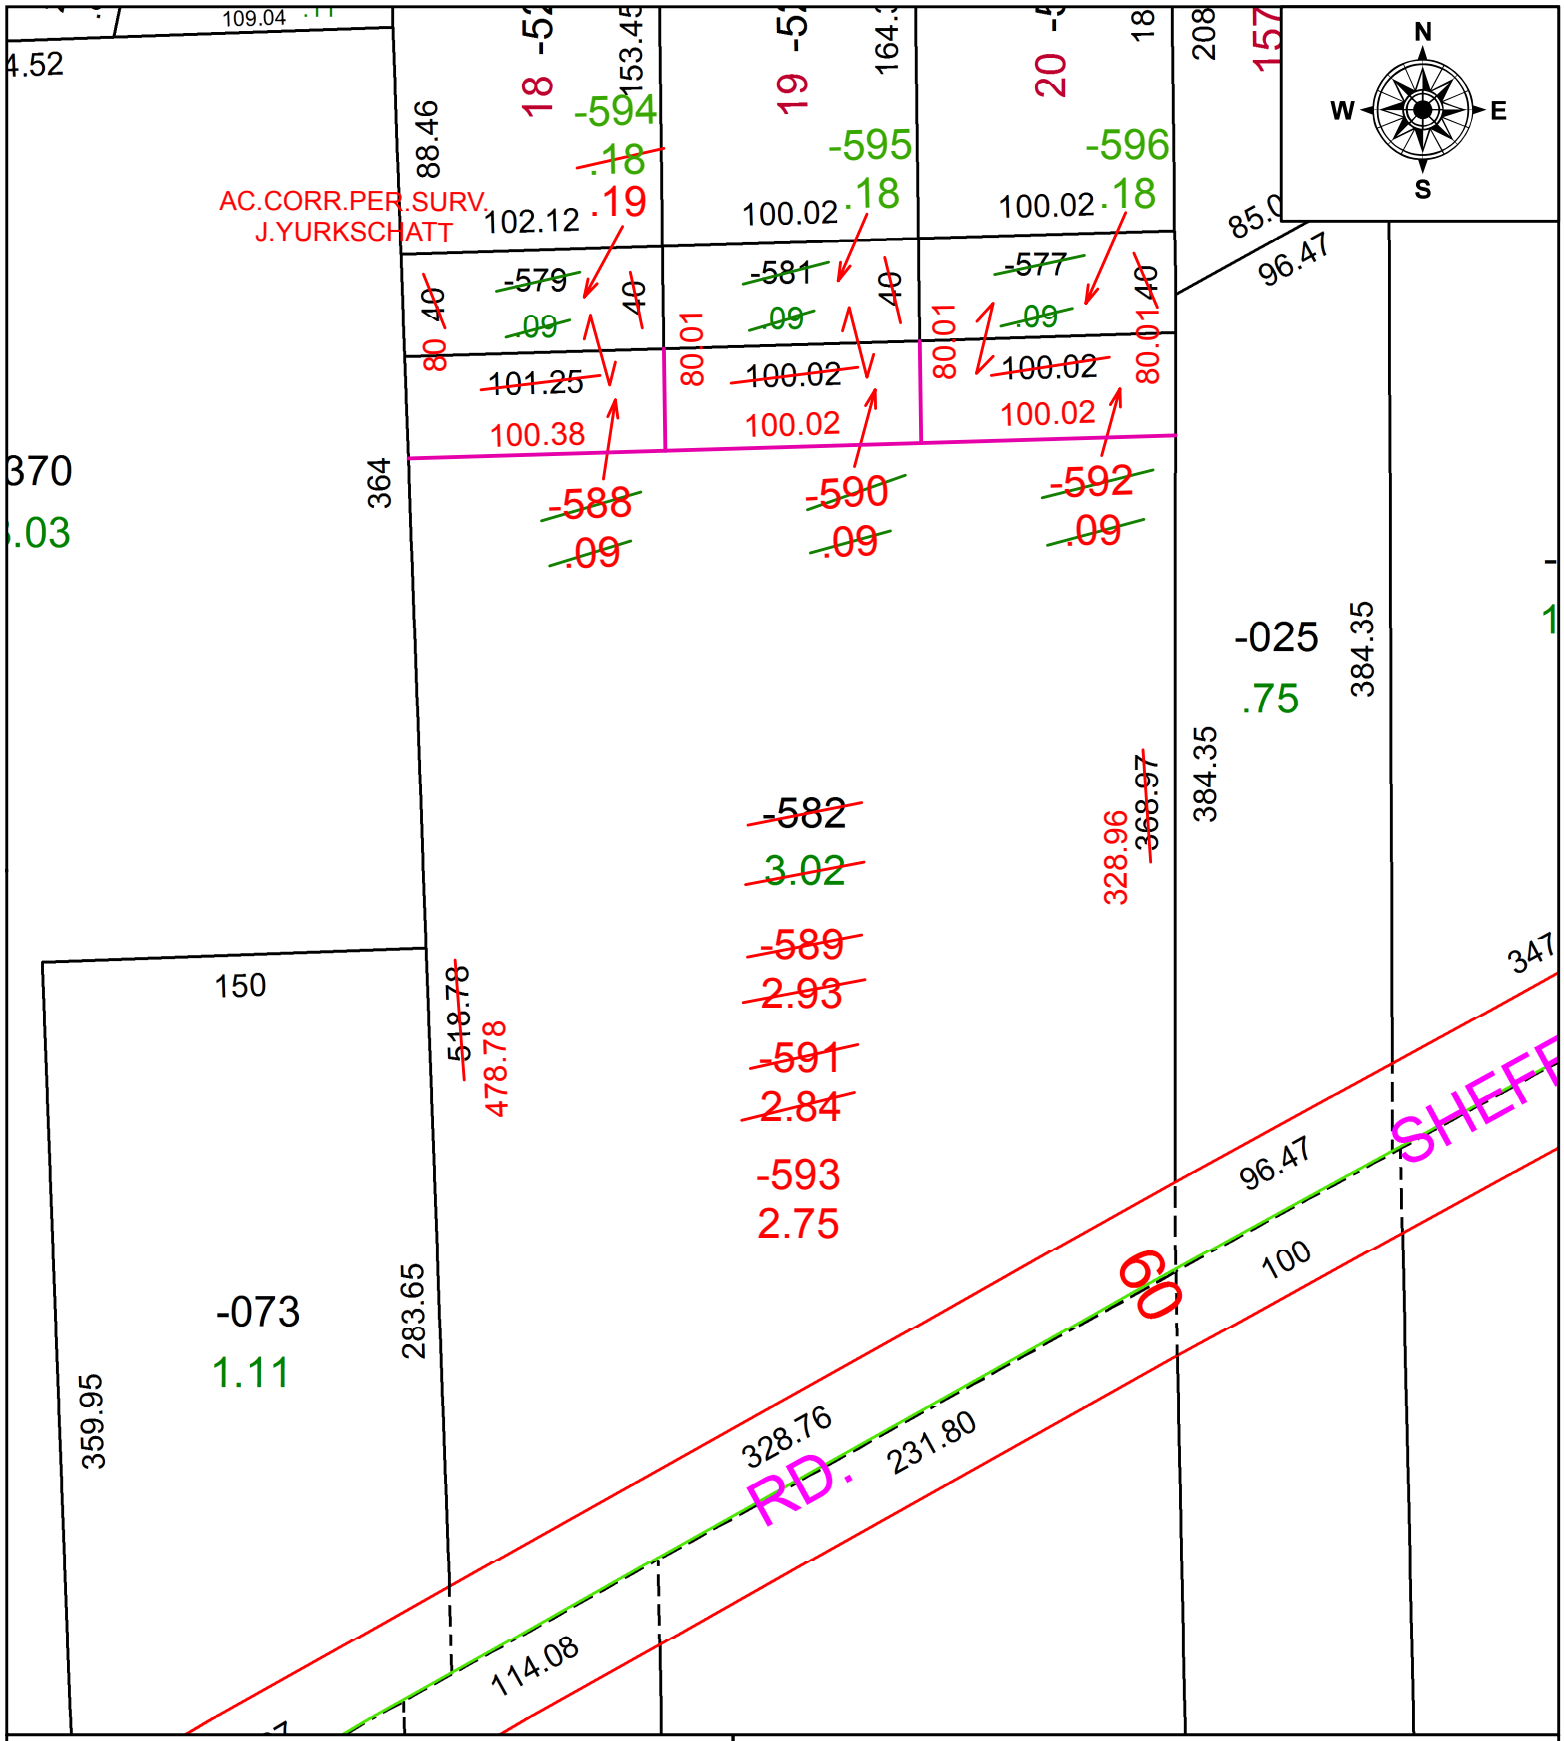

SPLITS/DEEDS PROCESSED

LORAIN COUNTY TAX MAP DEPARTMENT
226 MIDDLE AVE. ELYRIA, OH

SURVEYED BY: JAMES P. YURKSCHATT
CLOSURE: 1:49,203
MAP PAGE(S): 4-00-003
APPOVED BY: RRM **DATE:** 1-15-21
SCALE: 1" = 75 **PRIOR INSTRUMENT:** 20160598589