PARENT PARCEL: 04-00-020-101-005

CHILD PARCEL:

STARTING POINT: INTERSECTION OF C/L OF WALKER RD. AND C/L OF JAYCOX RD.

19-04239-C

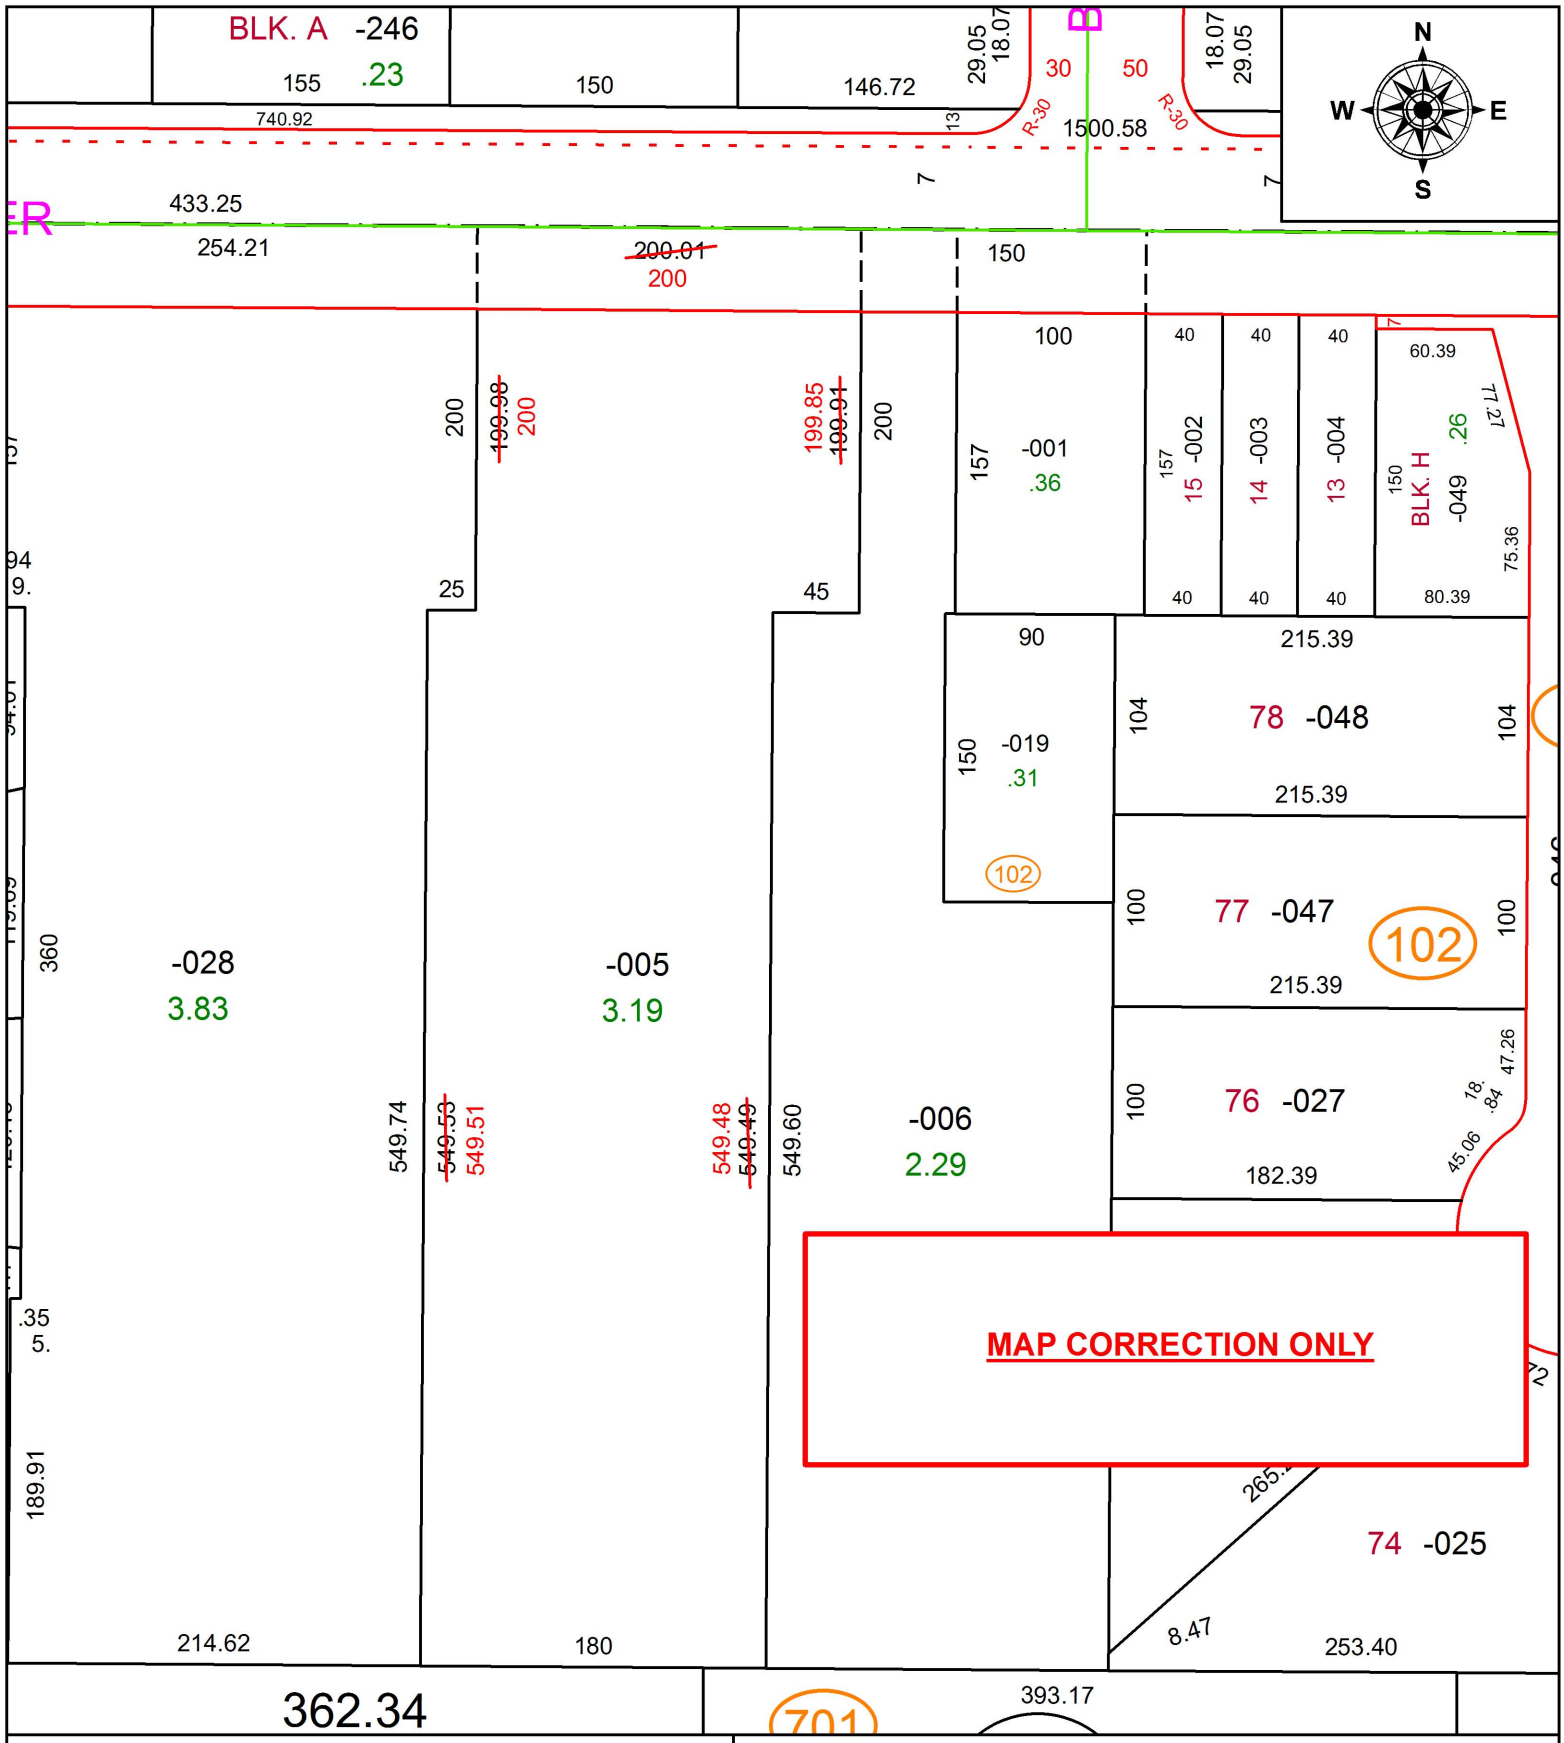

SPLITS/DEEDS PROCESSED

LORAIN COUNTY TAX MAP DEPARTMENT
226 MIDDLE AVE. ELYRIA, OH

SURVEYED BY: MATTHEW W. SERMERSHEIM
CLOSURE: 1:1,748,703
MAP PAGE(S): 4-00-020
APPOVED BY: RRM **DATE:** 12-20-19
SCALE: 1" = 100 **PRIOR INSTRUMENT:** 20190742469