PARENT PARCEL: 04-00-023-105-296

CHILD PARCEL: 04-00-023-105-300 THRU -302

STARTING POINT: INTERSECTION OF C/L OF SCHWARTZ RD. AND C/L OF JAYCOX RD.

21-04239

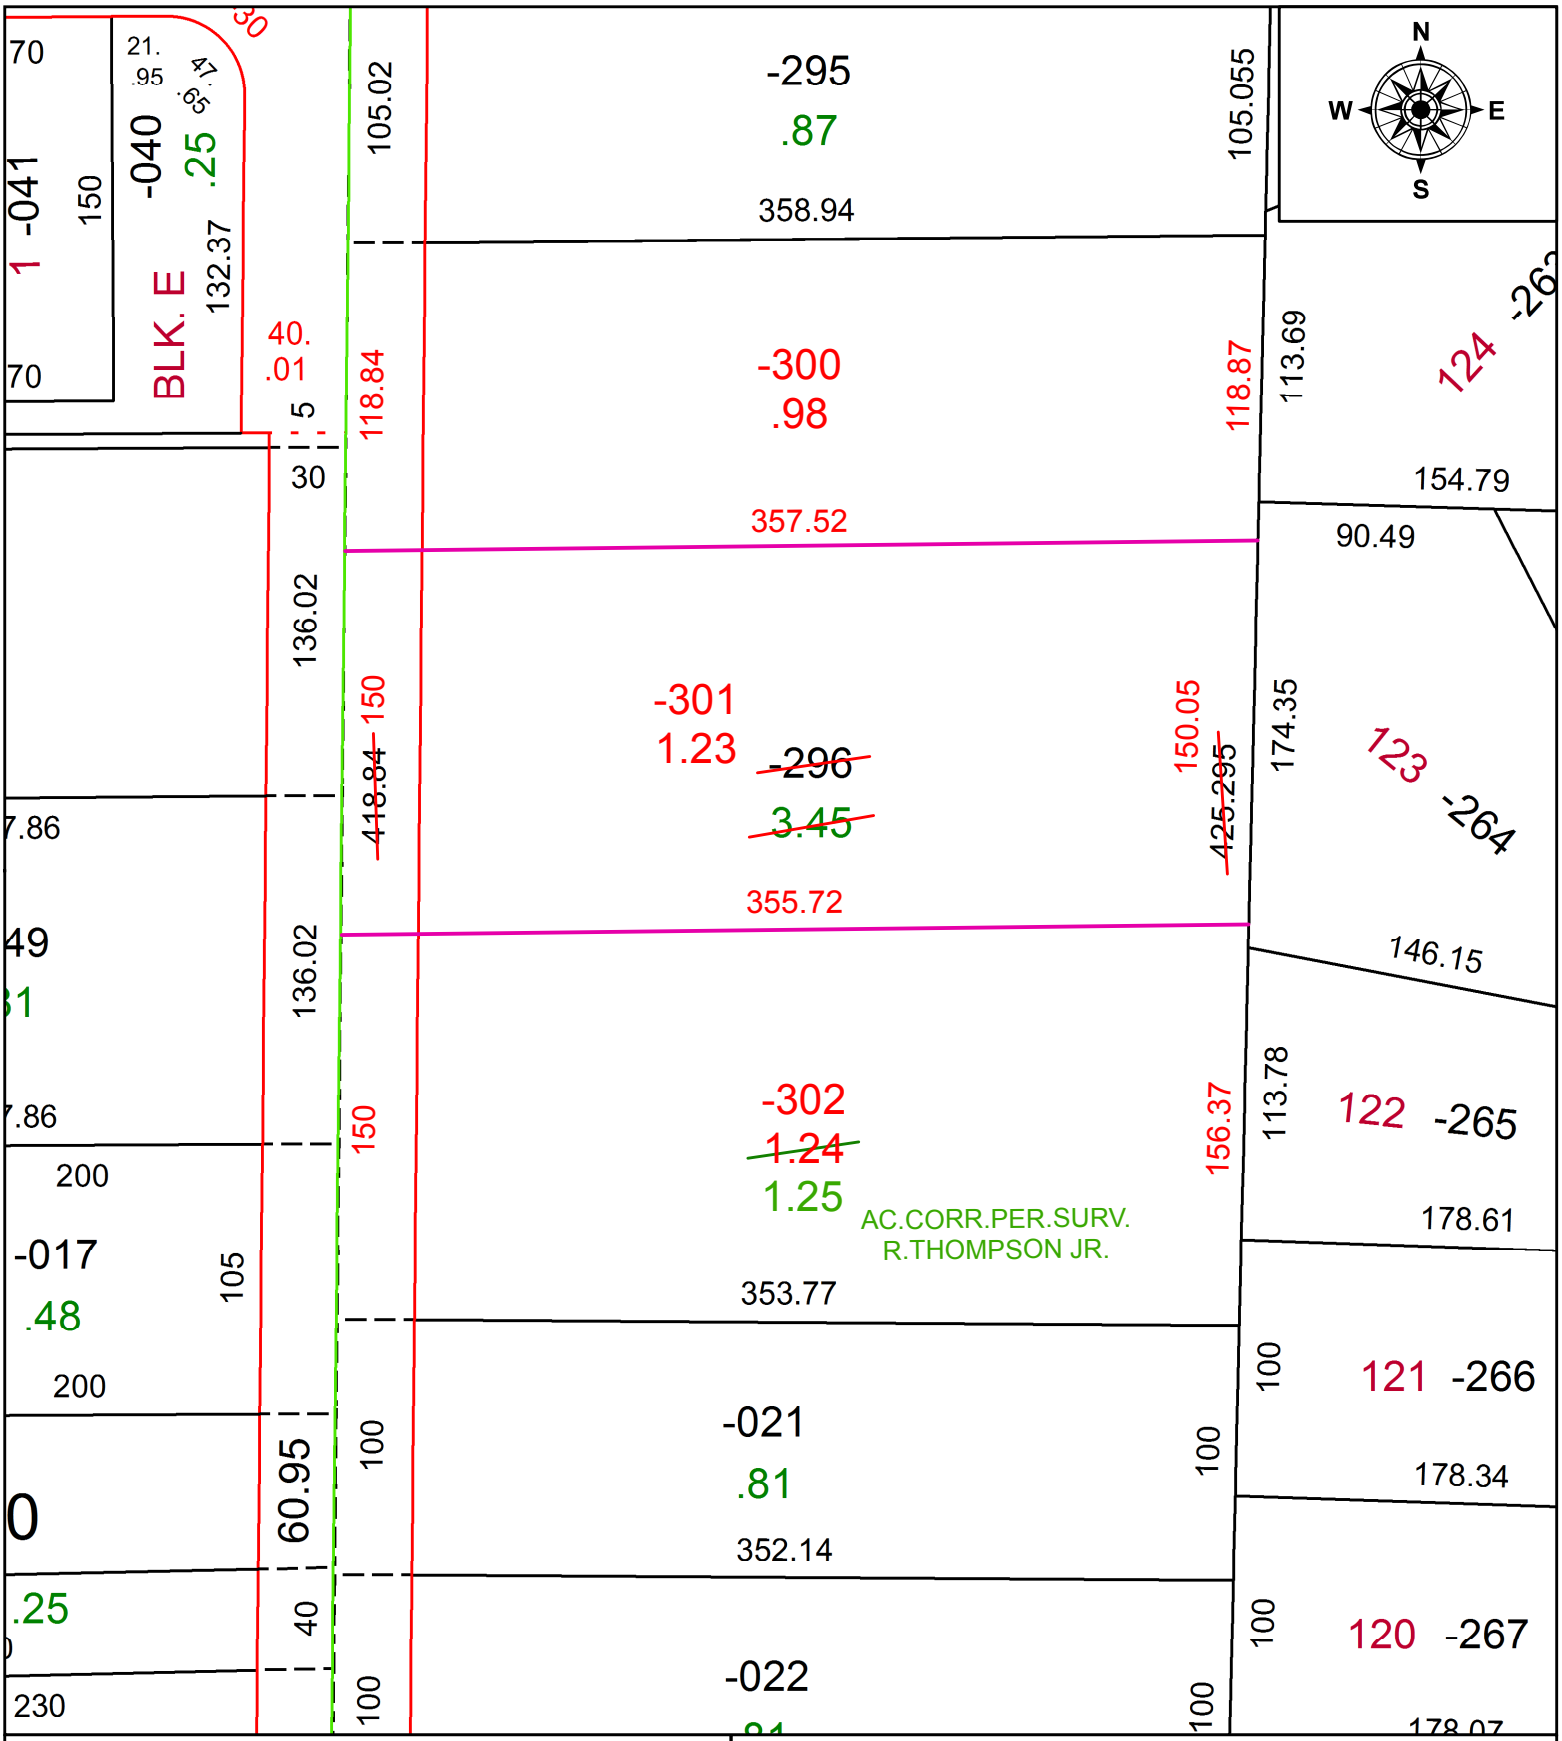

SPLITS/DEEDS PROCESSED

LORAIN COUNTY TAX MAP DEPARTMENT
226 MIDDLE AVE. ELYRIA, OH

SURVEYED BY: RICHARD A. THOMPSON JR.
CLOSURE: 1: 111,925
MAP PAGE(S): 4-00-023
APPOVED BY: RRM **DATE:** 1-15-21
SCALE: 1" = 75 **PRIOR INSTRUMENT:** 20200784805