**PARENT PARCEL:** 10-00-003-107-023

**CHILD PARCEL:**

**STARTING POINT:** S/L 140 AND THE WEST 26.66 FT OF S/L 141 IN BIRMINGHAM PARK ADD.

**20-04241-D**

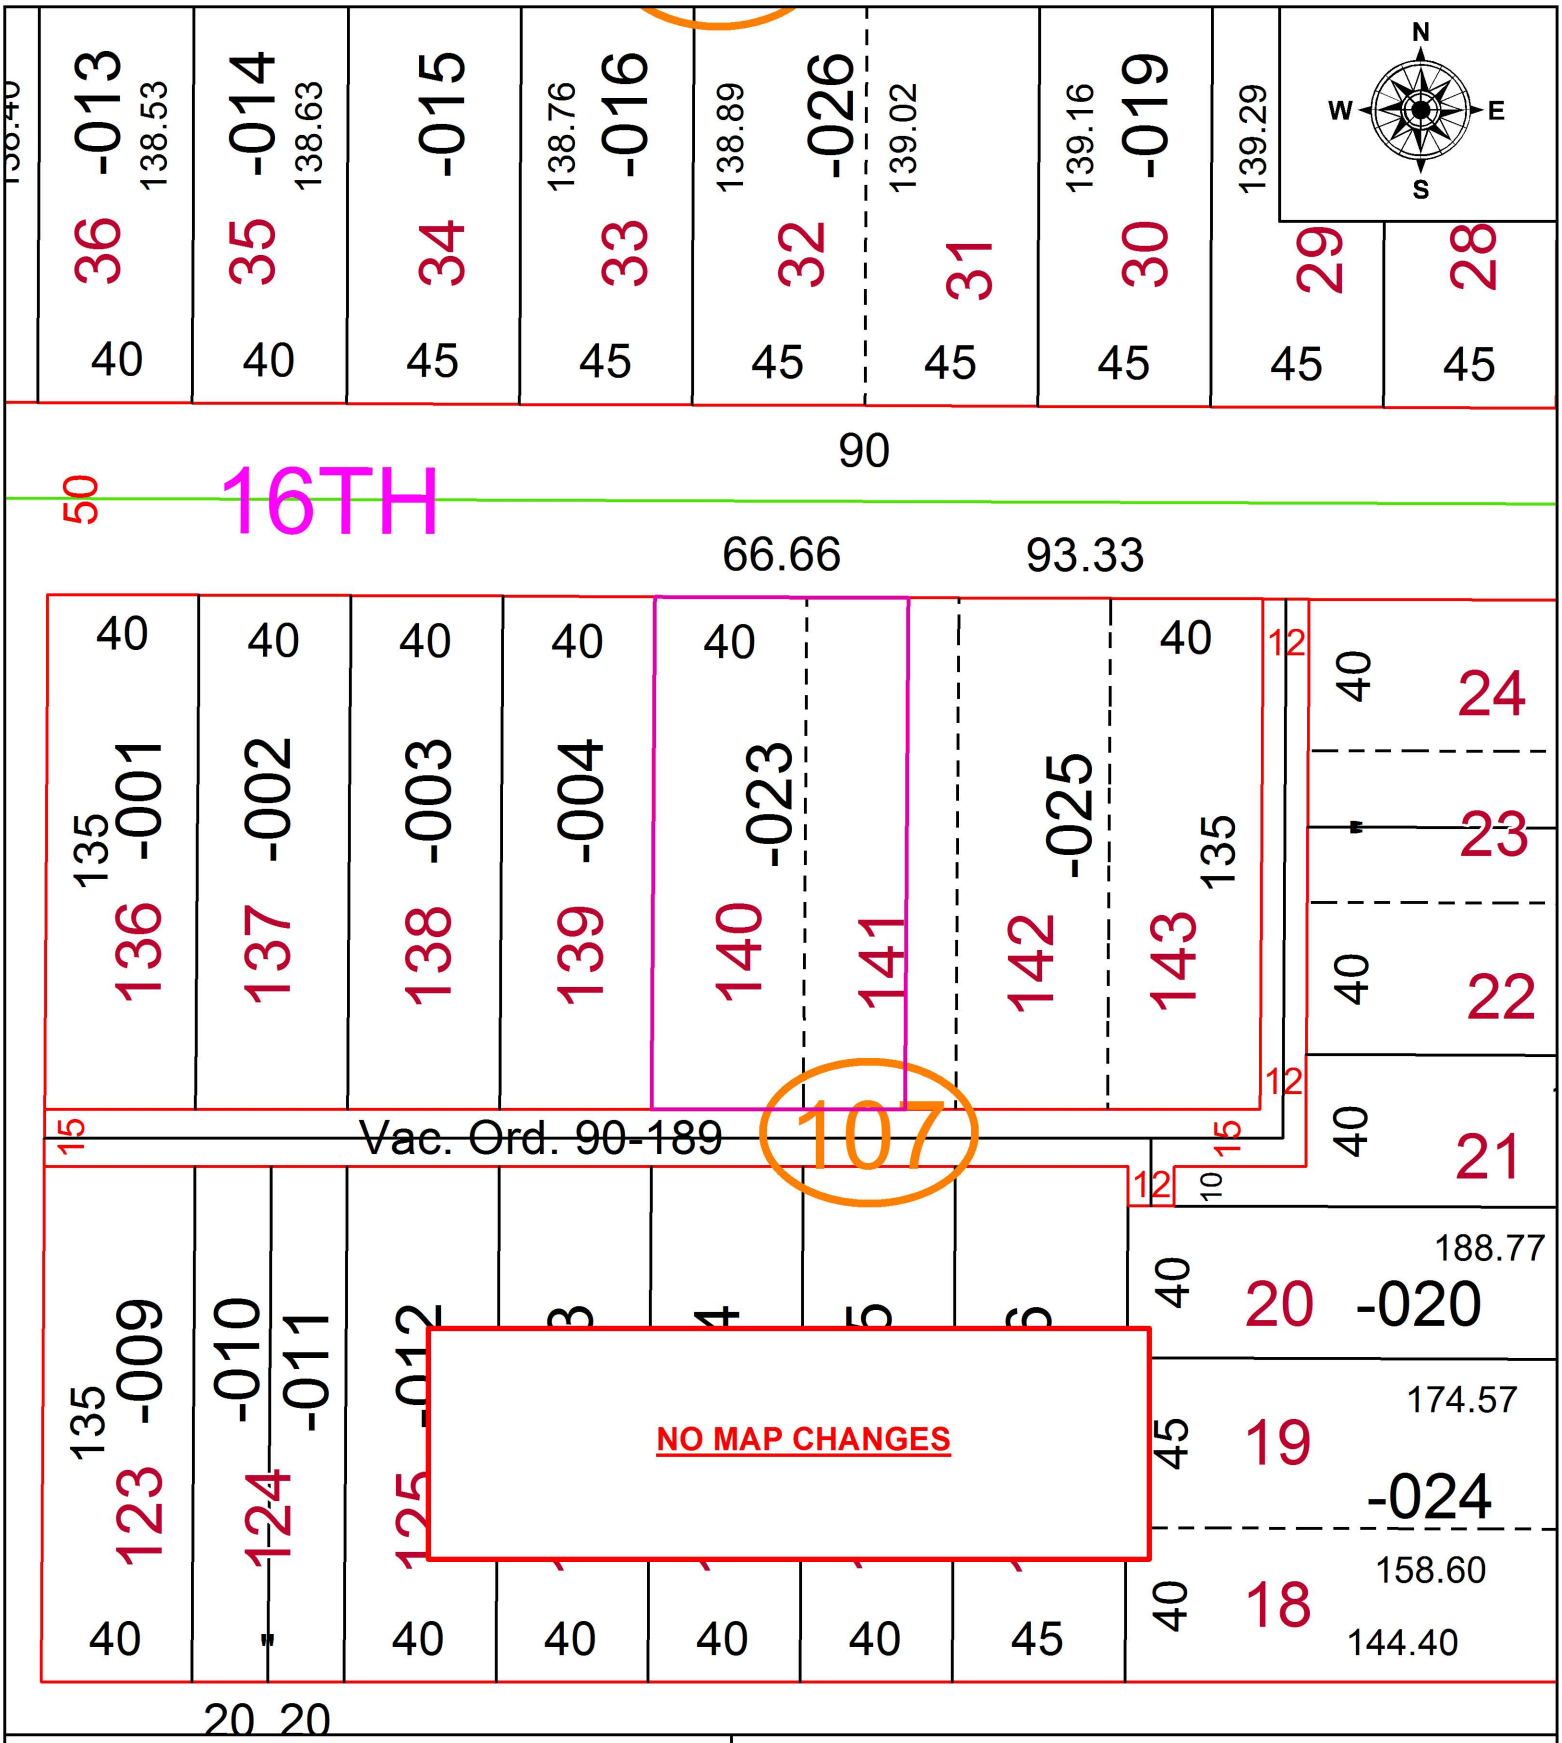


**SPLITS/DEEDS PROCESSED**

LORAIN COUNTY TAX MAP DEPARTMENT
226 MIDDLE AVE. ELYRIA, OH

**SURVEYED BY:** PATRICK A. MCGANNON
**CLOSURE:** N/A
**MAP PAGE(S):** 10-00-003
**APPOVED BY:** RRM **DATE:** 1-7-20
**SCALE:** 1" = 50 **PRIOR INSTRUMENT:** 20180691112