PARENT PARCEL: 14-00-028-000-003, -012

CHILD PARCEL: 14-00-028-000-019, -020

STARTING POINT: SOUTHWEST CORNER OF O.L.28

21-04241

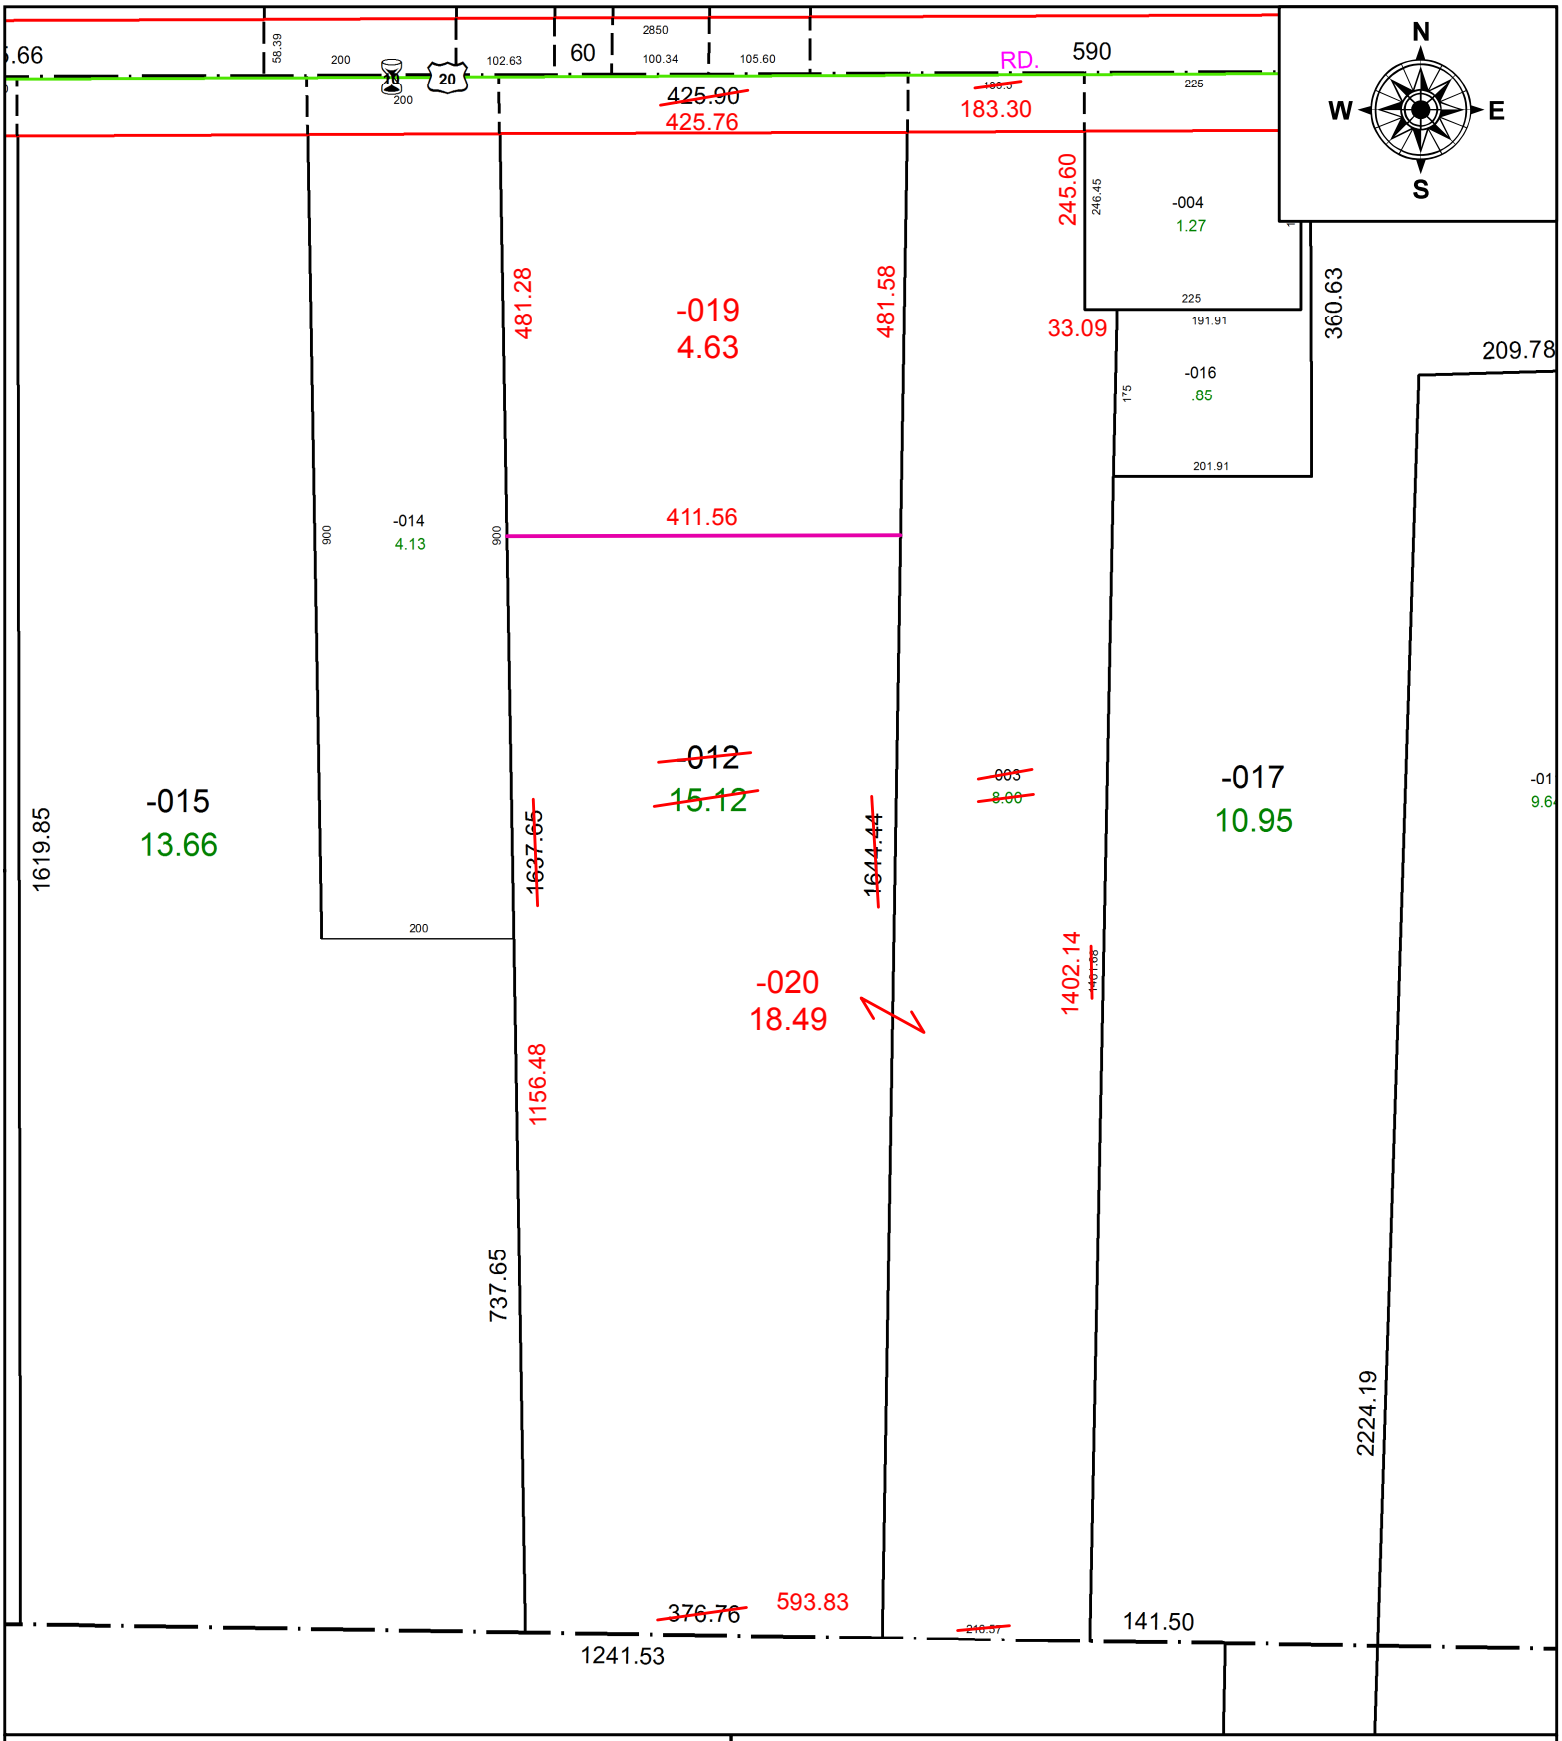

SPLITS/DEEDS PROCESSED

LORAIN COUNTY TAX MAP DEPARTMENT
226 MIDDLE AVE. ELYRIA, OH

SURVEYED BY: TIMOTHY D. HOZALSKI
CLOSURE: 1: 236,289
MAP PAGE(S): 14-00-028
APPOVED BY: RRM **DATE:** 1-26-21
SCALE: 1" = 200 **PRIOR INSTRUMENT:** 20200788732