PARENT PARCEL: 06-25-006-110-015, -018, -019

CHILD PARCEL: 06-25-006-110-020

STARTING POINT: INTERSECTION OF C/L OF ABBE RD. AND C/L OF E. BROAD ST.

21-04243

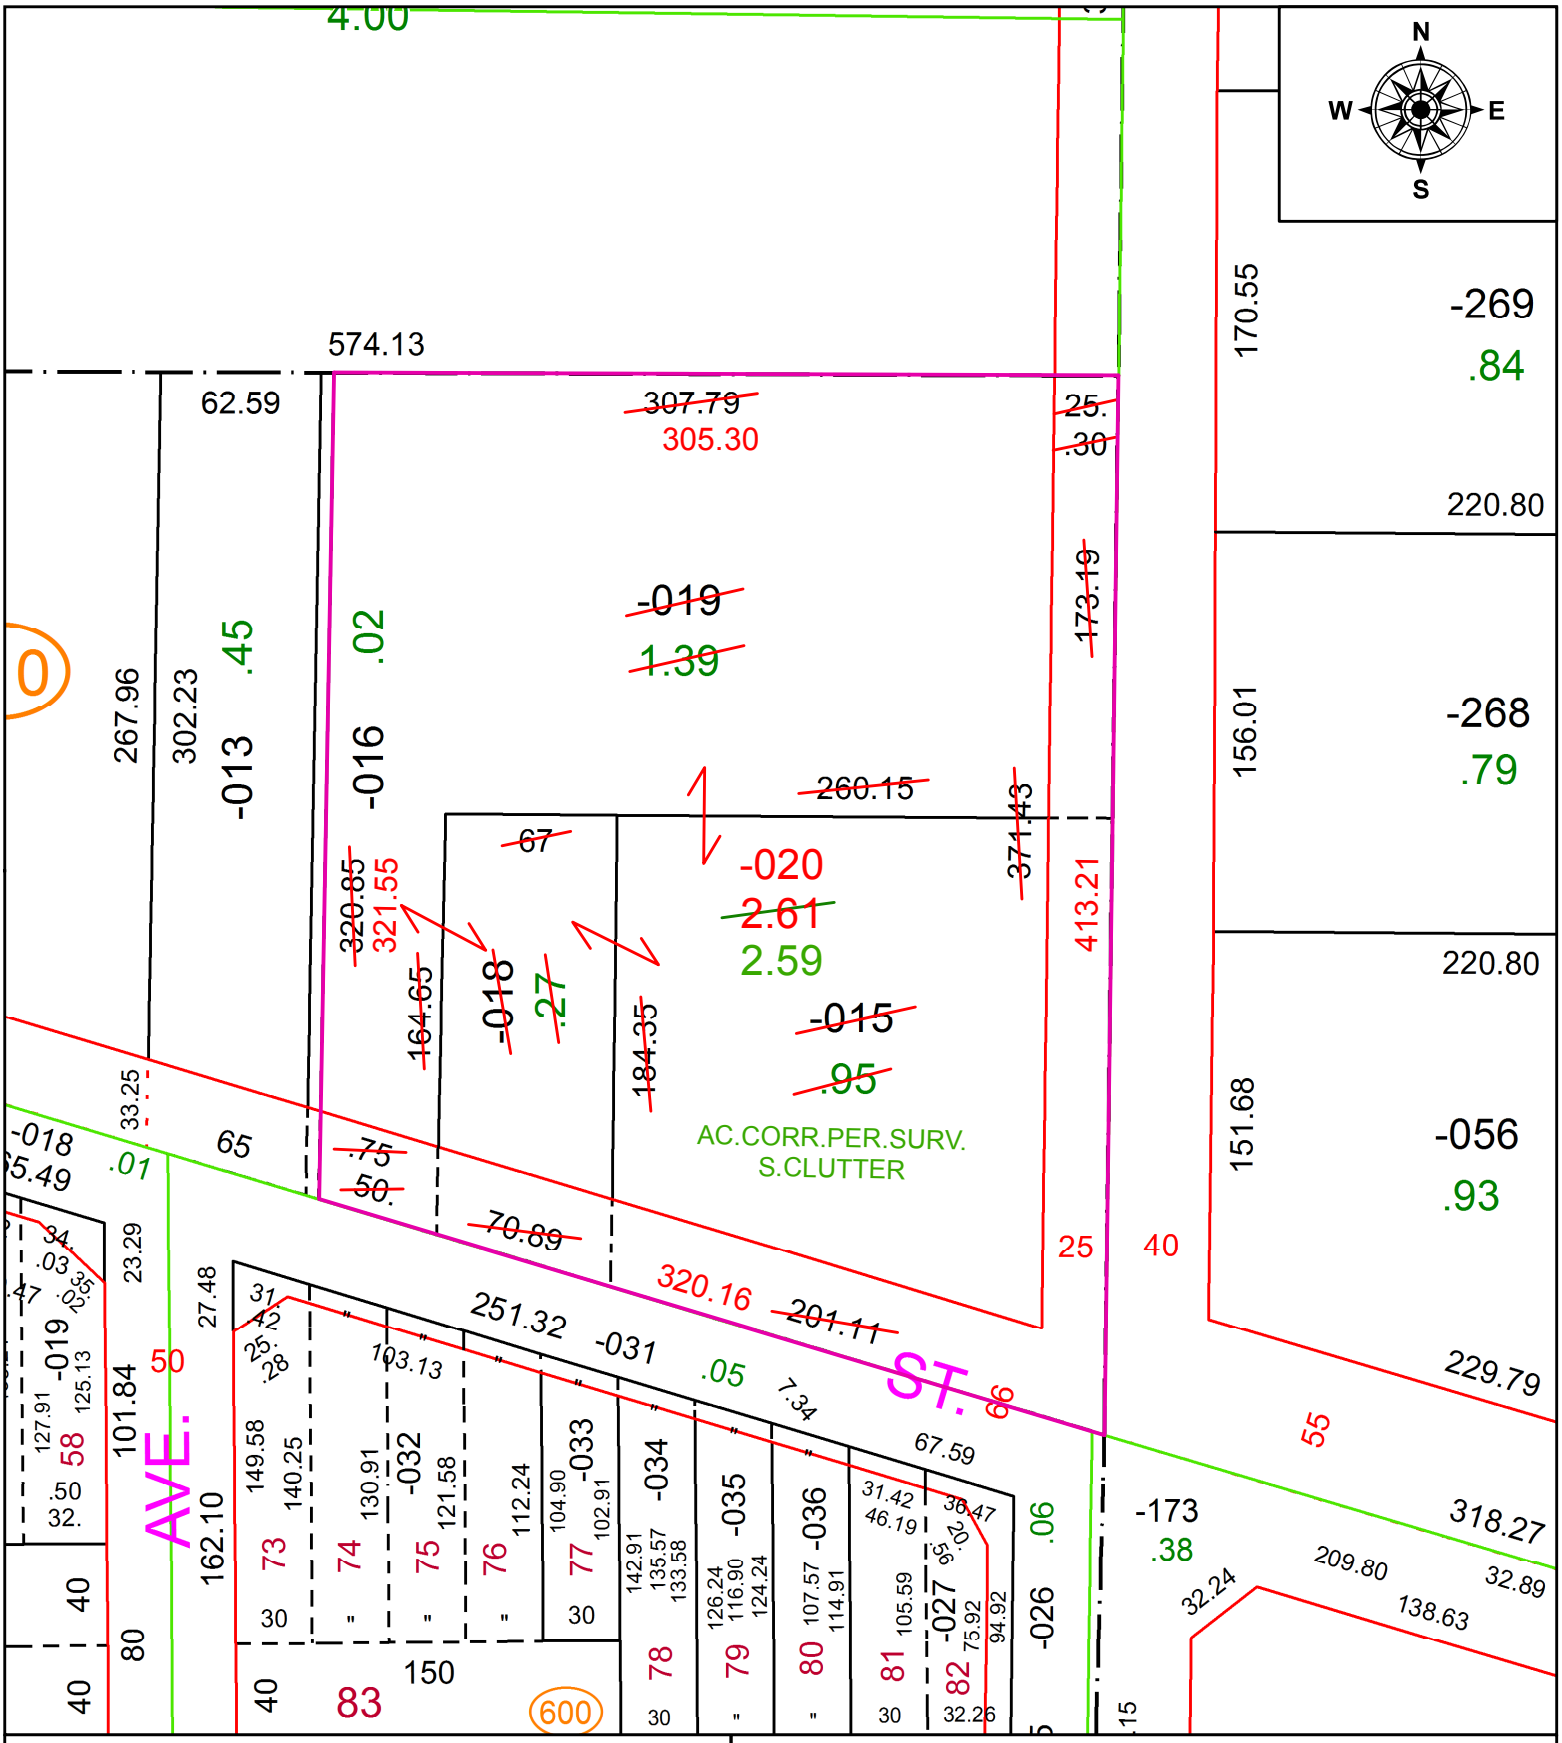

SPLITS/DEEDS PROCESSED

LORAIN COUNTY TAX MAP DEPARTMENT
226 MIDDLE AVE. ELYRIA, OH

SURVEYED BY: STEVEN W. CLUTTER
CLOSURE: 1: 311,099
MAP PAGE(S): 6-25-006
APPOVED BY: RRM **DATE:** 1-26-21
SCALE: 1" = 75 **PRIOR INSTRUMENT:** 20190742519