PARENT PARCEL: 13-08-017-000-002, 17-08-020-000-010, 17-08-035-000-001

CHILD PARCEL: 13-08-017-000-003, -004, 17-08-020-000-010, 17-08-035-000-001

STARTING POINT: SOUTHEAST CORNER OF O.L.20 TR. 8

21-04247

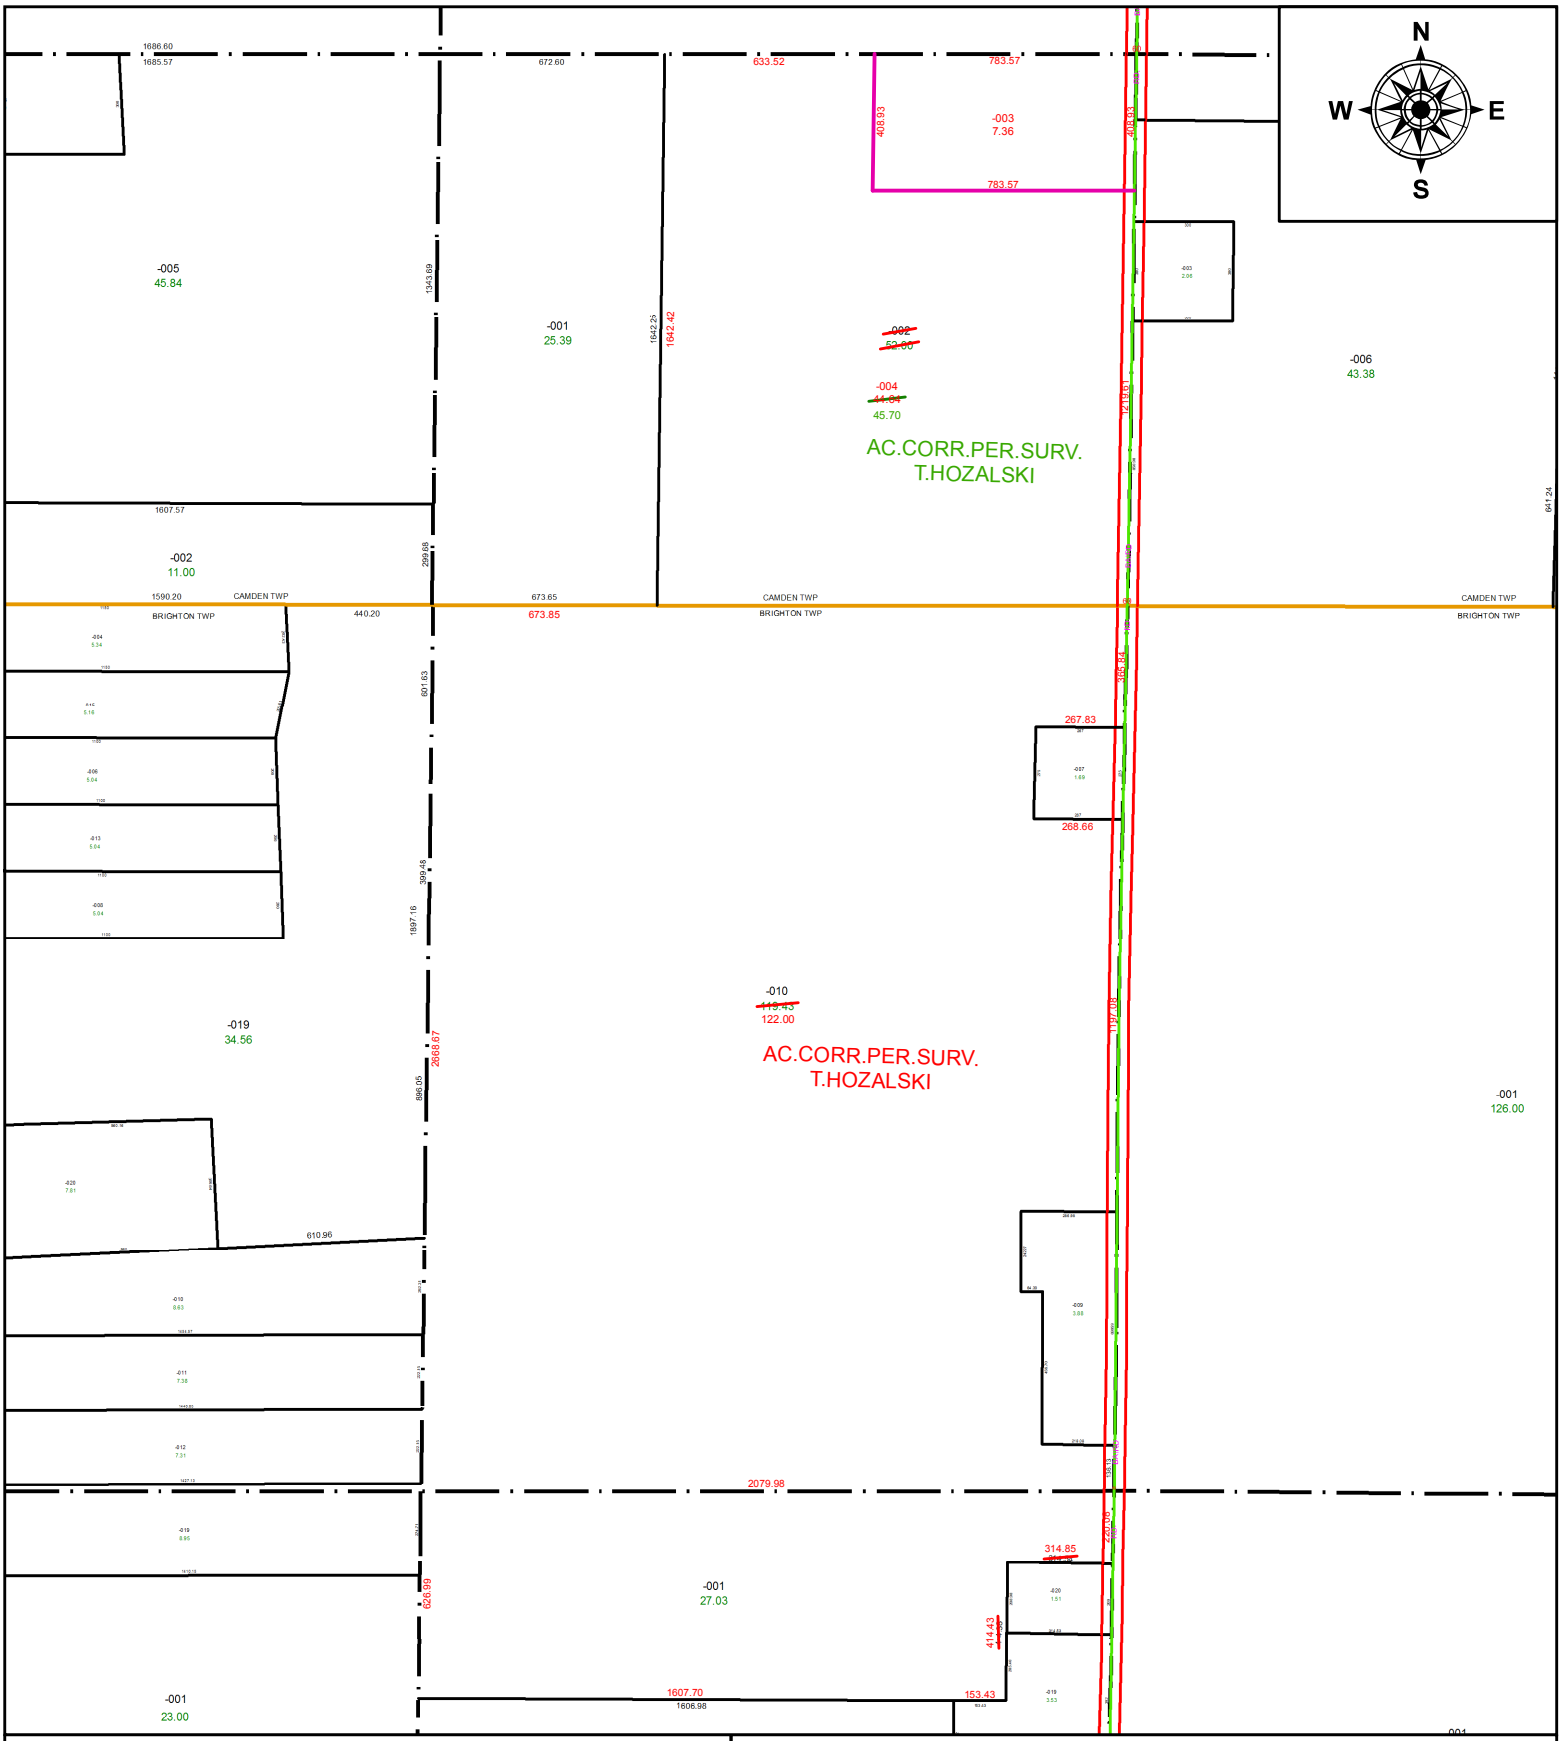

SPLITS/DEEDS PROCESSED

LORAIN COUNTY TAX MAP DEPARTMENT
226 MIDDLE AVE. ELYRIA, OH

SURVEYED BY: TIMOTHY D.HOZALSKI
CLOSURE: 1: 1,194,524
MAP PAGE(S): 13-08-017
APPOVED BY: RRM **DATE:** 2-3-21
SCALE: 1" = 575 **PRIOR INSTRUMENT:** 20200791566