PARENT PARCEL: 11-00-029-000-054

CHILD PARCEL: 11-00-029-000-055 THRU -058

STARTING POINT: INTERSECTION OF C/L OF REED RD. AND C/L OF DYE RD.

21-04248

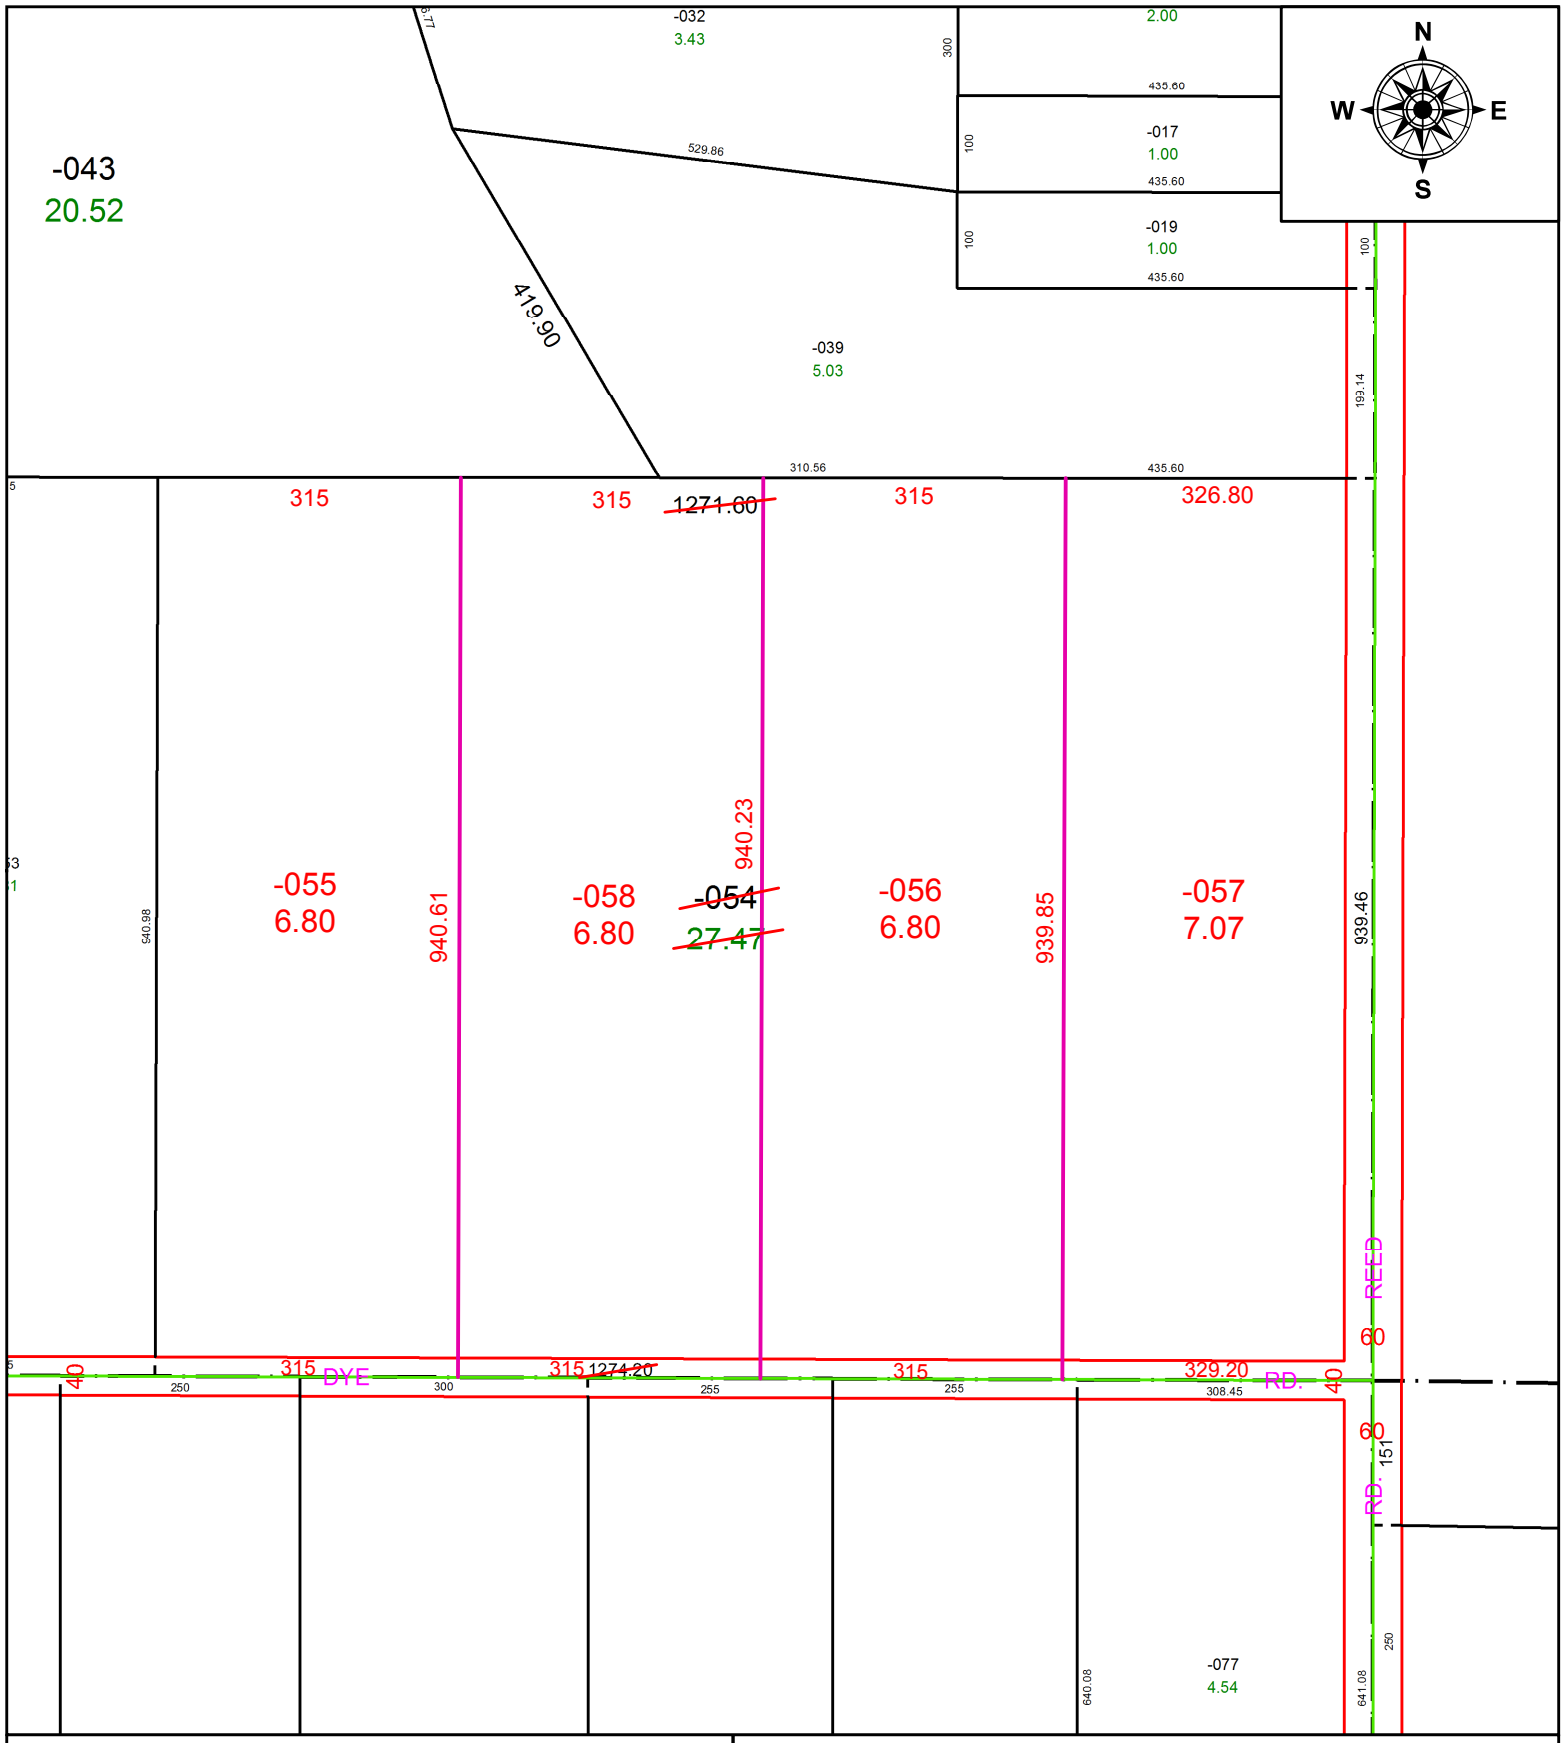

SPLITS/DEEDS PROCESSED

LORAIN COUNTY TAX MAP DEPARTMENT
226 MIDDLE AVE. ELYRIA, OH

SURVEYED BY: ALEX E. MARKS
CLOSURE: 1:287,290
MAP PAGE(S): 11-00-029
APPOVED BY: RRM **DATE:** 2-3-21
SCALE: 1" = 200 **PRIOR INSTRUMENT:** 20200794166