PARENT PARCEL: 01-00-005-105-014, 01-00-012-000-014

CHILD PARCEL:

STARTING POINT: INTERSECTION OF SOUTH LINE OF SHADY LAKE DR. AND C/L OF SUNNYSIDE RD.

20-04249-A

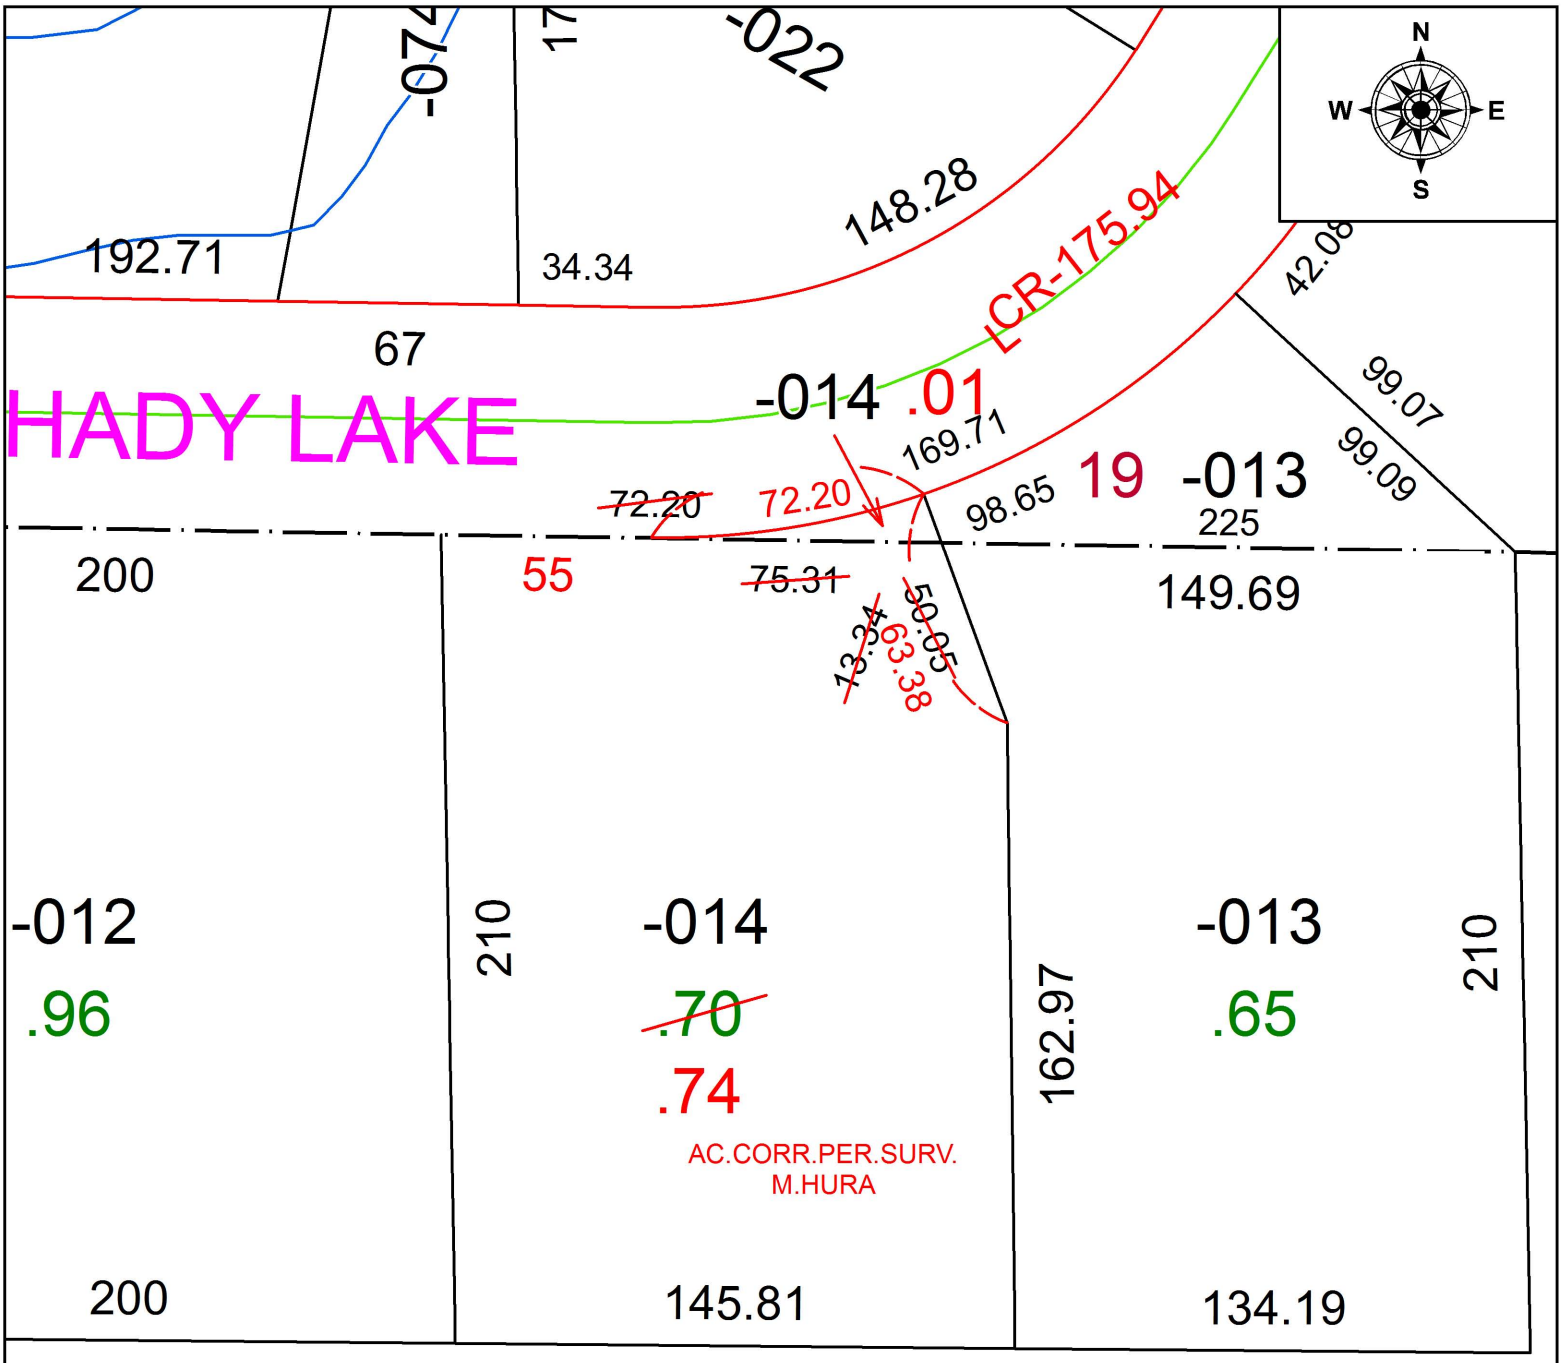

FRONTAGE & DEPTH TO ACREAGE CORRECTION

0.01 A.

~~72.20 X 13.34~~

01-00-005-105-014

CORR. PER.SURV. M.HURA

SPLITS/DEEDS PROCESSED

LORAIN COUNTY TAX MAP DEPARTMENT
226 MIDDLE AVE. ELYRIA, OH

SURVEYED BY: MICHAEL G. HURA
CLOSURE: 1:125,115
MAP PAGE(S): 1-00-012
APPOVED BY: RRM **DATE:** 1-28-20
SCALE: 1" = 50 **PRIOR INSTRUMENT:** 20190729426