PARENT PARCEL: 05-00-051-000-033, -037

CHILD PARCEL: 05-00-051-000-038 THRU -040

STARTING POINT: INTERSECTION OF C/L OF OBERLIN RD. AND NORTH LINE OF O.L.51

21-04251

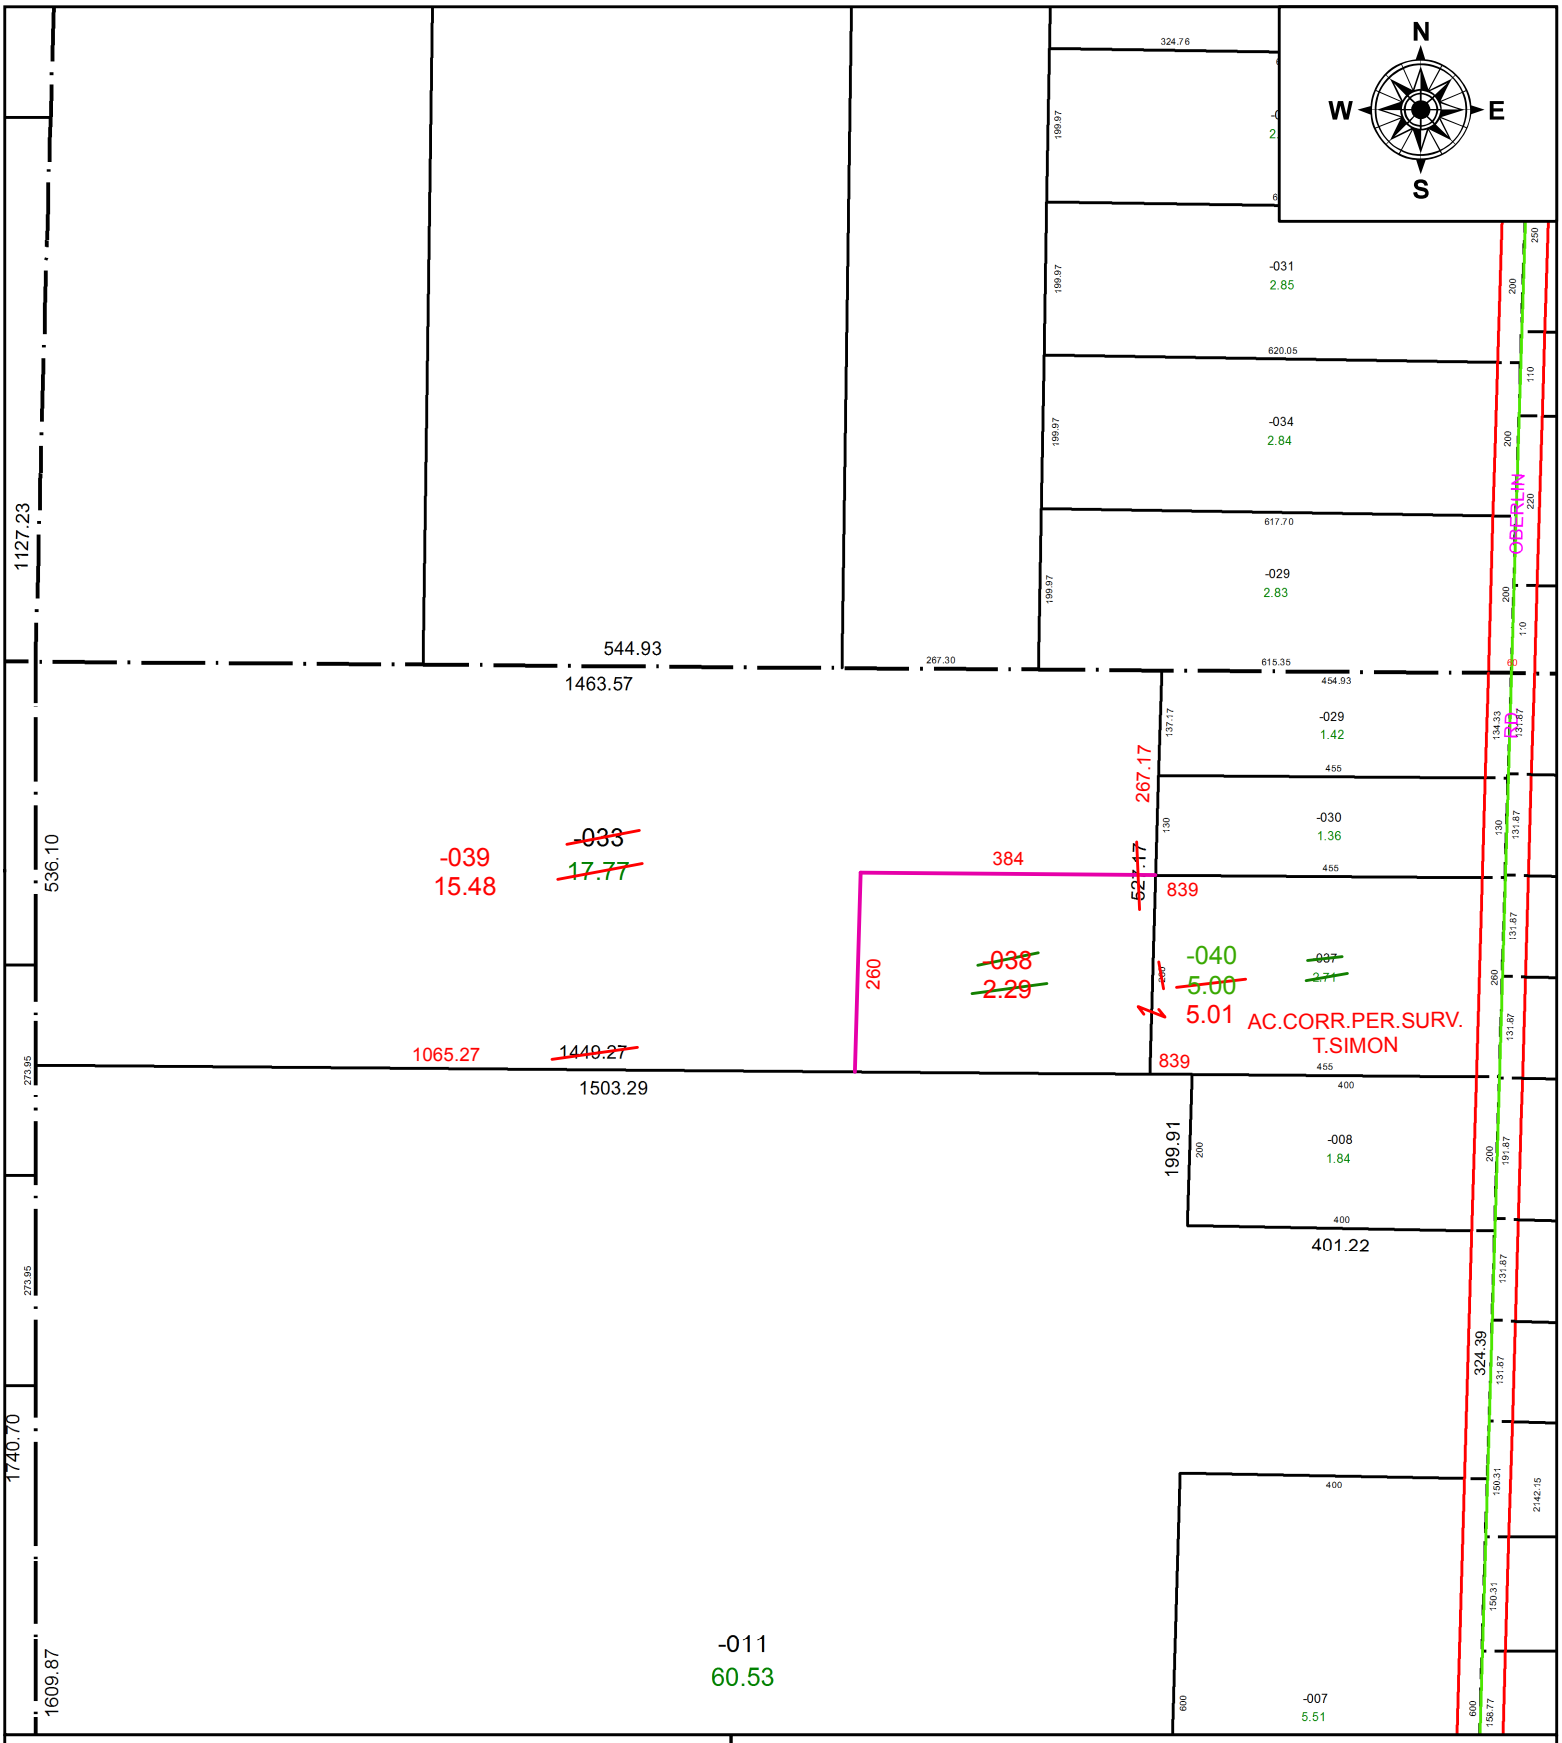

SPLITS/DEEDS PROCESSED

LORAIN COUNTY TAX MAP DEPARTMENT
226 MIDDLE AVE. ELYRIA, OH

SURVEYED BY: THOMAS A. SIMON
CLOSURE: 1: 2,019,958
MAP PAGE(S): 5-00-051
APPOVED BY: RRM **DATE:** 2-9-21
SCALE: 1" = 250 **PRIOR INSTRUMENT:** 20190736049