PARENT PARCEL: 15-00-030-000-038

CHILD PARCEL:

STARTING POINT: INTERSECTION OF C/L OF INDIAN HOLLOW RD. AND C/L OF BIGGS RD.

20-04252-A

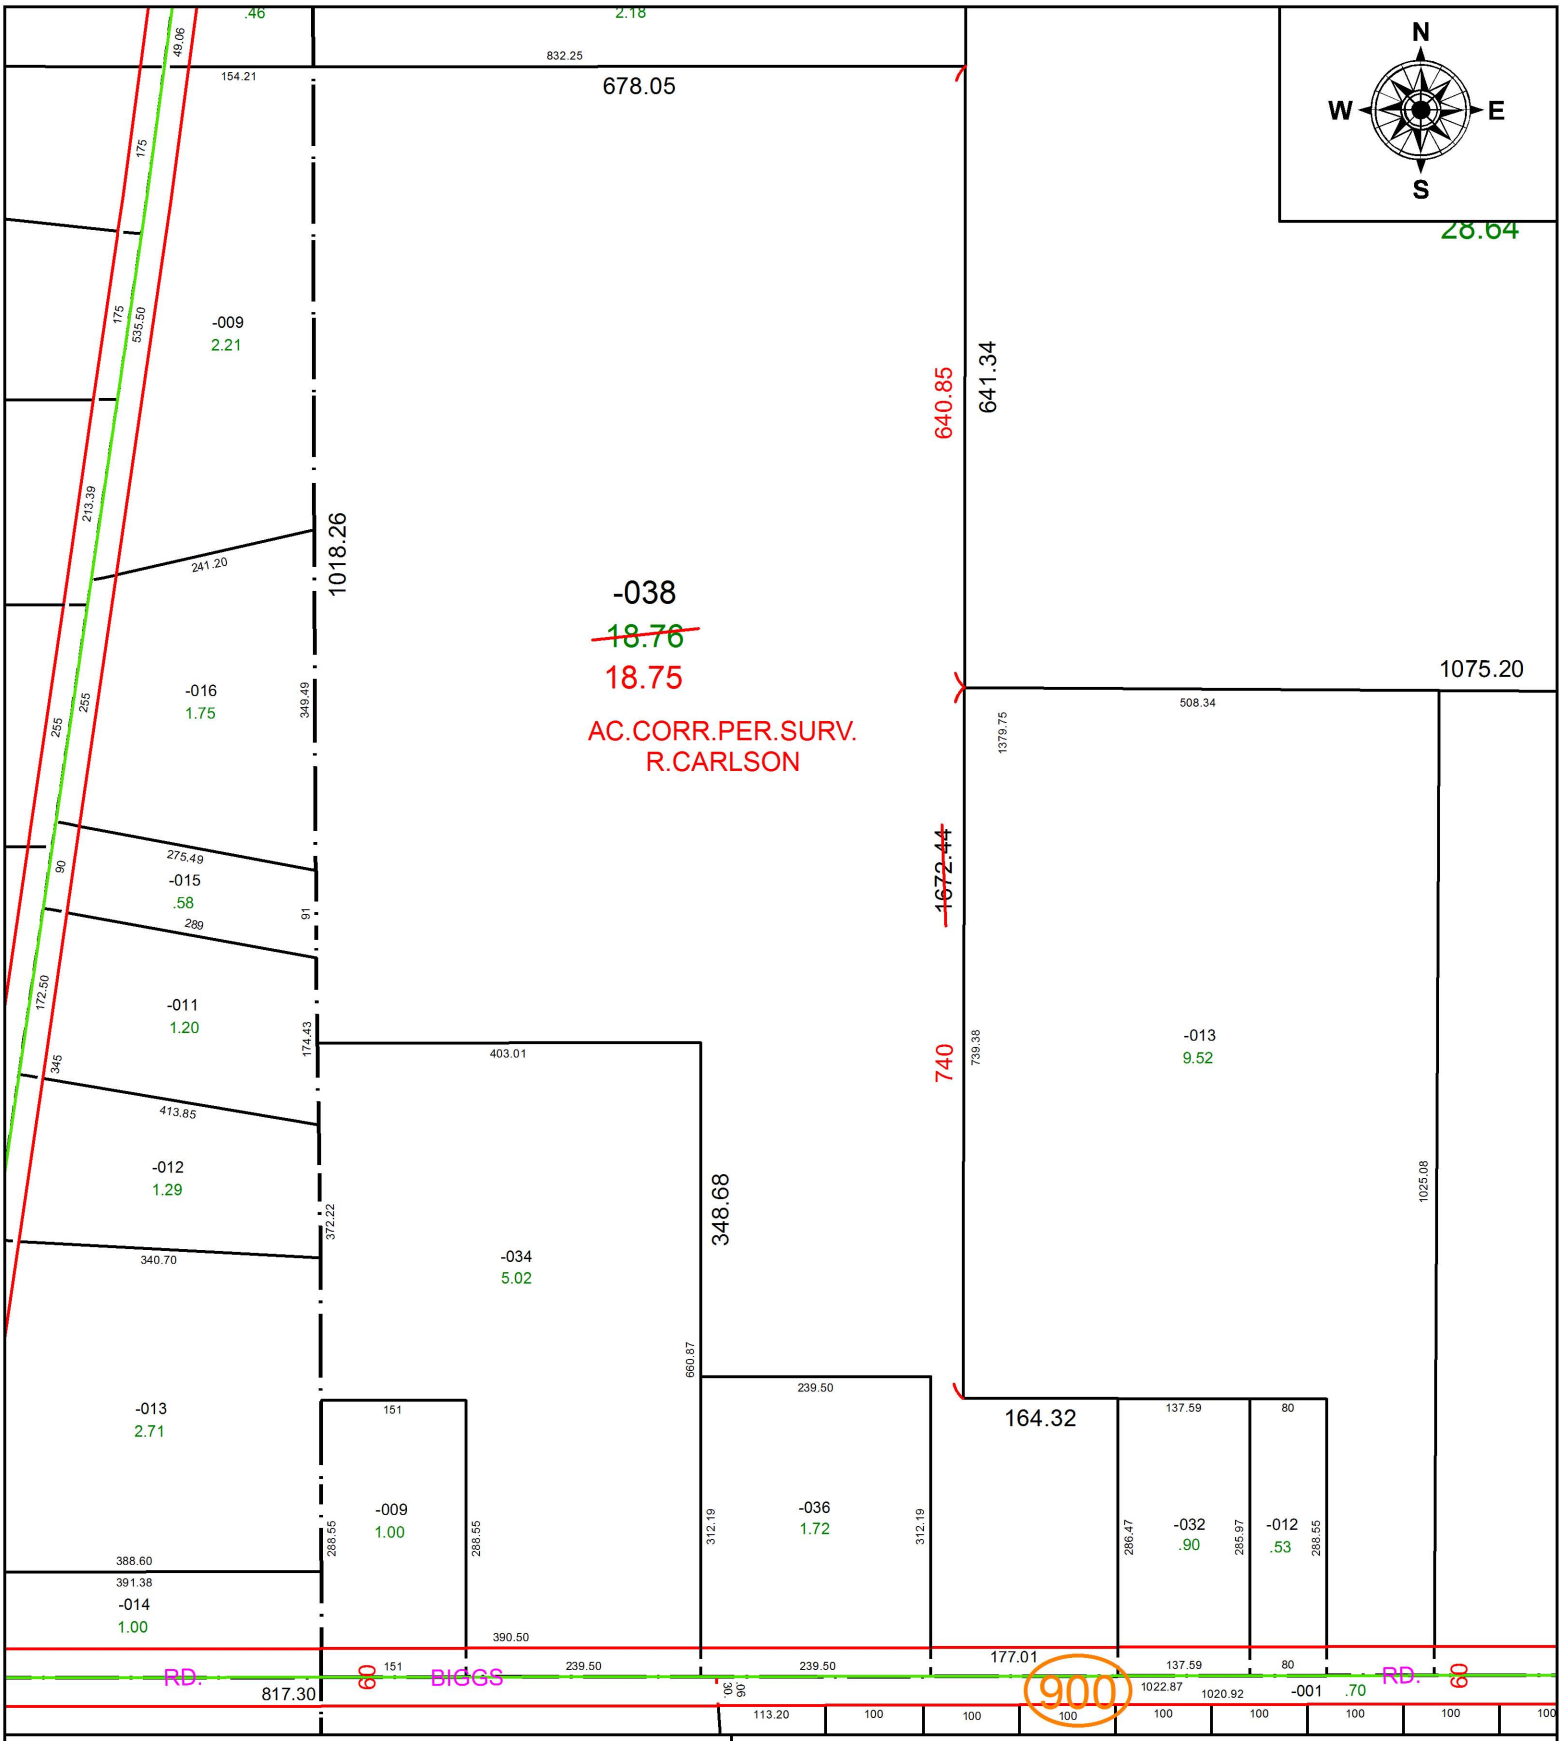

SPLITS/DEEDS PROCESSED

LORAIN COUNTY TAX MAP DEPARTMENT
226 MIDDLE AVE. ELYRIA, OH

SURVEYED BY: RICHARD D. CARLSON
CLOSURE: 1:347,091
MAP PAGE(S): 15-00-030
APPOVED BY: RRM **DATE:** 1-29-20
SCALE: 1" = 200 **PRIOR INSTRUMENT:** 20190742305