PARENT PARCEL: 03-00-022-102-023, -026

CHILD PARCEL: 03-00-022-102-028

STARTING POINT: INTERSECTION OF C/L OF COLORADO AVE. AND C/L OF OLD COLORADO AVE.

21-04254

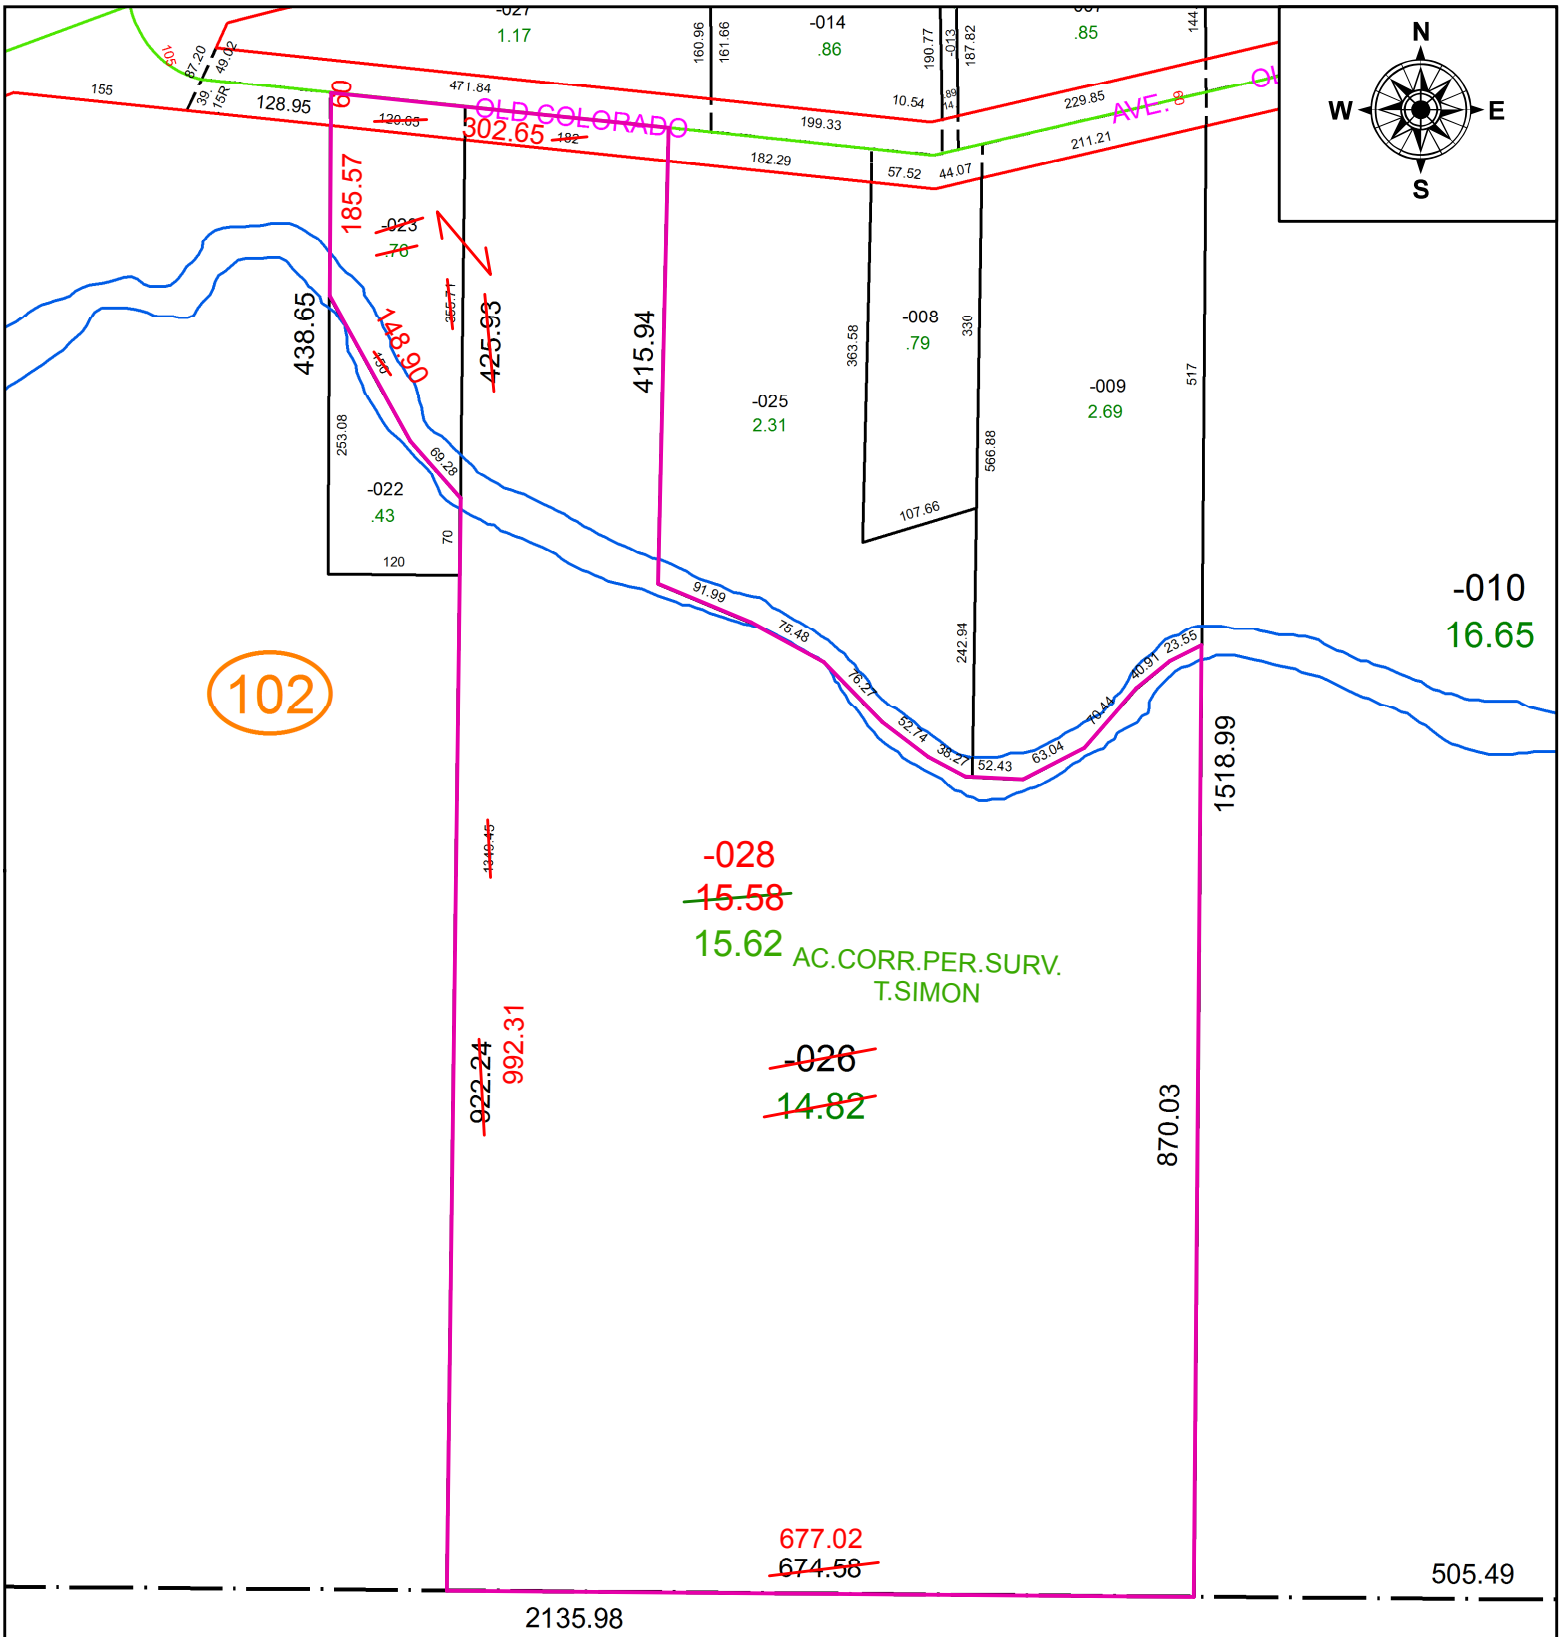

SPLITS/DEEDS PROCESSED

LORAIN COUNTY TAX MAP DEPARTMENT
226 MIDDLE AVE. ELYRIA, OH

SURVEYED BY: THOMAS A. SIMON
CLOSURE: 1:659,450
MAP PAGE(S): 3-00-022
APPOVED BY: RRM **DATE:** 2-11-21
SCALE: 1" = 175 **PRIOR INSTRUMENT:** 20200772564