PARENT PARCEL: 01-00-043-000-074, 01-00-044-000-056

CHILD PARCEL: 01-00-043-000-075, -076, 01-00-044-000-061, -062

STARTING POINT: INTERSECTION OF C/L OF CLAUS RD. AND C/L OF NORTH RIDGE RD.

21-04255

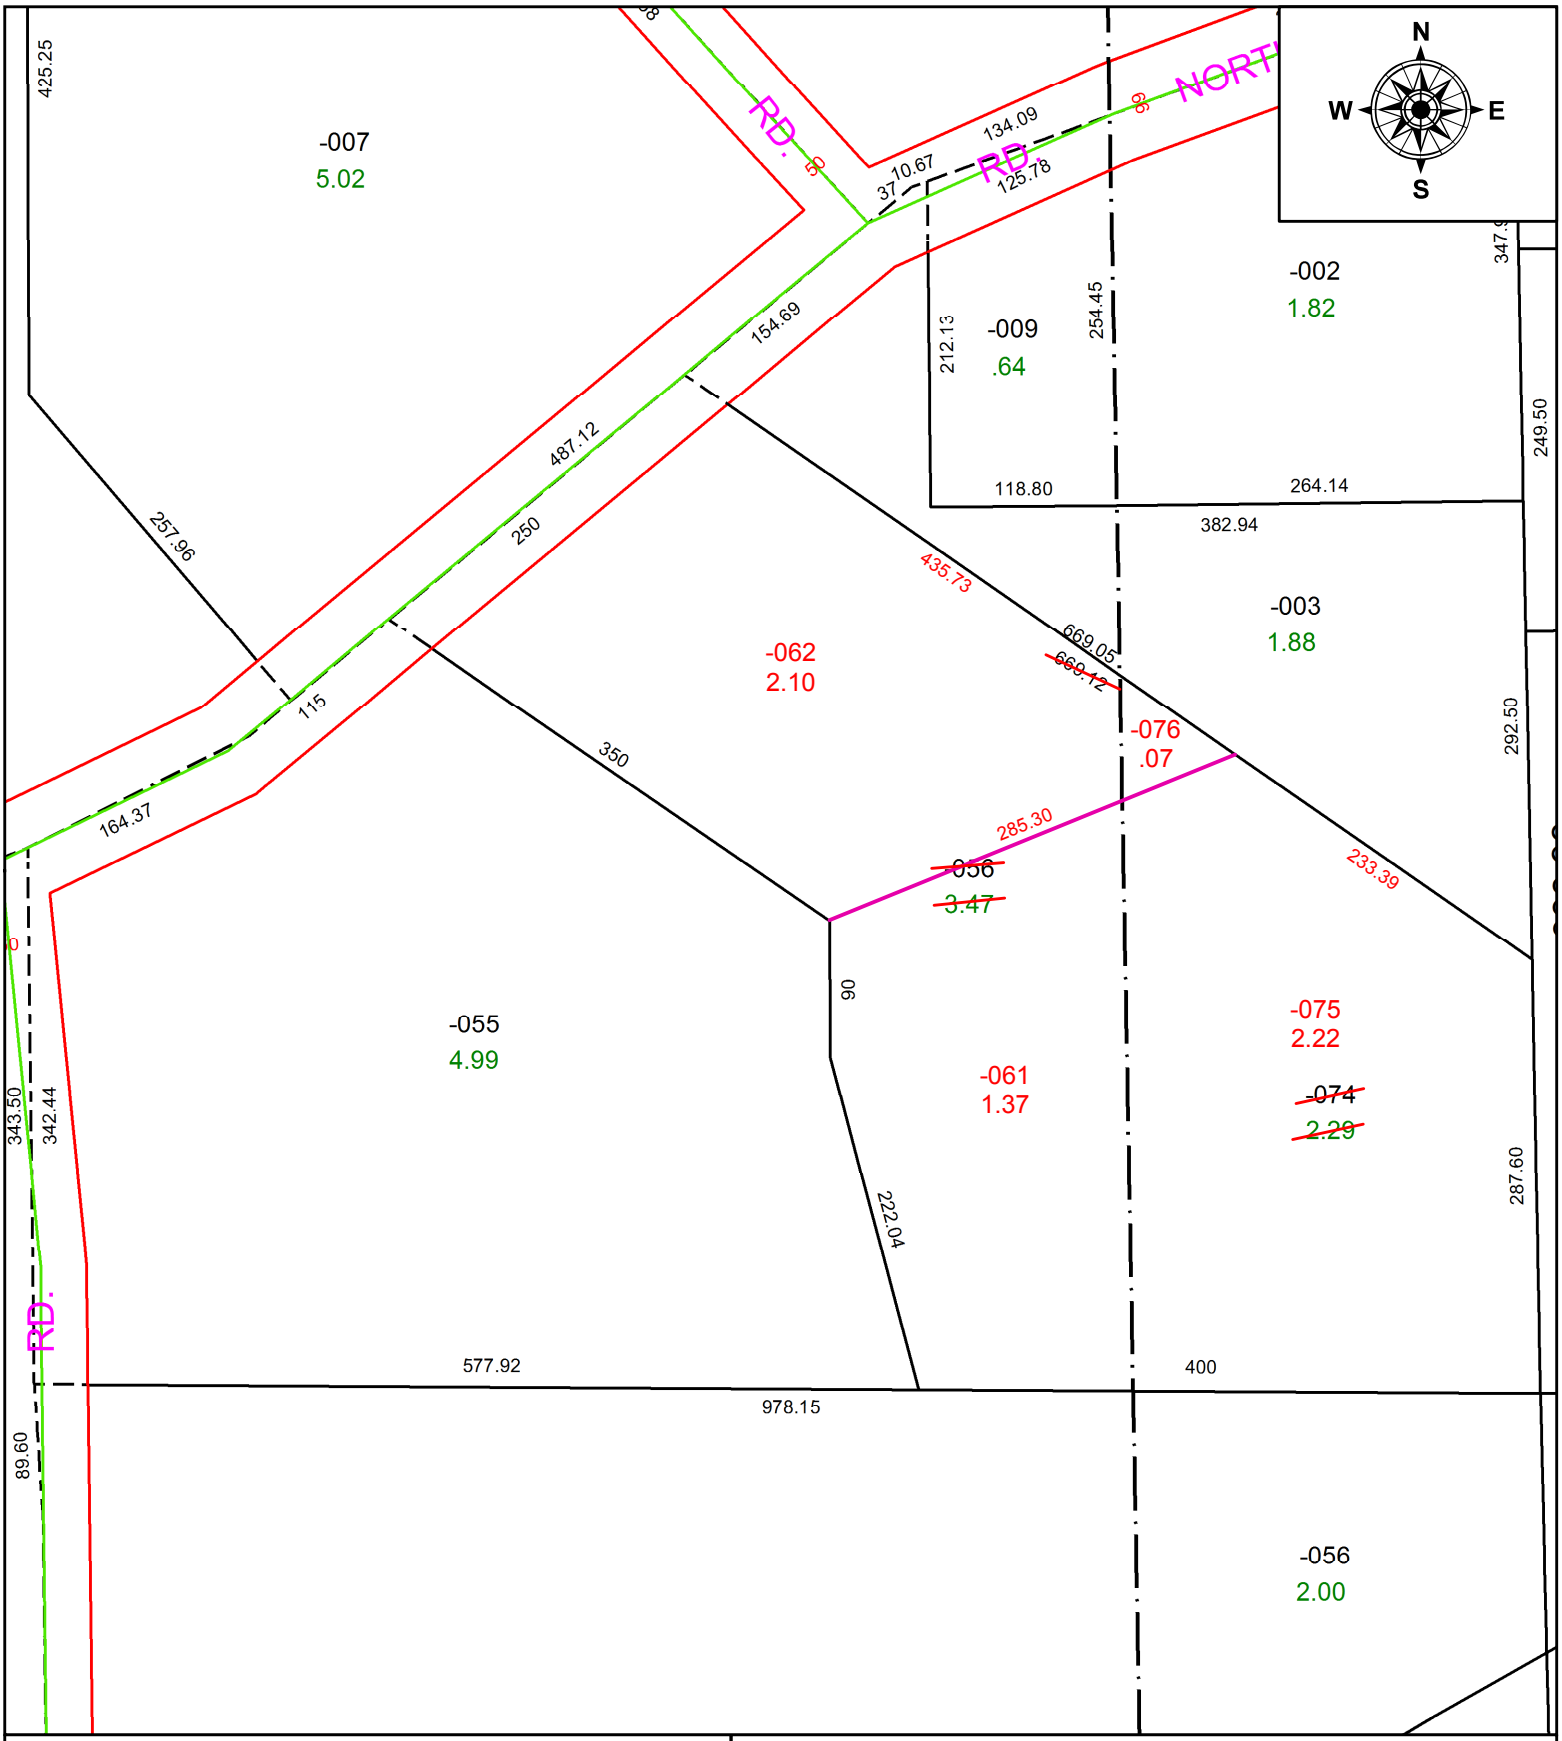

SPLITS/DEEDS PROCESSED

LORAIN COUNTY TAX MAP DEPARTMENT
226 MIDDLE AVE. ELYRIA, OH

SURVEYED BY: THOMAS A. SIMON
CLOSURE: 1: 519,809
MAP PAGE(S): 1-00-043
APPOVED BY: RRM **DATE:** 2-11-21
SCALE: 1" = 125 **PRIOR INSTRUMENT:** 20200784894