PARENT PARCEL: 06-23-009-101-033

CHILD PARCEL:

STARTING POINT: INTERSECTION OF C/L OF DEBRA DR. AND C/L OF LAKE AVE.

20-04263-A

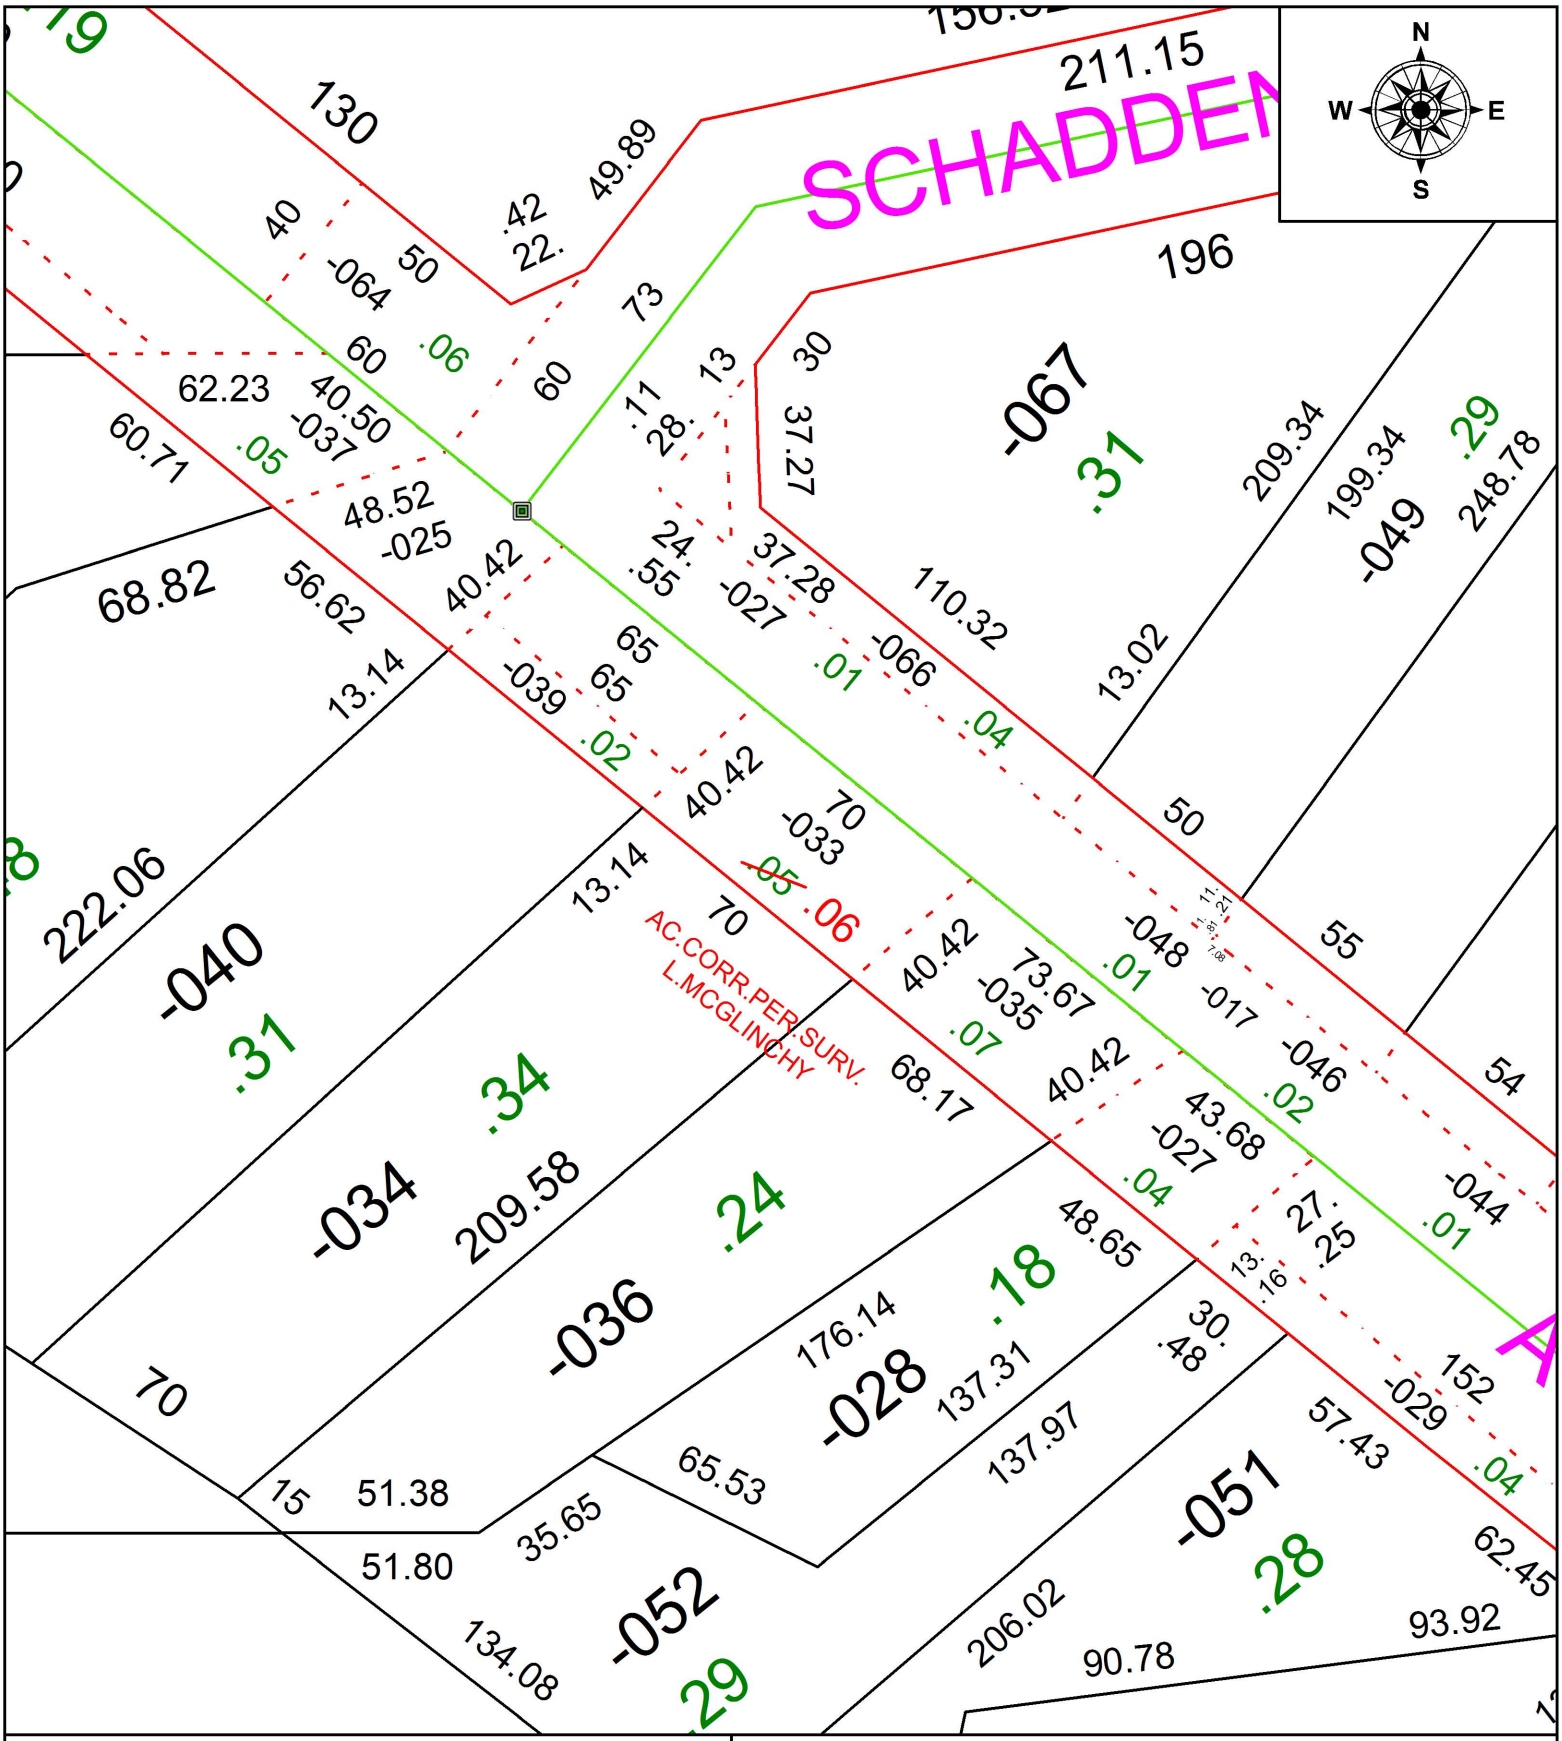

SPLITS/DEEDS PROCESSED

LORAIN COUNTY TAX MAP DEPARTMENT
226 MIDDLE AVE. ELYRIA, OH

SURVEYED BY: LAWRENCE V. MCGLINCHY
CLOSURE: 1:2147483648
MAP PAGE(S): 6-23-009
APPOVED BY: RRM **DATE:** 1-31-20
SCALE: 1" = 50 **PRIOR INSTRUMENT:** DV 1266/320