PARENT PARCEL: 19-02-059-000-024

CHILD PARCEL:

STARTING POINT: SOUTHWEST CORNER OF LAND CONVEYED TO ROBERT E. & JILL M. TOTH (199805758627)

20-04264-A

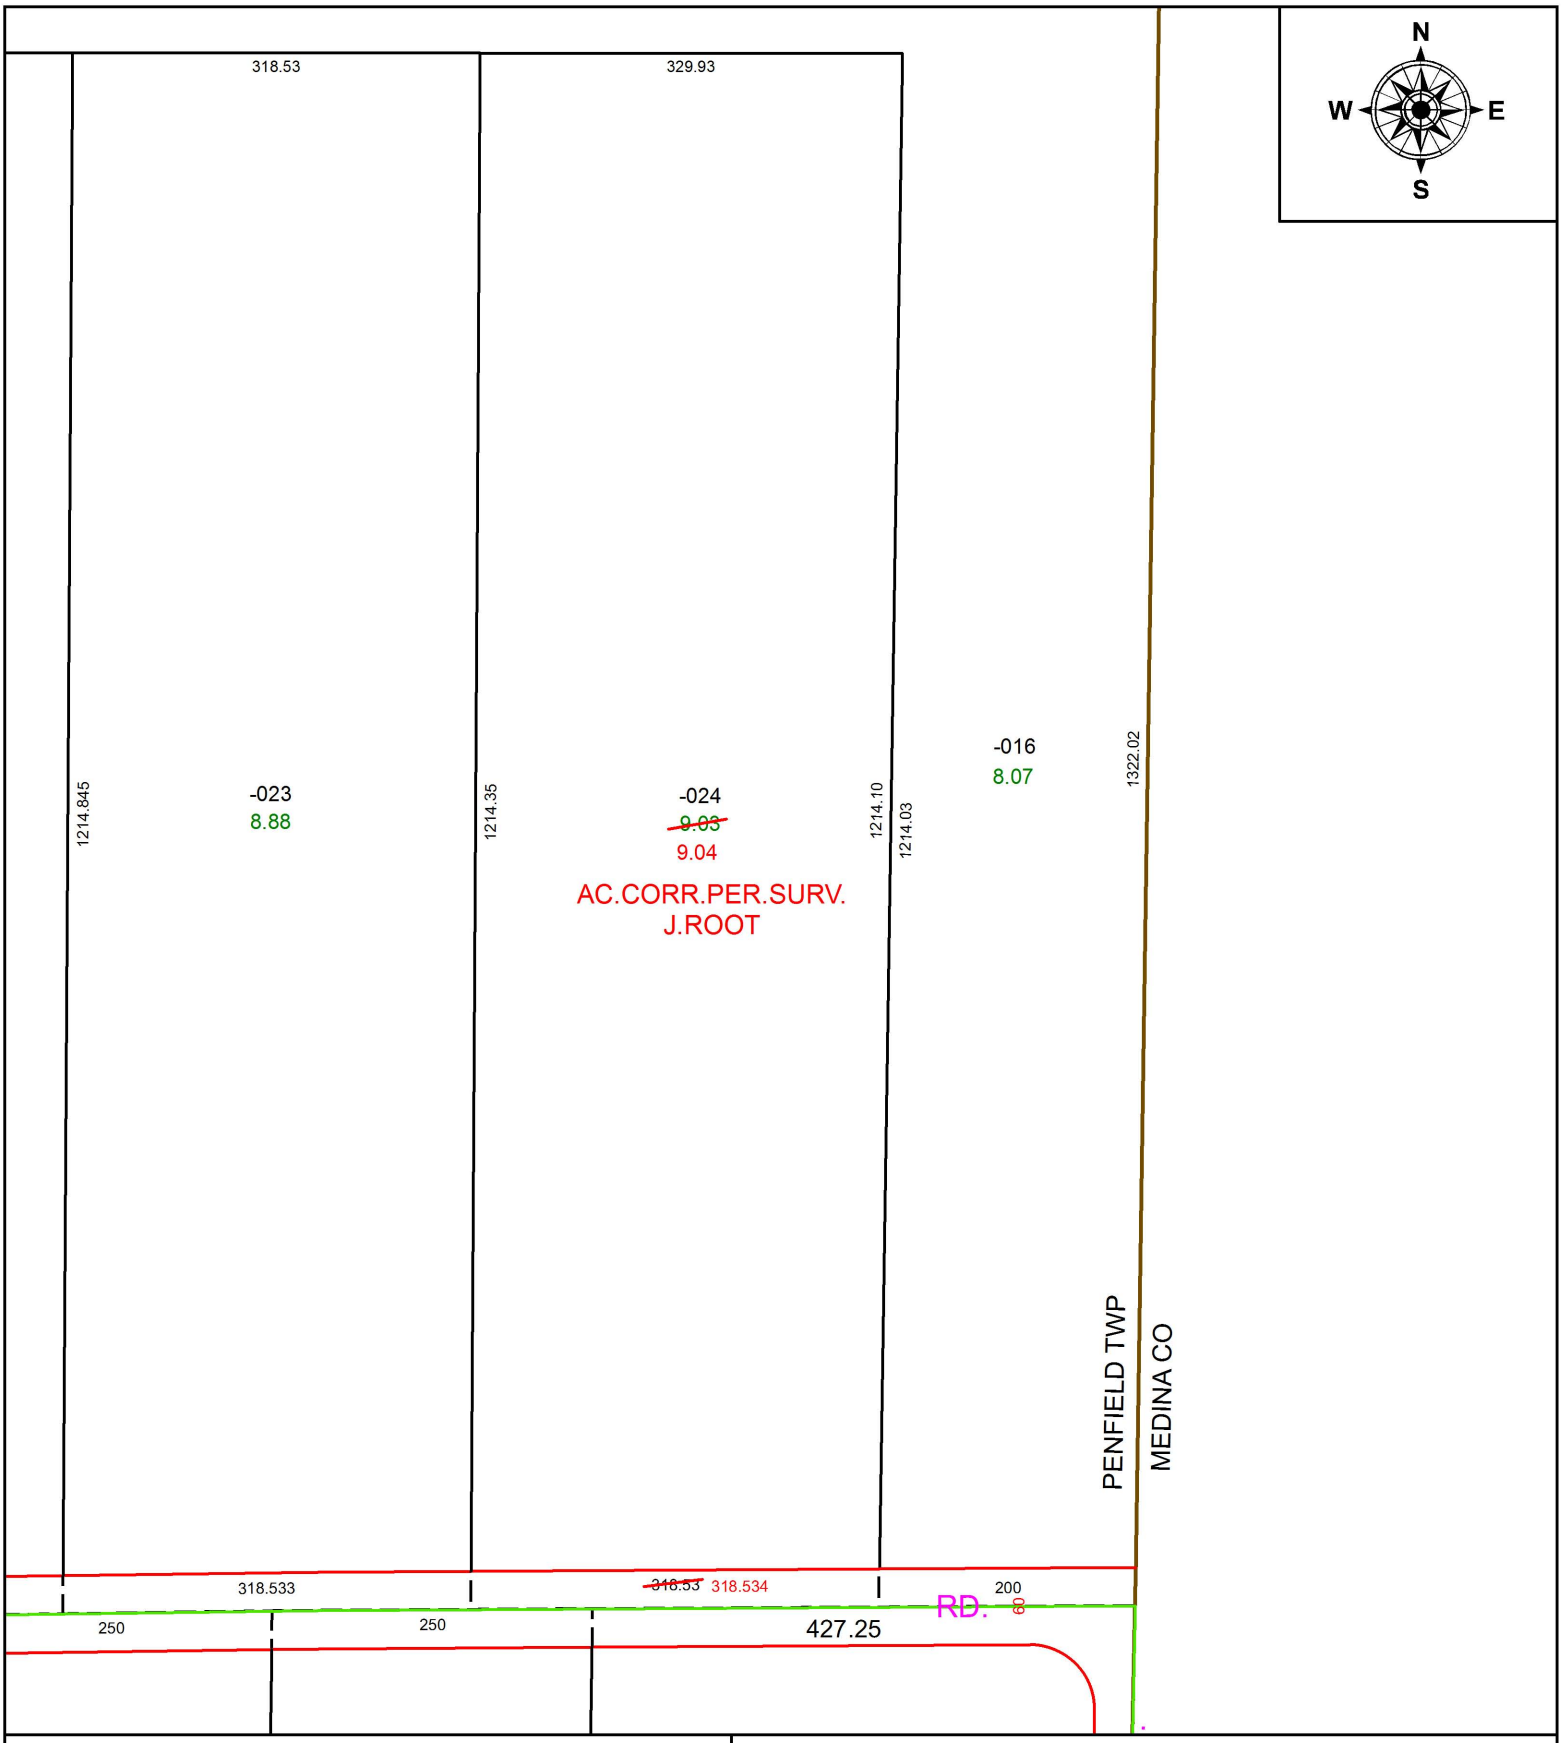

SPLITS/DEEDS PROCESSED

LORAIN COUNTY TAX MAP DEPARTMENT
226 MIDDLE AVE. ELYRIA, OH

SURVEYED BY: JAMES B. ROOT
CLOSURE: 1:308,000
MAP PAGE(S): 19-02-059
APPOVED BY: RRM **DATE:** 1-31-20
SCALE: 1" = 150 **PRIOR INSTRUMENT:** 20170645111