PARENT PARCEL: 19-01-024-000-002, 19-01-025-000-001

CHILD PARCEL: 19-01-024-000-019, -020, 19-01-025-000-001

STARTING POINT: INTERSECTION OF C/L OF S.R.301 AND C/L OF SMITH RD.

21-04268

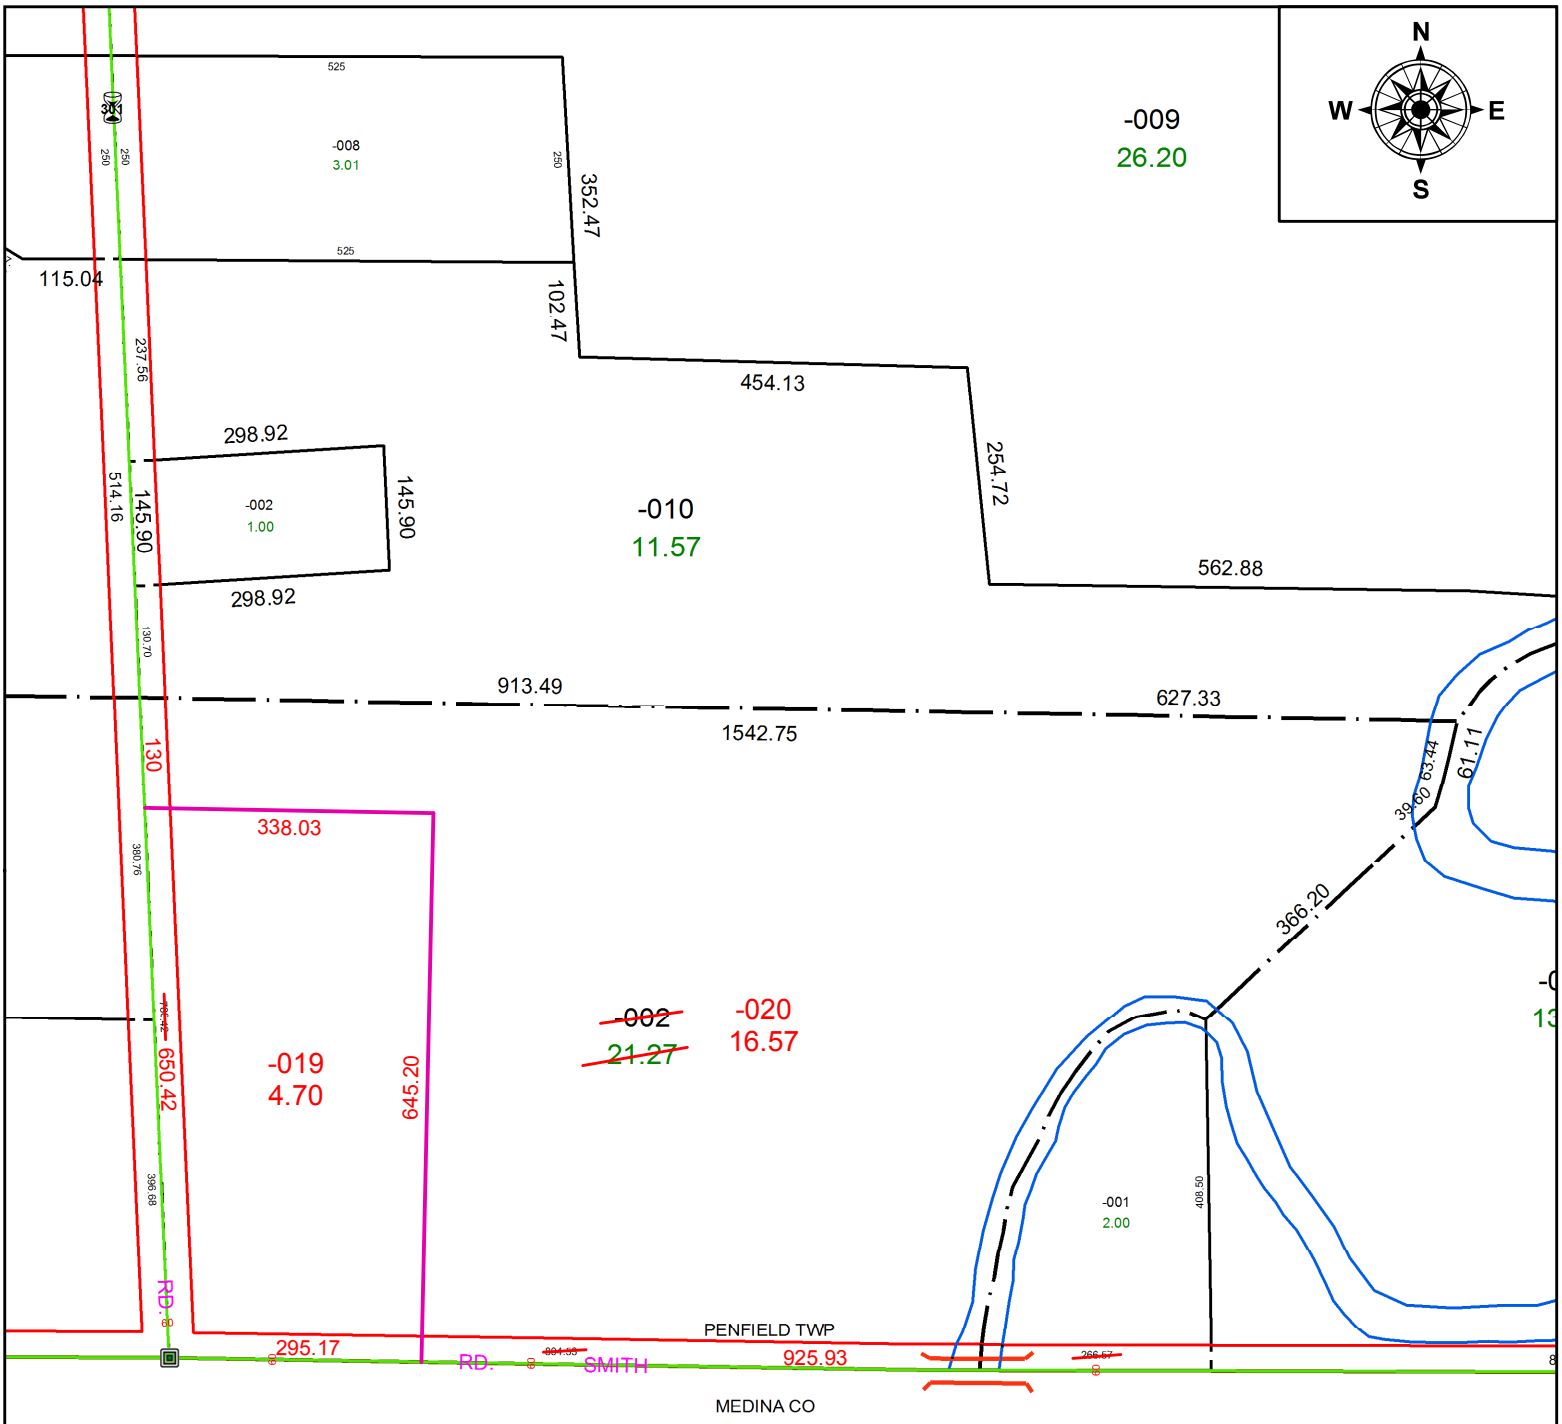

SPLITS/DEEDS PROCESSED

LORAIN COUNTY TAX MAP DEPARTMENT
226 MIDDLE AVE. ELYRIA, OH

SURVEYED BY: THOMAS A. SIMON
CLOSURE: 1: 937,231
MAP PAGE(S): 19-01-024
APPOVED BY: RRM **DATE:** 3-9-21
SCALE: 1" = 225 **PRIOR INSTRUMENT:** 20200760313