PARENT PARCEL: 04-00-029-116-109
CHILD PARCEL: 04-00-029-116-111, -112
STARTING POINT: INTERSECTION OF C/L OF WOODBRIDGE WAY AND C/L OF WINNERS CIR.

21-04270

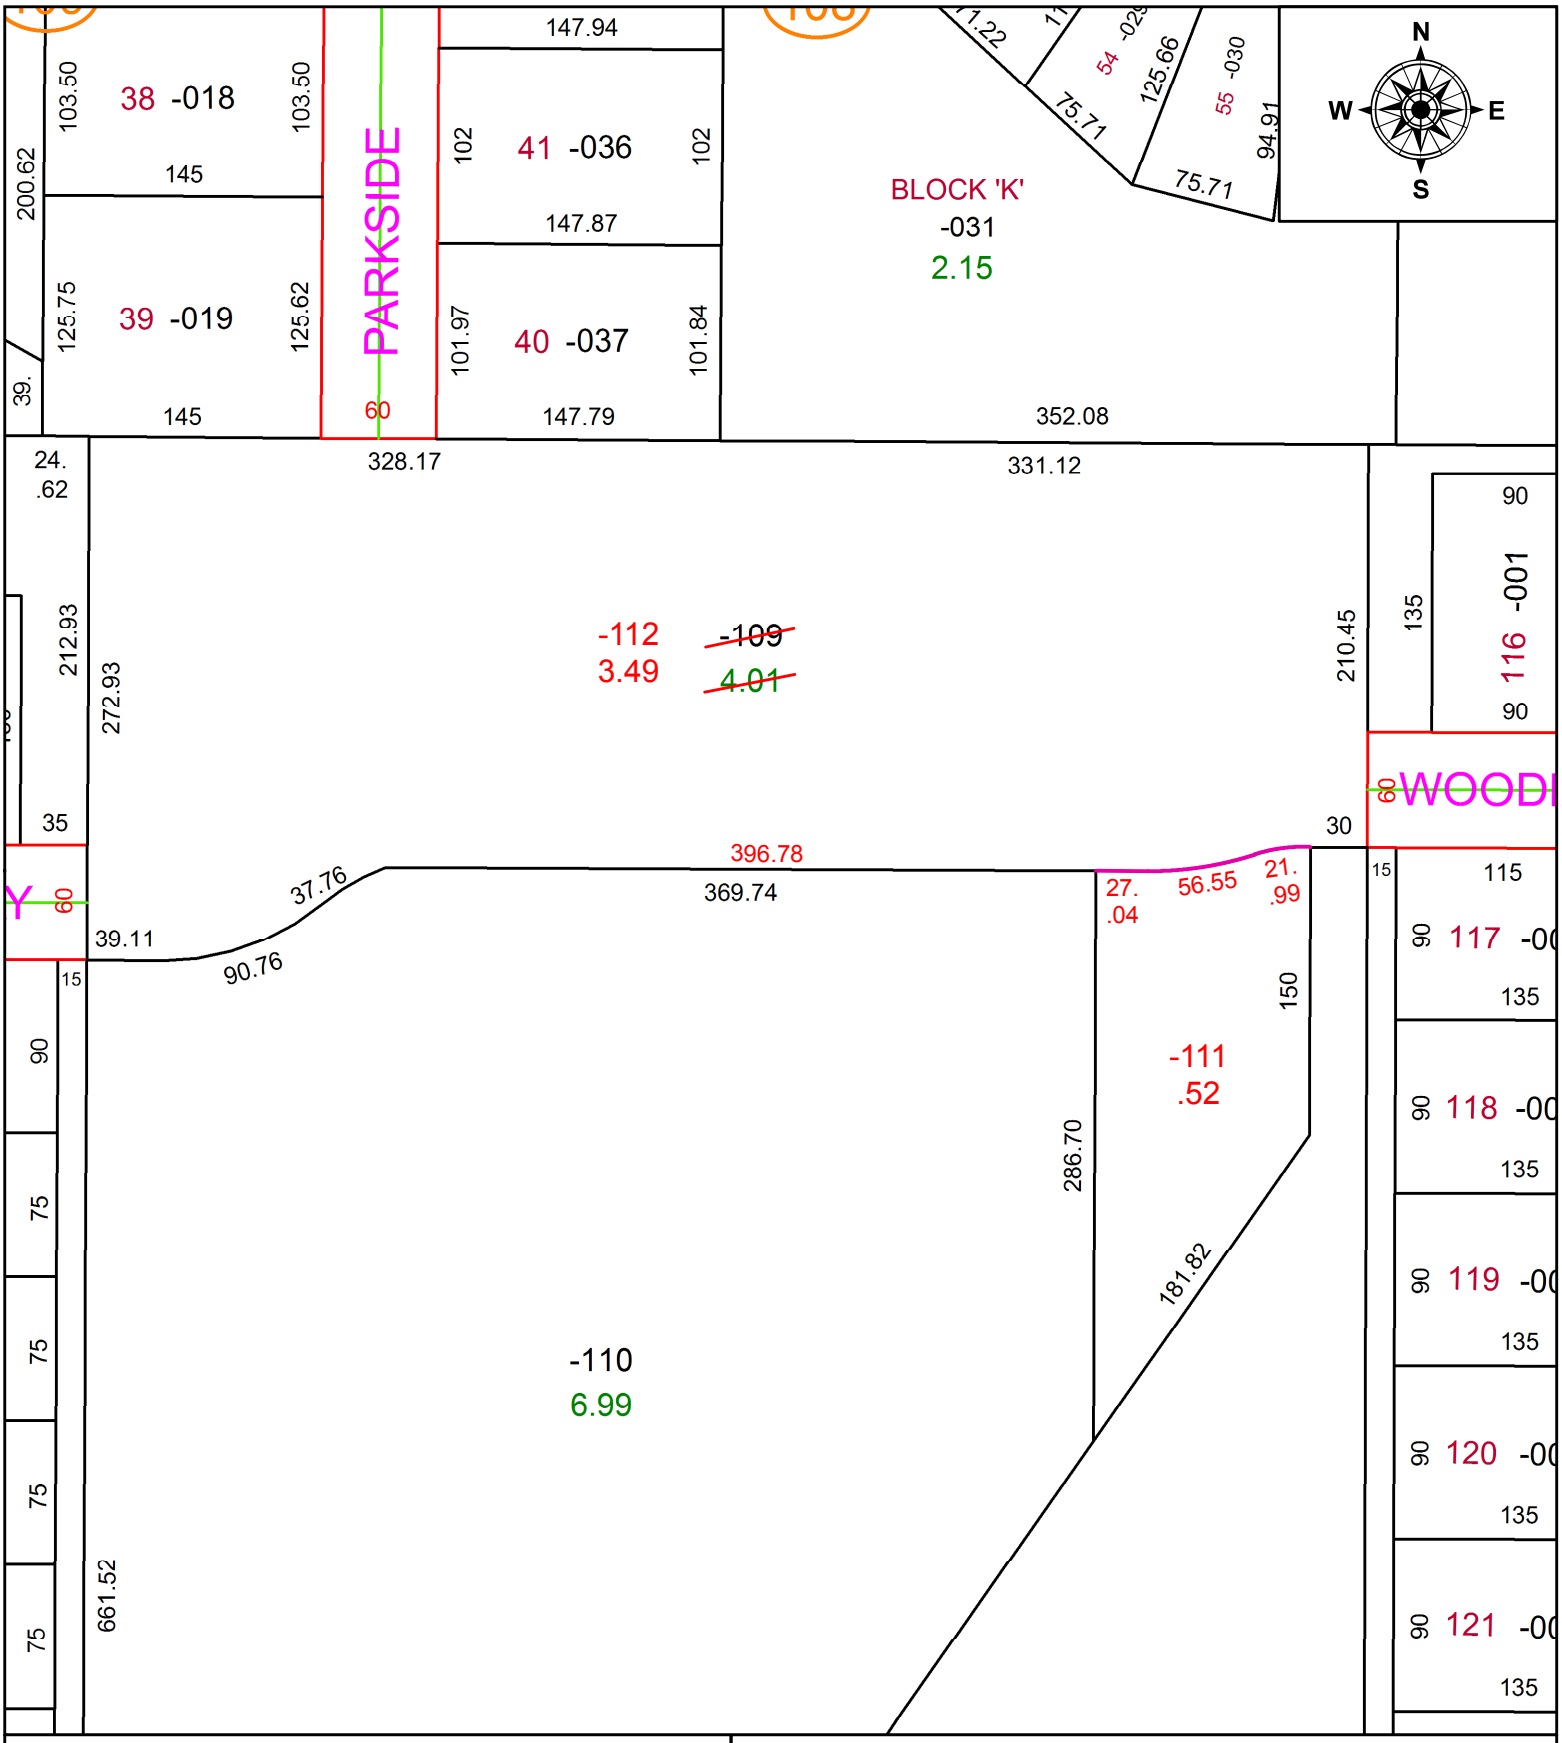

SPLITS/DEEDS PROCESSED
LORAIN COUNTY TAX MAP DEPARTMENT
226 MIDDLE AVE. ELYRIA, OH

SURVEYED BY: JAMES T. SAYLER
CLOSURE: 1:76,138
MAP PAGE(S): 4-00-029
APPOVED BY: RRM **DATE:** 3-11-21
SCALE: 1" = 100 **PRIOR INSTRUMENT:** 20210802531