PARENT PARCEL: 18-00-010-000-023

CHILD PARCEL:

STARTING POINT: INTERSECTION OF C/L OF S.R. 18 AND C/L OF HAWLEY RD.

20-04272-A

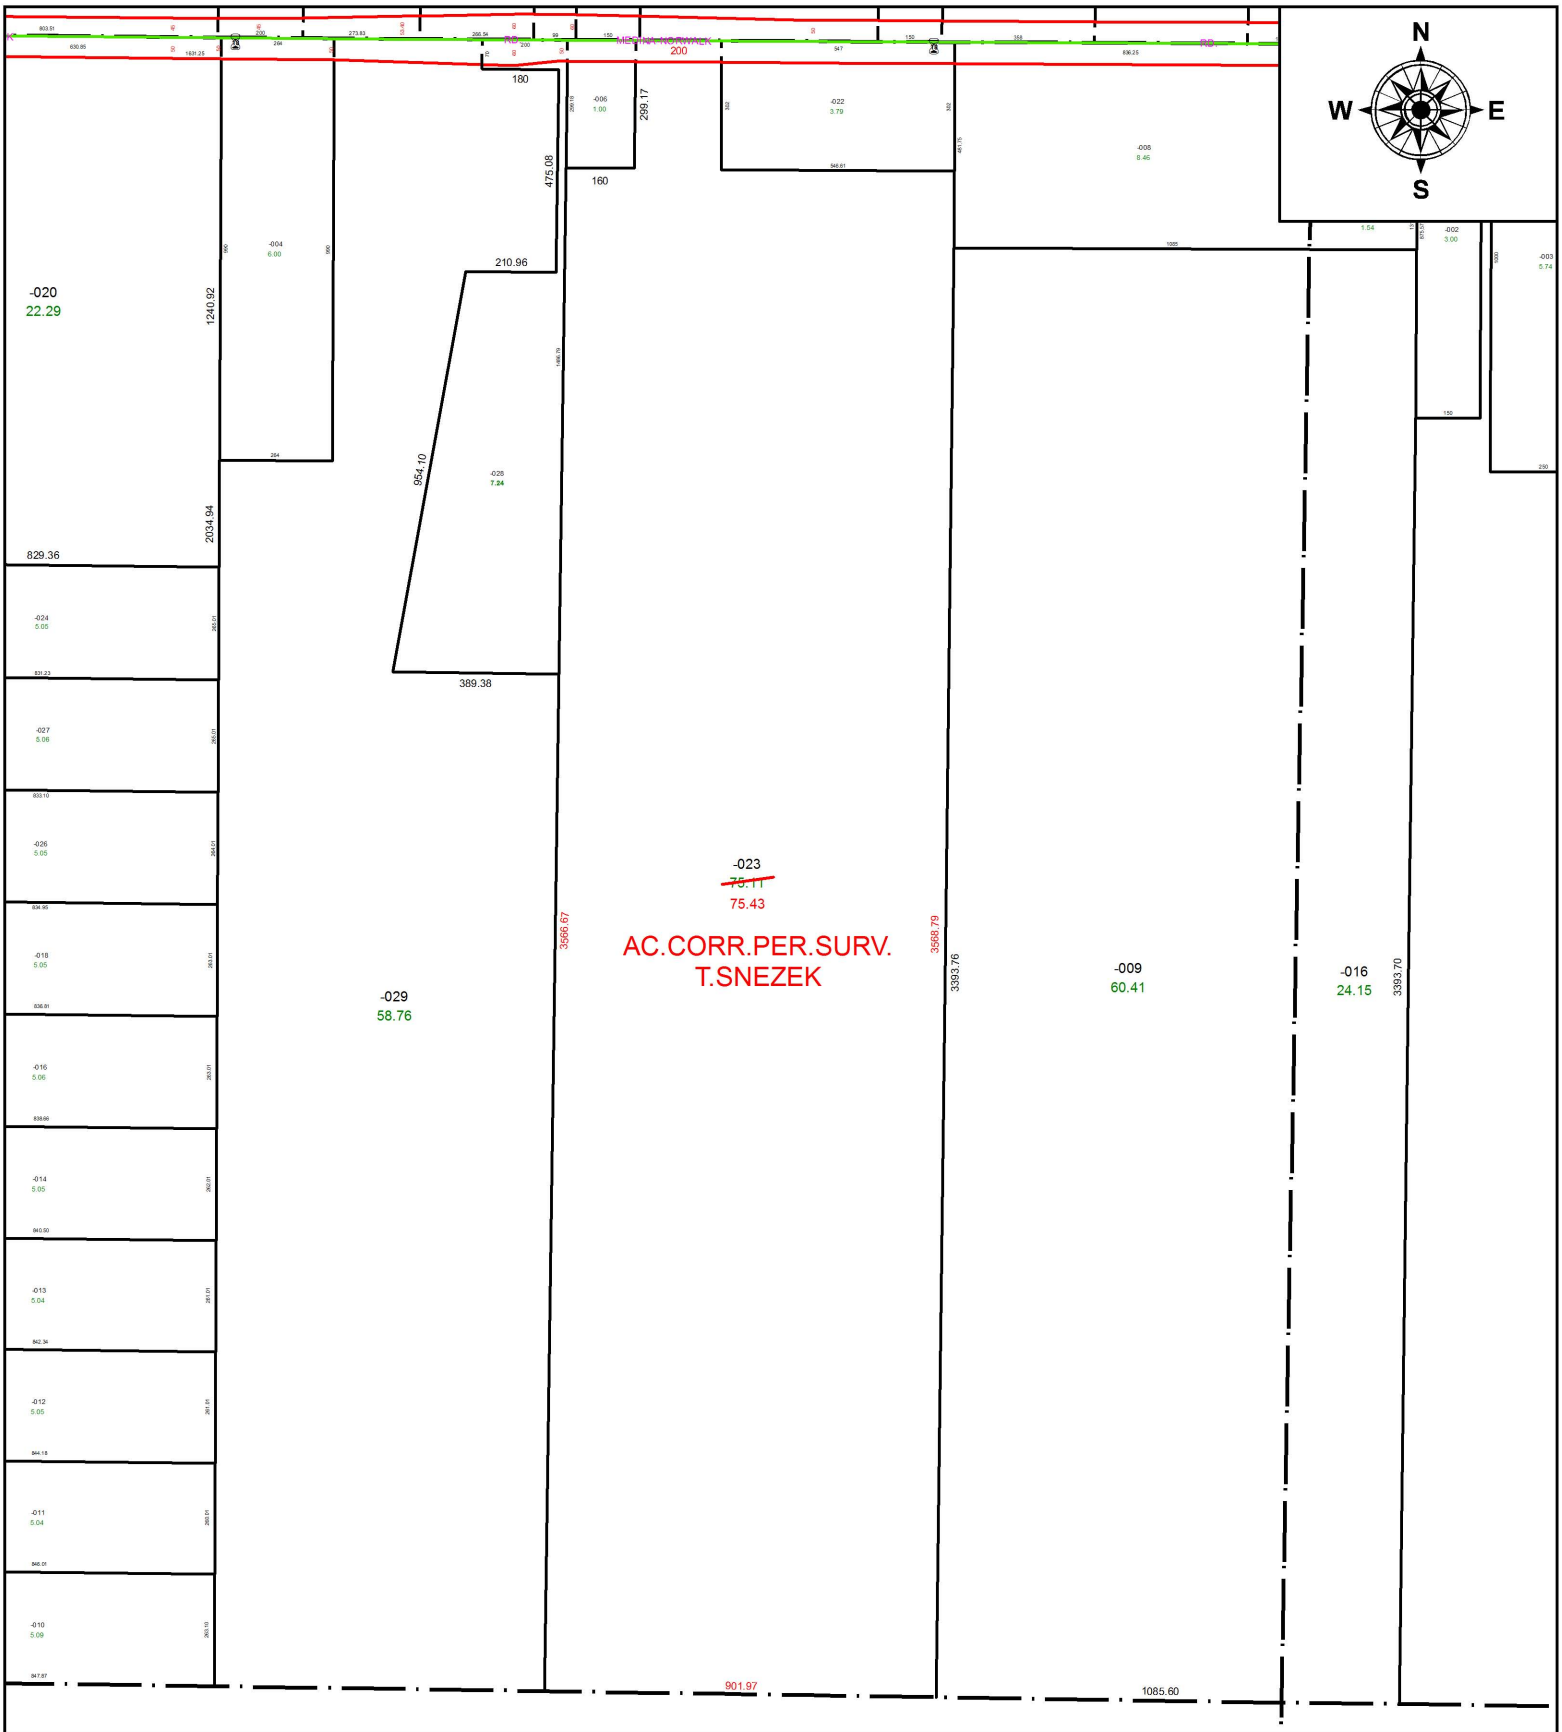

SPLITS/DEEDS PROCESSED

LORAIN COUNTY TAX MAP DEPARTMENT
226 MIDDLE AVE. ELYRIA, OH

SURVEYED BY: THOMAS M. SNEZEK
CLOSURE: 1:3,142,390
MAP PAGE(S): 18-00-010
APPOVED BY: RRM **DATE:** 2-3-20
SCALE: 1" = 450 **PRIOR INSTRUMENT:** 20170654719