PARENT PARCEL: 05-00-065-000-009, -011

CHILD PARCEL: 05-00-065-000-044 THRU -046, 05-00-066-000-020, -021

STARTING POINT: INTERSECTION OF C/L OF OBERLIN RD. AND C/L OF OHIO TURNPIKE

21-04272

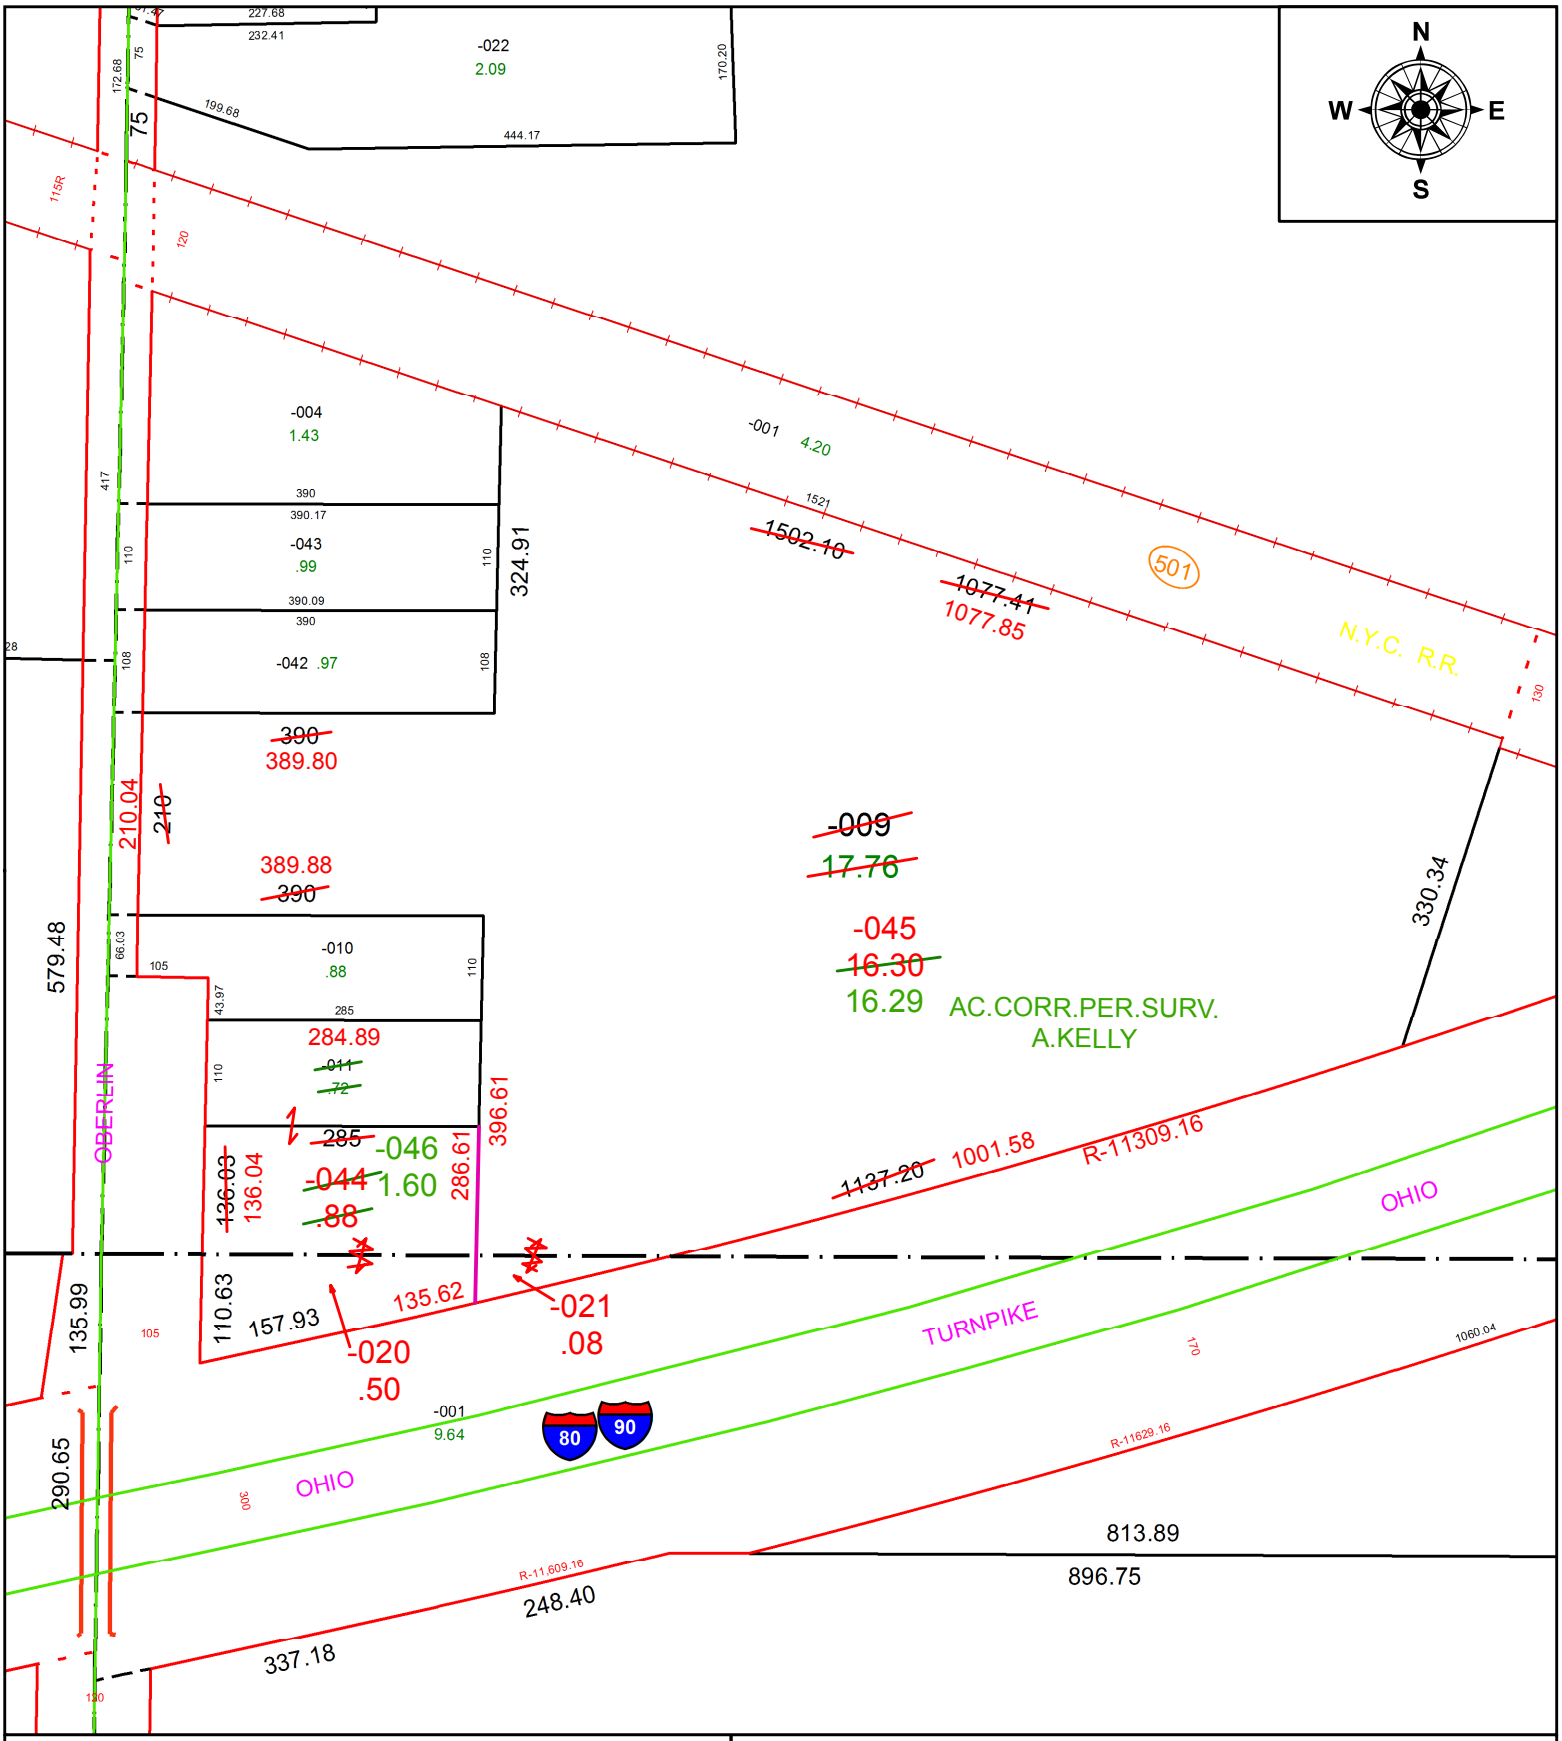

SPLITS/DEEDS PROCESSED

LORAIN COUNTY TAX MAP DEPARTMENT
226 MIDDLE AVE. ELYRIA, OH

SURVEYED BY: AMY M. KELLY
CLOSURE: 1: 167,439
MAP PAGE(S): 5-00-065
APPOVED BY: RRM **DATE:** 3-17-21
SCALE: 1" = 200 **PRIOR INSTRUMENT:** 20140495727