PARENT PARCEL: 07-00-018-101-247

CHILD PARCEL:

STARTING POINT: INTERSECTION OF C/L OF MILLS RD. AND C/L OF JAYCOX RD.

20-04273-A

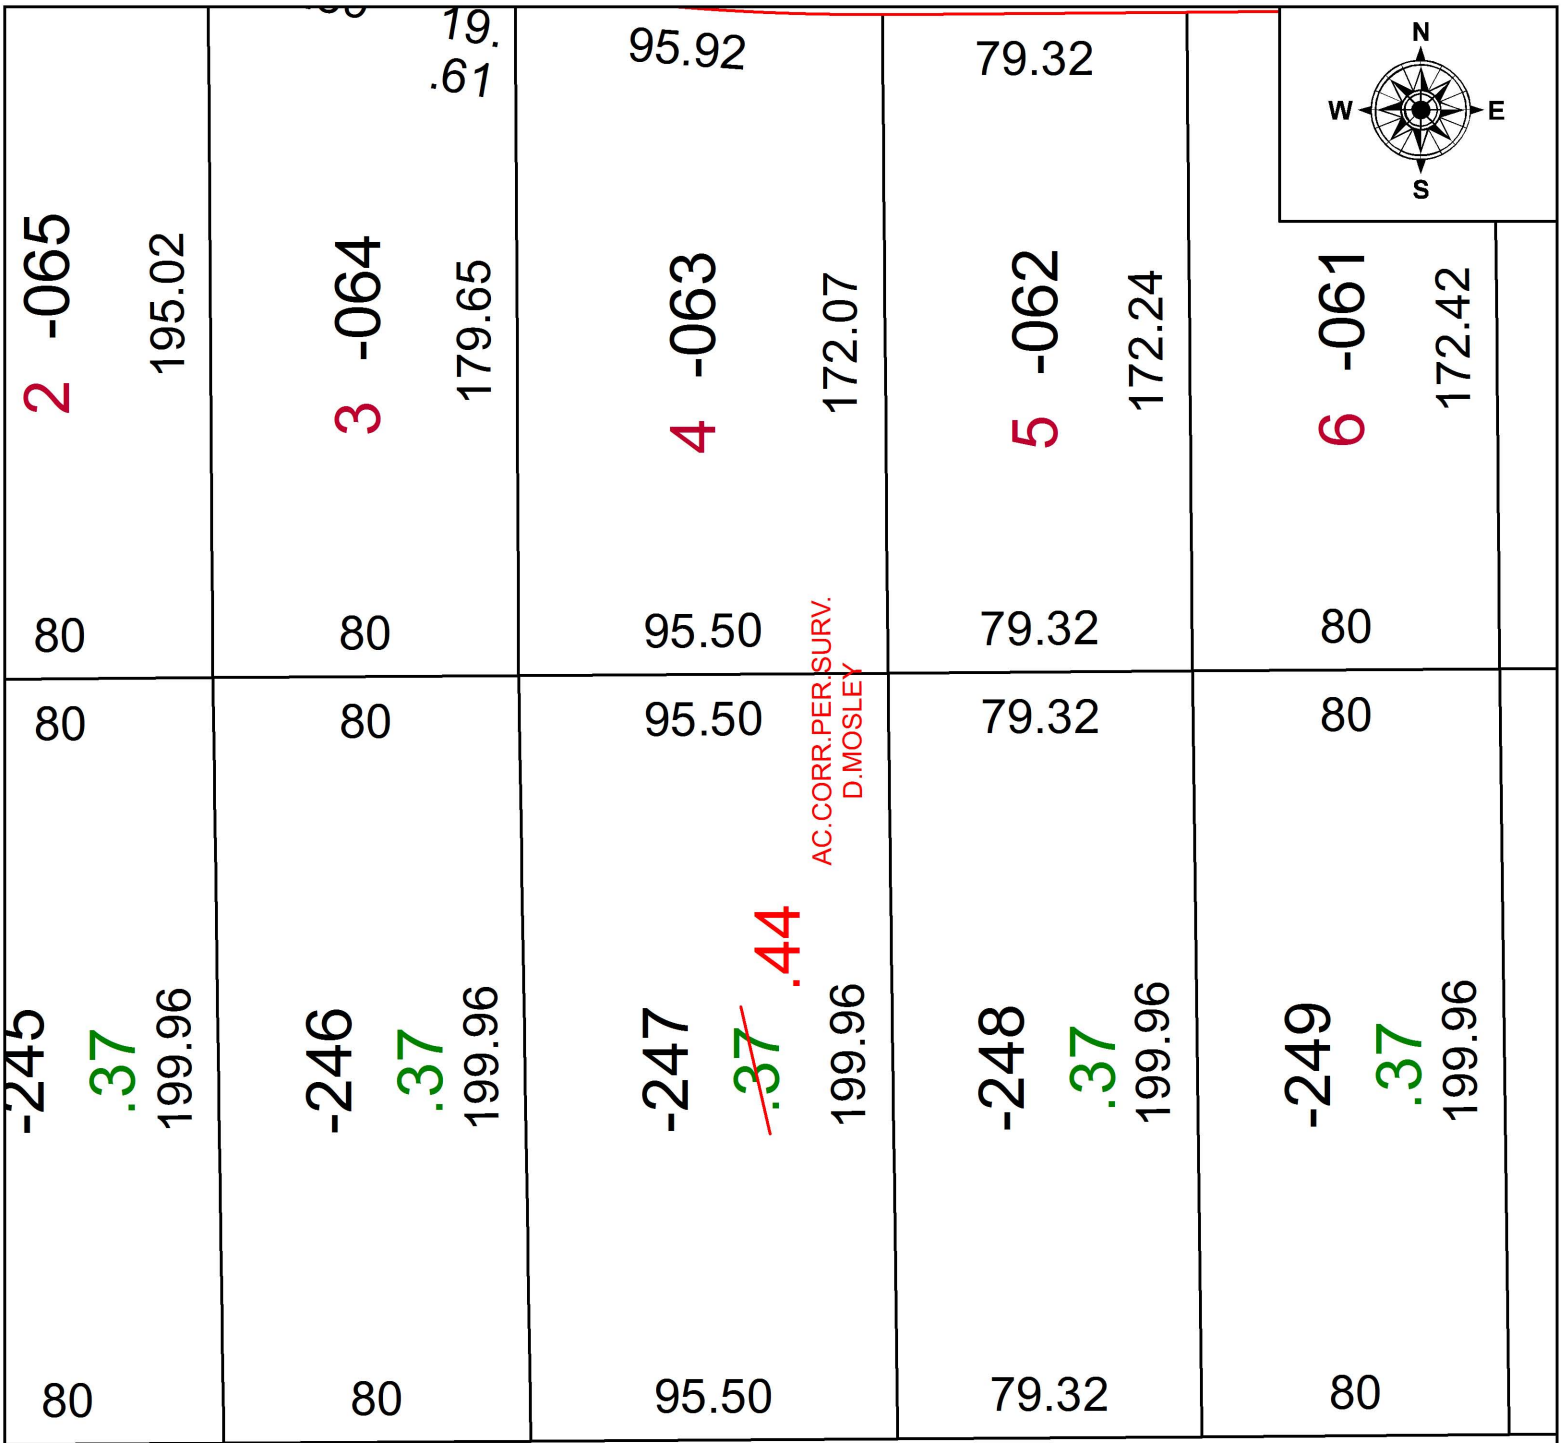

SPLITS/DEEDS PROCESSED

LORAIN COUNTY TAX MAP DEPARTMENT
226 MIDDLE AVE. ELYRIA, OH

SURVEYED BY: DOUG MOSLEY
CLOSURE: 1:2147483648
MAP PAGE(S): 7-00-018
APPOVED BY: RRM **DATE:** 2-3-20
SCALE: 1" = 50 **PRIOR INSTRUMENT:** 20180662318