PARENT PARCEL: 04-00-001-103-013, -065, -069

CHILD PARCEL: 04-00-001-103-321, -322

STARTING POINT: INTERSECTION OF C/L OF ARLINGTON DR. AND C/L OF CASE RD.

21-04275

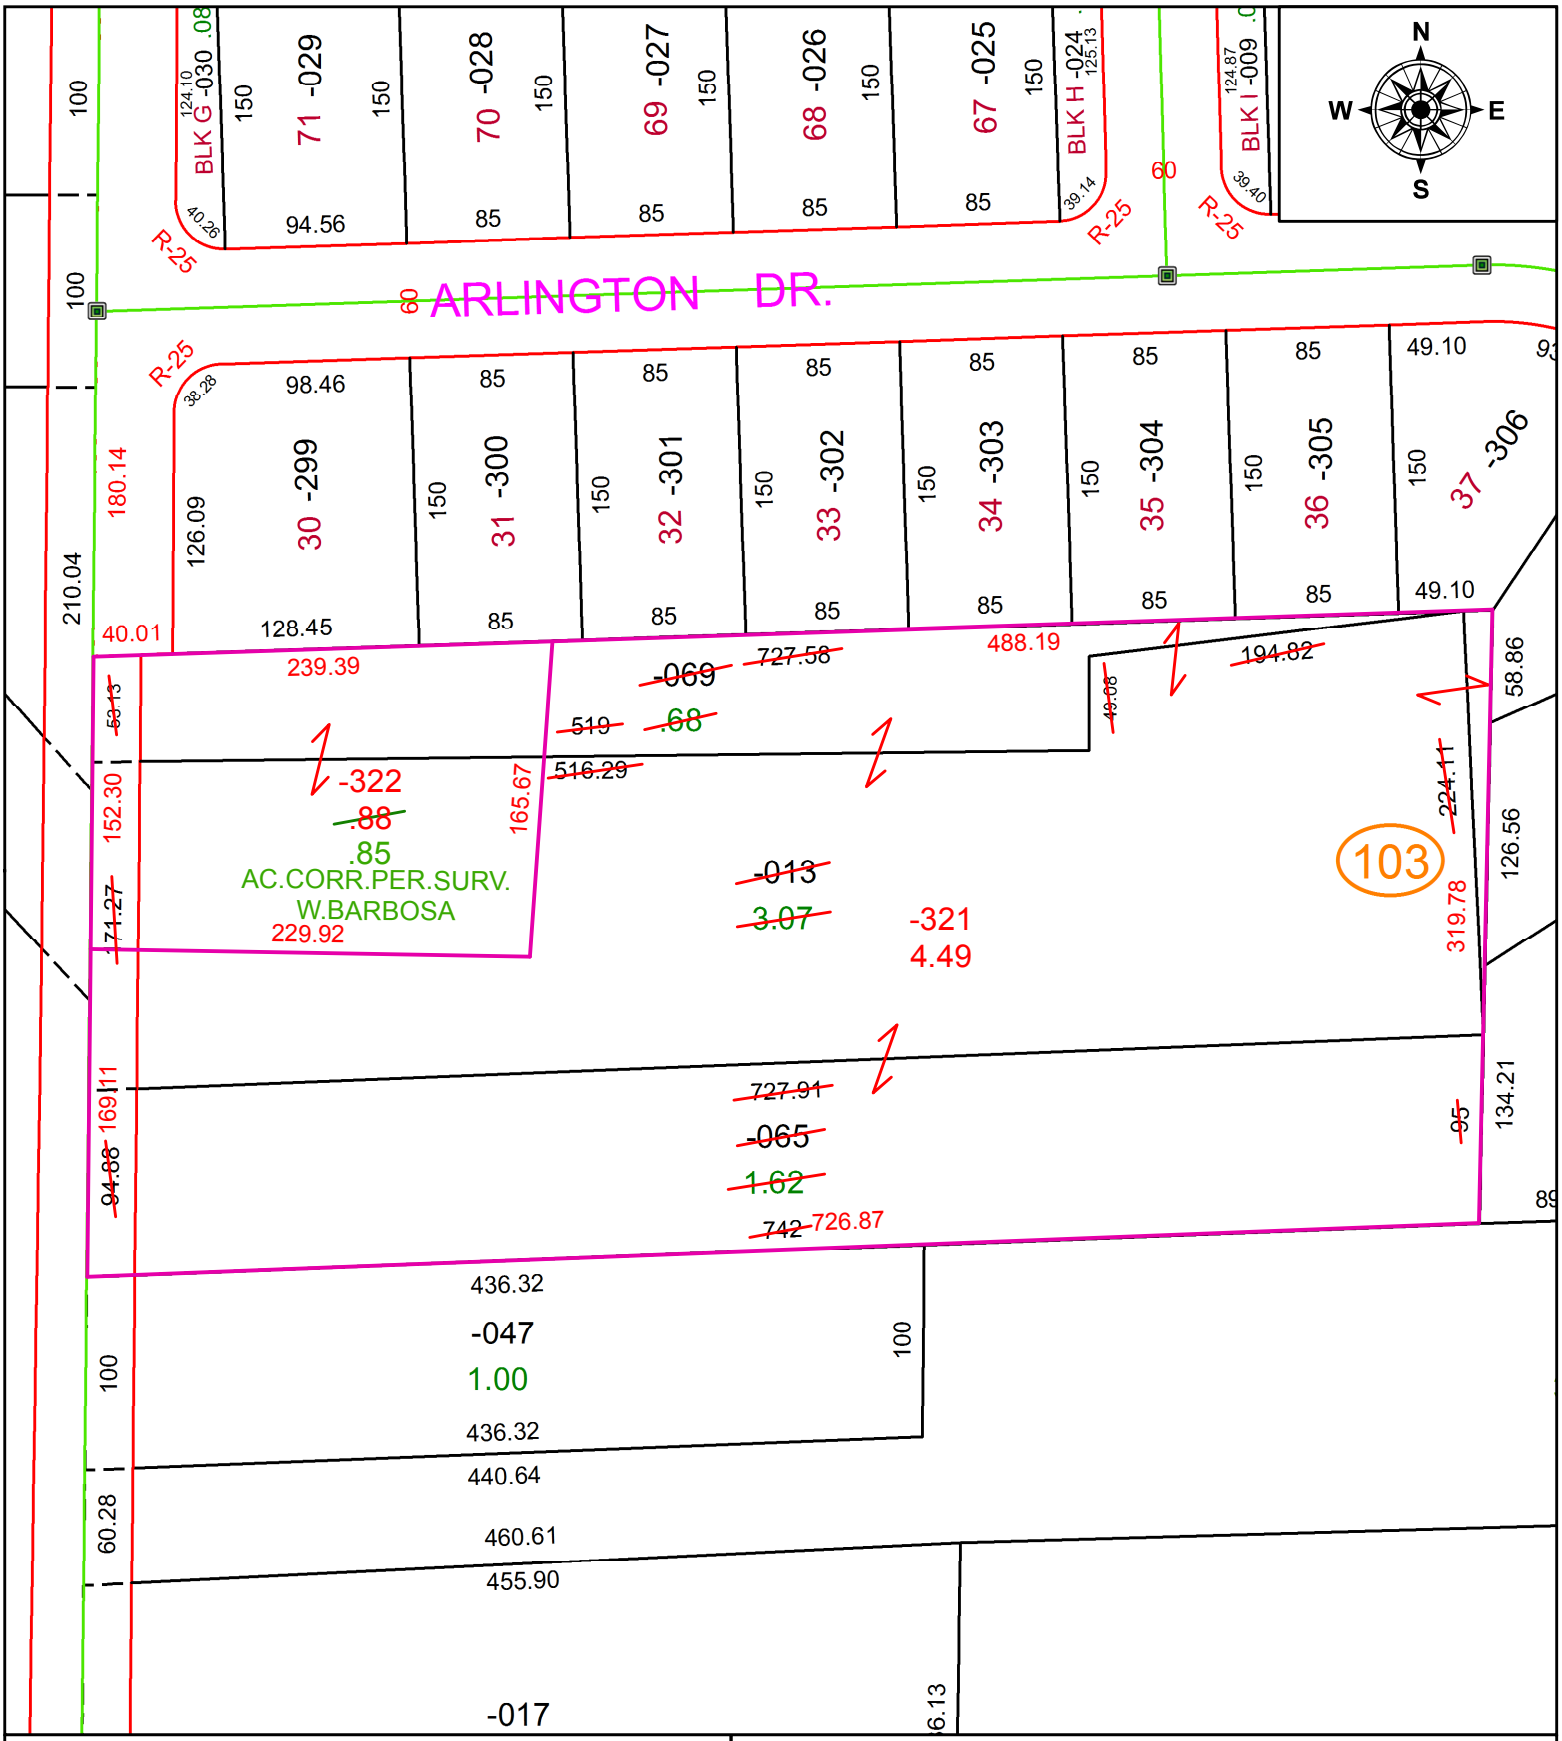

SPLITS/DEEDS PROCESSED

LORAIN COUNTY TAX MAP DEPARTMENT
226 MIDDLE AVE. ELYRIA, OH

SURVEYED BY: WILFREDO BARBOSA
CLOSURE: 1:338,429
MAP PAGE(S): 4-00-001
APPOVED BY: RRM **DATE:** 3-23-21
SCALE: 1" = 100 **PRIOR INSTRUMENT:** 20090297934